An Bord Pleanála Oral Hearing

Irish Water

**Greater Dublin Drainage** 

**Response to Inspector's Questions** 

Biodiversity (Marine & Terrestrial Ornithology) – Simon Zisman

# **Biodiversity (Marine & Terrestrial Ornithology)**

## Bird Survey Raw Data – Terrestrial

The following Appendices provide the raw terrestrial bird data collected for the Greater Dublin Drainage Project. The data should be considered in conjunction with EIAR Chapter 11, which provides supplementary information on survey method and other background information.

A key to help interpret the data is also provided, extracted from Bibby et al<sup>1</sup>. (2000) (see Appendix 1).

The terrestrial bird data were collected between January 2015 and November 2017, and comprise:

- Winter surveys (for late winter 2014/15, early winter 2015/2016, late winter 2016/2017 and early winter 2017/2018); and
- Summer surveys (for 2015 and 2017).

The data is provided in the following format:

- Appendix 1 Key from Bibby et al (2000);
- Appendix 2 Winter 2015 (January and February);
- Appendix 3 Winter 2015 (November);
- Appendix 4 Winter 2017 (March);
- Appendix 5 Winter 2017 (November);
- Appendix 6 Summer 2015 (April and June); and
- Appendix 7 Summer 2017 (May and June).

<sup>&</sup>lt;sup>1</sup> Bibby, C., N. Burgess, D. Hill, and S. Mustoe (2000) Bird Census Techniques. Academic Press. Elsevier. ISBN: 9780120958313

# APPENDIX 1 KEY FROM BIBBY ET AL (2000)

The information below is taken from Bibby et al. (2000). It gives the standard notation for activity codes for birds and it provides the standard two-letter codes that are for recording birds and their behaviour.

# **BTO SPECIES CODES**

AC	Arctic Skua	GA	Godwol	LE	Long-eared Owl	MZ	Sand Martin
AE	Arctic Tern	GX	Gonnel	σ	Long-korled Til	\$\$	Sandering
AV .	Avacet	GW	Gorden Worbler	MG	Magple	ΤE	Sandwich Tern
BO	Born Owl	ĠY	Garganey	MA	Wallard	γı	Saw's Warble
BY	Bornocle Goose	GĆ	Goldenest	MN	Manalarin Duck	SQ	Scarlet Rosefinch
B,A	Bortailed Godwit	EA	Golden Eagle	MAX .	Monx Shearwater	SP	Seaup
BR	Bearded Te	QL I	Golden Orinke	AAR	Marsh Harrier	CY	Scottish Crossbill
BS	Berwick's Swan	ĢF	Golden Pheasant	MT	Marsh Tit	SW	Sedge Worbler
B4	Biltern	Ģ₽	Golden Plover	MW	Morsh Worbler	NS	Serin
B≪	Block Groupe	GN	Goldeneye	MP	Mepdow Pipit	5A	Shog
TY	Block Guillemot	ĠO -	Goldinch	MU	Mediterranean Gul	SU	Shelduck
BX	Block Redstort	GD	Goosander	ML	Merlin	SX	Shorelarti
Bj	Block Tern	GI	Gashawk	M.	Mistle Thrush	SE	Short-eared Owl
В.	Blockbird	GH	Grosshopper Worbler	MO	Monlogy's Hower	ŝŶ	Shoveler
			Great Black-bodied Gull	MH	Moorhen	SK	Siskin
₿⊂	Blockcop	GB					
βH	Block-headed Gull	GG	Great Crested Grebe	MS	Mule Swon	S.	Skylaik
BN	Block-necked Grebe	ND	Gragt Northern Diver	N.	Nightingola	SZ.	Skovanian Grabe
BW	Block-toiled Godwil	NX	Great Skua	NU	Nighljor	5N	Snipe
BV	Black-throared Diver	GS	Great Spotted Woodpecker	NH	Nuihaich	548	Snow Bunting
BT	Blues Tit	GT	Great Tri	OP	Osprey	5T	Song Thrush
BU	Bluethroot	GE	Green Sondpiper	OC	Oyslercalcher	SH	Sparrowhawk
BL	Brombling	Ġ.	Green Woodpecker	PX	Peofowl/Pagcock	AK	Sporred Cricke
8G	Brent Goose	GR	Greenfinch	PE	Peregrine	SF	Spotled Flycolchee
BF	Bullfinch	GK	Greenshonk	РН	Pheasoni	DR	Spotted Redshank
BZ	Buzzard	H.	Gray Heron	PF	Pied Hycoscher	SG	Storling
čG	Conada Gaose	P	Gray Partridge	PW	Pied Wogtail	\$D	Stock Dove
CP	Copercollie	GV	Grey Ployer	PG	Pink-footed Goose	SC	Stonechot
č.	Carrion Crow	GL	Grey Wagrail	PT	Pintgil	IN	Stone-curlew
CW.	Calli's Worbler	GJ	Greylog Goose	PO	Pachard	TM	Storm Peirel
	Chaffinch	GU	Guillemot	PM		51	Swollow
ĆH					Ploimigon		
ĊĊ	Chiffchoff	FW	Guinealowl (Helmeted)	PU	Puffin	SI	Swift
ĊF	Chough	HF	Hawlinch	PS	Purple Sondpiper	ю	Towny Cwl
CL		HH	Hen Hamier	Q.	Quoil	Г	Teal
CT	Ççal Til	HG	Herring Gull	RN	Raven	ΤK	Terrminck's Stint
CD	Collared Dove	HY	Неффу	RA.	Razarbill	ΤP	Tree Pipit
GM	Common Gull	ΗZ	Honey Buzzard	RG	Red Grouse	TS	Tree Sporrow
CS	Common Sondpiper	HC	Heoded Crow	KT	Rød Kite	TC .	Treccroepor
CX –	Common Score:	HP	Ноорое	ED	Red-booked Shrike	τu	Tofted Duck
CN	Common Tern	HM	House Marlin	B/M	Red-breasted Merganser	Π	Tomstone
co	Coat	HS	House Sparrow	RGI	<b>Red-crested Pochard</b>	π	Tortle Dove
ĊA	Cormorant	JD	Jackdaw	EV	Red-fooled Falcon	TW	Twile
CB	Corn Bunting	J.	Jay	RL	Realfegged Partridge	WA.	Water Roll
ÇĘ	Compraise	К.	Kestro	NK	Red-necked Photorope	W.	Wheateor
çî	Crested Til	KF	Kingfisher	LR	Redpoll (Lesser)	WM.	Whimbrel
ČR	Crossbill (Common)	KI	Kittiwake	RK	Redshank	WC	Whinchat
CK	Cuckoo	KIN	Knol	RT	Redstort	WG	White-fronted Goose
čΰ	Curlew	LM	Lady Amherst's Pheosant	RH	Regularizated Driver	WH	Whitethraat
0W	Darifard Warble	LA	Lapland Bunning	RE	Redwing	W5	Whooper Swon
DI				RB	Read Bunting	WN	Wigeon
DO	Dipper	L.	Lapwing Leach's Petrel	RW	Read Worbler	WT	Willow Tri
	Datteral	TL					
DN	Dunlin	LB	Lesser Block-bocked Gull	RZ	Ring Ouzel	WW	Willow Warbler
D.	Dunneck	LS	Lesser Spotted Woodpecker	₽P	Ringed Plover	OD	Wood Sandpiper
₿G	Egyption Goose	ιw.	Losser Whitothroat	ŔI	Ring-necked Parakee	wo	Wood Workler
E.	Eider	u	Linnet	R.	Rabin	WK	Wardcock
FP	Feral Pigeon	εī	Little Egret	DV	Rack Dave (not feral)	WL	Woodlark
Ζl	Feral/hybrid goose	ιG	Little Grebe	RC	Rock Pipit	WP	Woodpigeon
ZF	Feral/hybrid mallard type	10	Little Gull	RQ	Rook	WR	Wren
۴F	Fieldfore	LO	Little Ovel	R5	Roseole Tern	WY.	Wryneck
FC	Fifecres	UP .	Little Renged Plover	RY	Ruday Duck	YW	Yellow Wagtail
۴	Fulinar	AF	Lille Tern	RU	Roff	Y.	Yellowhammer

If you are not submitting your data electronically using BBS-Online, please return your Field Recording Sheets to your Regional Organiser with your other BBS forms. If you would like to submit your results on BBS-Online, please inform your RO, then visit www.bto.org/bbs.

	Bild Gerbus Techniq
	AWen moving between two parotes. The solid line

indicates it was definitely the series birth.

Two Warms in songed the same time, i.e. definitely different texts. The dotted line indicates a simultaneous registration and is of very great value in separating territories.

End Gereius Techniques

Two Litinet nests occupied simultaneously and thus belonging to different pairs. This is another exemple of the value of stated lines. Only adjacent nexts need the marked in this year.

The existing indicates that the registrations definitely rater to the store bird.

A question-marked solid line indicates that the registrations probably relate to the serve skill. This convention is of particular use when the census route retains to an area already covered - it is possible to mark new prections of (probably the same) birds recorded before. without the esk of double recording. If birds are recorded without using the question-marked solid line. supracting the notion of territorios will misuit.

When there is no line joining the registrations, this indicates that the birds are probably different, drispossible to use a custation marked dotted line, indisating that the registrations were almost suitainly of different birds.)

Where adjacent nests are marked without a line, it will often be assumed that they stere list and second broads, or a replacement next to owing an earlier talura.

The above conventions indicate when registrations relate to different birds. and when to the same bird. Their proper use is essential for the accusate passagement of clusters.

le all record the standard BTO code: for Entre houtd be used.

Some territories will overlap the plot boundary and overal ways of dealing with these are considered below. Normally it is necessary to map records outside the plot. In the field, this may be accomplished by recording eventhing detected from the boundary without walking outside the plot. The field maps therefore need to extend by about 100 m in all directions to include these observations.

### Territory Mapping Nethods

### 4. Habitat recording

To interpret the reasons behind the distribution of birds on a plot, it may be necessary to describe its separation in some you (Chapter 11). Since the hird data are mapped, it is ideal also to map the vegetation to analyse habitat utilization by hirds. If the plots are each relatively uniform and there are reveral of them that differ from one another, it might be sufficient. to describe or measure the vegetation without mapping it.

### Variations of the method

Up until now, we have concentrated on the BTO's Common Bird Census, where it is important that the method does not vary. For other nurvers it, may be useful to vary the method in the following ware

### 1. Restricting the list of spacies covered

The GBC and bird community studies include all species, as at least as many as san possibly be recorded. If the purpose of the study is more restricted, the first variation is to map fewer species. This helps to concentractime and effort in the required direction. The purpose of making tenvisits is to gather enough data to register territories of species differing in their breeding and singing assions. If only one species is being studied, five visits at the most appropriate season and time of day would suffice.

Recognising the boundaries between territories of hirds of the tame species is the single most important aim of territory mapping. In a study aimed at a particular species, more effort can be put into finding neighbearssinging at each other or fighting. The species map could be updated after each field with. In this way, it would be obvious if there were any areas where it was going to be difficult to resulve the number and pattern of clusters. Latra field effort could be made in these places on subsequent. winters.

### 2. Eliciting responses

The observer can increase the chance of finding birds and obtaining simultaneous registrations by using a tape to play snatches of song of the target species and recording may responses. If a upp is played in places that may be tentiony boundaries, it might help to see whether or not there is a response from both birds. Owners of isologed territories offensing less than where the treighnours are close. A tape recorder could increase the chance of getting sufficient resourch for a cluster. Many migrants only sing early in the brocking sensor, but a tape recorder can git a response while birdenro pesting and have largely stopped singing. Thought should be given, however, to the risk of disturbance caused by this method.

For some elusive blick, dogs can be used to increase the chance of obtaining registrations. Dogs are regularly used in counting gamehinds and for Fit ding nexts of ducies or success. It goes sightent asying that a mitable and well trained dog and handler are needed if this method is to do more good for the centrals than harm to the birds.

#### 40

49

Figure 3.3

(continues)

an Figu

Stan

code

map

birds

re 3.2	80	Stock Dev
	CS.	Great Spo
Cart	g .	Grybrit.
s tor	TP	Tree Pipit
ping	VIB	When
5	A.	Piobie
2	N	Nghtings
	30	Stonechus
	8	Backord
	ST	Song Thru
	SW	Sector We
	HA	Feed Wa
	LW	Looser W

LT.

80	Stock Drug
CS.	Great Spotled Weadpecker
g .	Grylant
TP	Tree Pipit
NR	Wien
R.	Plobin
N	Nghtingale
30	Stonechat
8	Backbell
SE	Song Thrush
SW	Seciga Warbler
HH	Feed Wattier
LW.	Loosee Whitethroat
WH	Whitethroat
GW	Garden Warbler
BC .	Bischcap
OW	Wood Warthler
CC	Childhalf
GC.	Goldcrest
PPE -	Pied Flycatcher

Long-tailed Till

Elic) Census Techniques

### Tenitory Mapping Methods

MT.	Narsh Tit
WT:	Willow Tit
CT	Coel Tit
57	Dive TR
GT	Great Tri
NH	Nuthetch
TC	Treecreeper
MG	Magpie
FD.	Finds
C	Carrier Crow
EN.	Ravan
50	Elaring
CH.	Chaifinch
CR	Greenlinch
00	Coldinch
L	Linnet
1.71	Fiectool
BF	Bu#linch
¥.	Yellow teatmen
EB.	Field Burting
CB	Core Burting

A selection of standard species codes developed by the British Trust for Omithology for British passening species commonly recorded on Common Bird Census plots. The full list (British Birds 1954) can be used for any kind of bird recording in all hapitals and conditions throughout the Western Palaeartic.


### 3. Bird recording

The identity and activity of all birds are mapped with small and tidy striling. in pencil or ball-point yea. If the map gets wet, some inks run; ball-points do not work on a wet map but pendis still do. It is beloful to use a standard list of rodes for hird species. Codes for some British birds are shown in Fig. 3.3. Activities are also given standard codes (Fig. 3.3). Care should be taken to moved as much detail as possible such as the sex and age of the bird. It is often critical in analysis to know shether a multiple observation was a pasty of juveniles. Were two different hirds nearby a) the male and female of a gair, or b) of the same sex and thus presumably near a territory boundary?

The most useful point to concentrate on is the location of individuals of the sume species that can be seen or heard simultaneously. A key feature of analysis is the assumption that territory boundaries fall between such records. For uniformly distributed species, it is difficult to analyse the results without reference to simultaneous registrations. It may not be clear if a singing hird is different from one seen earlier, a short distance away. Such ambiguous registrations must be joined by a line with a question mark to indicate that the observer is not sure whether thes are the same hird or not. They are quite likely to be the same bled. If they really are different, the channess are that both will appear simultaneously on a different visit.

Figure 3.3	CH. CHA, CH &	Chatterine sight resonance, with ago, sox or number of birds it appropriate. CH indicates one pair; 2CH means two
Standard	3 CH Juns, CH of 19	pairs together
symbols for bird	R. fore	Juvenile Robino witi pasenta(a) in attendance.
activities	8	Acolling Robin.
	ř.	A Robin repeatedly giving aliam calls or other vocatisa- lions incl song) thought to have strong territorial agrificance.
	ß	A Robin in song.
		An aggreeative encounter botween two Robins.
	**	An occupied neet of Rebins, do not mark snowaupied neets, which are of no tenitorial significance by them selvers.
	38 BT	If up Tits reasing in a specially provided site (e.g. nestbox)
	w PW on	Red Wagbelmeet with an adult sitting.
	Pwimak	Red Wagtel canying next material.
	Pw/ find	Pied Wagtelfeanying food.

Movements of birds can be incluated using the following conventions:

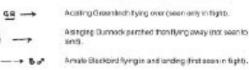

(continued)

The standard BTO list of conventions is shown. These are designed for clear and unambiguous recercing. Symbols can be combined where recessary. Additional activities of territorial significance, such as displaying or mating. should be noted using an appropriate clear abbreviation.

# **APPENDIX 2**

# WINTER 2015 (JANUARY AND FEBRUARY)

The data from the January and February 2015 winter walkover surveys were collected as species counts and are enclosed as an Excel spreadsheet that give the numbers recorded along various sections of the Proposed Project.


		BIRD	S US	SING	SITE																																						
SURVEY SECTION	DATE	В.	BF	BH	BT	BZ	CD	CH	CM	СТ	D.	DI	ET	FF	GC	GL	GO	GP	GT	GR	H	HC	HG	HS	JD	K.	L.	LI	LT	Μ.	MA	MG	MP	MS	PH	PW	R.	RB	RE	RO	RP	S.	SD
The Grange - N3/M50 JCT	04/02/15	14		28	35			10	1	5		1			2	1	19		13			5	2		5	1			4	1	8	9		9			21						
N3/M50 JCT - Cappagh Rd	04/02/15	10			9	2				2	8						5		6			4		4	3	1			5	6		16	9				16	1	10	1			
Cappagh Rd - M2	04/02/15	35	3		13	1		1		1	4	3		57	1		2	34	7		1	6		2	4		33	4		1		9	1			1	20	3	63	22	2		4
M2 - R108	03/02/15	63	7		23	3		12		5	12		1	12	1	1	6		2	2		7		2	4			65	7	2		22	13				11	17	55			164	
R108 - M1	03/02/15	16	3		13	3		3		7	6						4	10	5	1		13		2	2							4	34			1	24			23		2	
M1 - WWTW	30/01/15	18		7	3			1								2	6		5			1	2	4	2			50	3			4	240		2	11	7	2					
WWTW	30/01/15	10	2	22	2	3		4	32		1								1			7	40		14							14	15				4	6				1	
WWTW - R107	30/01/15	21	2		12	1	2	6		1	2			10			4		3	1		2		6	8					6		9	45				16	3	32			20	
R107 - Railway	30/01/15	28				1		4		2	3						72		6			7	2		7				2	3		11				1	10		11			27	
Railway - R106	30/01/15	6									2			2			1																2				3		8			4	

							BIR	DS II	N FLI	GHT	r on	LY																																							
SG	SH	SN	ST	TS	WP	WR	Y.	Β.	.   B	F E	BH	BT	ΒZ	CH	СМ	СТ	D.	FF	GC	GO	GP	GT	GR	Н	HC	HG	HS	JD	L.	LI	LT	M.	MG	i   MP	MS	PW	/ R.	RB	RE	RN	RO	S	SG	SH	SI	1   ST	T   1	TS	WP	WR	Υ.
2			5		22	4									2					3						1		2					3																6		
12		1	12		26	14							7												2	1		10					4		4						12								2		
141			6		63	5	9							2							3				1								1								20		10	1	2				2		
14	1		11		44	25																		1	5				10			5	10								20								4		
1					42	11					2				2					4					3	4		7					1	1							9	3							6		
	1		2		13	7	4				3				4					1					1	1		3													25								8		
10				3	111	7	5						1	1											1									10						1	31	11							70		
80		3	5		14	3					3			1						1					1	1		6					4								1		31						3		
16	1		5		40	6	1						2							2						2		11				4	5	10							2		1						32		
					10	3		1					1		14											14							4								2	20							2		

# APPENDIX 3 WINTER 2015 (NOVEMBER)


The data from the November 2015 winter walkover surveys were mapped, and are enclosed below (along with the associated survey recording sheets).

	-	Cher She	3	Wind Speed	peed		Direction	RainSnow	M	Claud Cover	Cloud Height	Visibility
RPS		weance January	ē		Beaulor	n Moh					Househ of should	
Sile	ى	600		Calm Light air			z¥	None Drizzle/Mist		h eightra e.g. 3:6	above average shove average hoinhi ol	Poor (<1km) D Moderare (1-3km) 1
Date	91	SI 02/11/91	n	Light breeze Gentis breeze	D	4-7 8-12	ш үл Ш	Light showers Heavy showers	wars 2 Dwars 3		viewshed	Good (+ 3km) 2
Survey	3	ULLER LOO	0.	Mod. breaze Fresh broeze		13-18	ы Va	Heavy rain Lying Snow	3	Frost	<150m 0 150-500m -	
Observer	Ż	N. Veel		Strong breeze	JTBB28 6	25.31	MM	S Runfa				
Start Time	$\vdash$	08:30		Fresh gale		9446		On sile		Ground 1	_	Please be as accurate as possible, with weather details, entering only one figure
Finish Time	-	15:30		Whole gale							_	nor a range. e.g. WS - 5, not 5-5. Use notes for extra into.
Sheet 1/	&[ ]\$	] Maps attached	ched	Hurricane		73+					E.g. WS · 5, gusting 6 (in notes).	ng 6 (m noles).
Weather	Wind	Wind directing	Rain	Cloud	Cloud	Visibility	Frast	Snow	Notes/e.g.	Notes(e.g. temperature)	rrej	
Hr 18:30	-	S.C.	٥	-	116121	~	Ì	1	2°6			
Hr 29:56	m	3	0	6/8	14	5	ł	l	2.2			
Hr 314:30	e	35	0	8/8	2	2	1	l	202			
Hr 4 16:30	~	S	4	5/2	_	2	l		م م			
Hr 5 1213	~	s S		218	_	_		1	900			
Hr 6 ()'3e	4	3 N	2	8/8	-	4	1	ł	800			
Hr 714:30	÷	SU	2	818	-	第1	ļ	1	28			
Hr 8												
Field Notes: Maps altached	ached											
For office use only. NB- Initial <u>AND</u> date <u>ALL</u> boxes.	e only. NB- ate <u>ALL</u>	Logged		Databa	Database Entered		Database Validated	/alidated	GISI	GIS Entered	GIS Validated	lidated

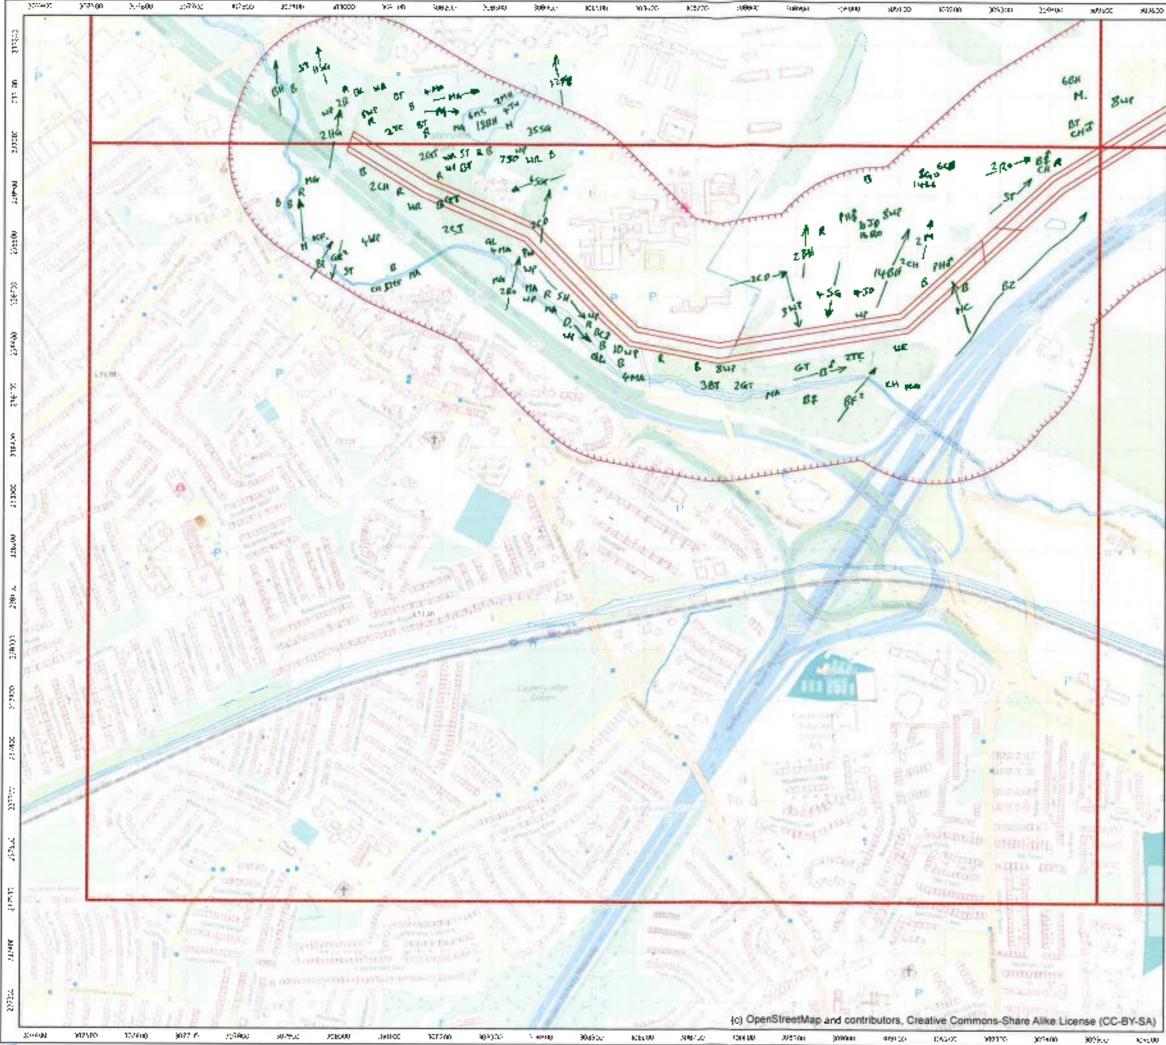

	RPS Winter Welkerer
	Surveyor: N. Veale
	Date: 16 11 7016
	Start time 8:30 End time: 15:30
	Please altach weather sheet Notes:
	6 77-8-19 <sup>7</sup> 10 1911 12 13
	14 (155 18 177 18 (c) OpenStretulMap and
	Contributors, Creative Commons-Share Alike
	Legend
	B65/VV/VO survey boundary (250 m buffer, supplied 20140420, blus 250 m buffer of protruding access track
101	supplied 201509-7)
	Greater Dublin Drainage
	Greater Dublin Drainage Breeding/winter bird survey
	Breeding/winter bird survey


	No.	Westher Sheet		Wind Speed	Speed		Direction	Rain/Snow		Cloud	Cloud Height	Visibility
(LL)			Ē		Beeutort	nt Moh						
Site	5	00		Calm E			Z	Nane Deteologiation	0.	in eghtrs 3.2	Height of cloud above average	Poor (stkm) 0 Moderate (1760) 1
Date	2 (	E		Light breaze		4	<u>ا</u> س	Light showers		i B	height of viewshert	Good (>3km) 2
		19		Gentle breeze Mod. breeze	au	8-12 13-18	ងីស	Heavy shokers Heavy rain	615 10 4		<150m 0	
Survey	Ż	1	o,	Fresh breeze	_	18-24	SW	Lying Snow		Frost	Ë	
Observer	Z	Nui Ve	lecle	Strong breeze	breeze 6	25-31	N N				>500m 2	
Start Time	T	09:45		Fresh gale		9948E	MM	Nono On site	0 F	Ground 1	Please be as accu	Please be as accurate as possible, with
Finish Time		14:05		Strong gale Whole gale		47-54		High ground		All clay 2	weather detats, entering only on not a range, e.g. WS - 5, not 5-5.	weather detats, entering only one legure. not a range, e.g. WS - 5, not 5-5.
Sheet 1/	1_	] Maps attached	ched	Storm Hurricane	= ₽ ₽						Use notes for extra mito. E.g. WS - 5, gusting 6 (in notes).	a anto. g 6 (in notes).
Weather	-	Wind	Rain	Cloud	Cloud	Visibility	Frost	Snow N	oles(e.g.	Notes(e.g. lemperature)	(a)	
	speed	direction		COVER	height							
Hr 10645	2	ц Ч	0	8/8	2	2	Ì	1	700			
Hr 2 4:45	2	×	ų	8/8	2	2	1		S°C			
Hra (o.e)	r	SE	4	8/8	2	۲	1	-	200			
Hr 4(1:45	3	SE	2	8/8	_	-	1		2.0			
Hr 512'45	4	5	4	8/8		2		1	300			
Hr 613:45	4	λ	2	8/8	1	2	1	5	willen	Stopped	at 14:0	5、144、レーシ
Hr 7[4/kS	6-8	SU	Sup	Sudvian	Stappe	ped	-	0		See L	med s from	55
Hr 8									~			
Field Notes: Naps attached	ched											
For office use only. NB- Initial <u>AND</u> dete <u>ALL</u> bazes.	only. NB-	Logged		Databa:	Database Entered		Database Validated	alidated	GISE	GIS Entered	GIS Validated	daled

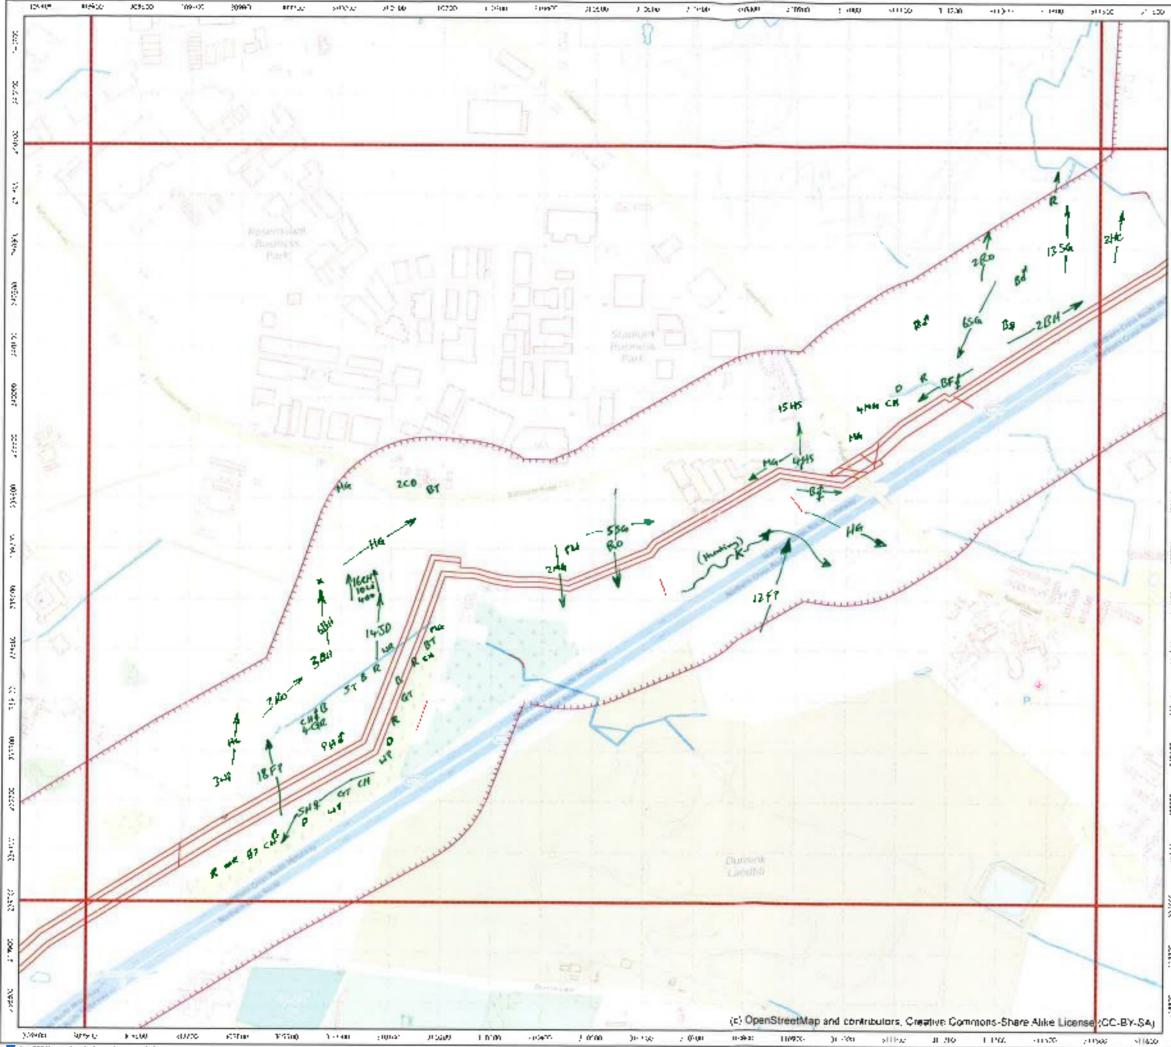

🔲 ter (2003) - Hitt Select Witten (25 Connecting), articularization (4 Crustering), 7900, Materia, 2015) 4 April



Legand BSS/WWO survey boundary (250 m buffer, supplied 20140420, plus 250 m buffer of protruding access track supplied 20 50917) Greater Dublin Drainage Broeding/winter bird survey Page 15 of 18	Image: State 17,500 (\$A3	a       a	*Please attach weather sh Notes:	cet



SdB	Wei	Weather Sheet	et	Wind Speed B	i <b>peed</b> Beautori	od Mph	Direction	Rain/Snow		Cloud Cover	Cloud Height	Vigibility
Site	600	00		Calm Lighi ar	÷-		z₩	None Drizzle:Mst	0-	in agrittes e g. 3:8	Height of Cloud above average height of	Poor (<1km) 0 Moderate (1-3km) 1
Date	20	20/11/2015	N	Light breeze Gentle breeze	eeze 2 Dieeze 3	<b>4</b> -7 B-12	ᄪᇏ	Light showers Heavy showers			_	Good (>Skm} 2
Survey		Uiter U	0.	Mtxd. tyreeze Freah braaze		13-16 18-24	s SW	Heevy rain Lying Snow	4	Fröst	<150m 0 150-500m 1	
Observer	Z	N. Vede		Strong breeze		25-31	W	Mann	_		×500ni 2	
Start Time	8	8100		Fresh gale	- 44 c - 44 c			On sete	>	Ground 1	Please be as acc. weather details, e	Please the as accurate as possible, with weather details, enternment only one houre.
Finish Time		14. IS		Whole gale					ų		nol à range, e.g. WS - 5. nol 5-6. Lise notes for extra info	uS - 5, noi5-6. a into
Sheet 1/ 8	å[]M	Maps attached	ched	Storm Humpane	15 12	44-72 13+					E.g. WS - 5, gusting 6 (in notes).	ng 6 (in notes).
Weather V	L	Wind	Rain	Cloud	Cloud	Visibility	Frost	Snow Not	es(e.g.	Notes(e.g. temperature)	12	
S	Þ	direction		cover	height							
Hr 1 8:20	Ś	у С	0	415	ч	-	ļ					
Hr 2 9:36	£	ŝ	0	SIG	5	ہ	Ì	[				
Hr 3 (c) a	ė	2	0	818	2	2	ì	(				
Hr 4 ( 1	+	٦	0	818	2	رے	1	{				
Hr 5 121.05	ł	3	0	818	2	5	ł	ſ				
Hr 6 (3; un	£	ΓĽ	m	8/8	ţ		1					
Hr 7 Juneo	ţ,	NN	Μ	818	-	1	1	- Kcale	the forme	re Gusti	TE Survey	Stapped + 14.15
Hr 8											١	
Field Notes: Meps attached	hed											
For ollice use only. NB- Inlia <u>i AND</u> date <u>ALL</u> boxes.	only. NB-	pəôboq		Calaba:	Dalabase Entered		Database Validated	alidated	GIS E	GIS Entered	GIS Validated	idated

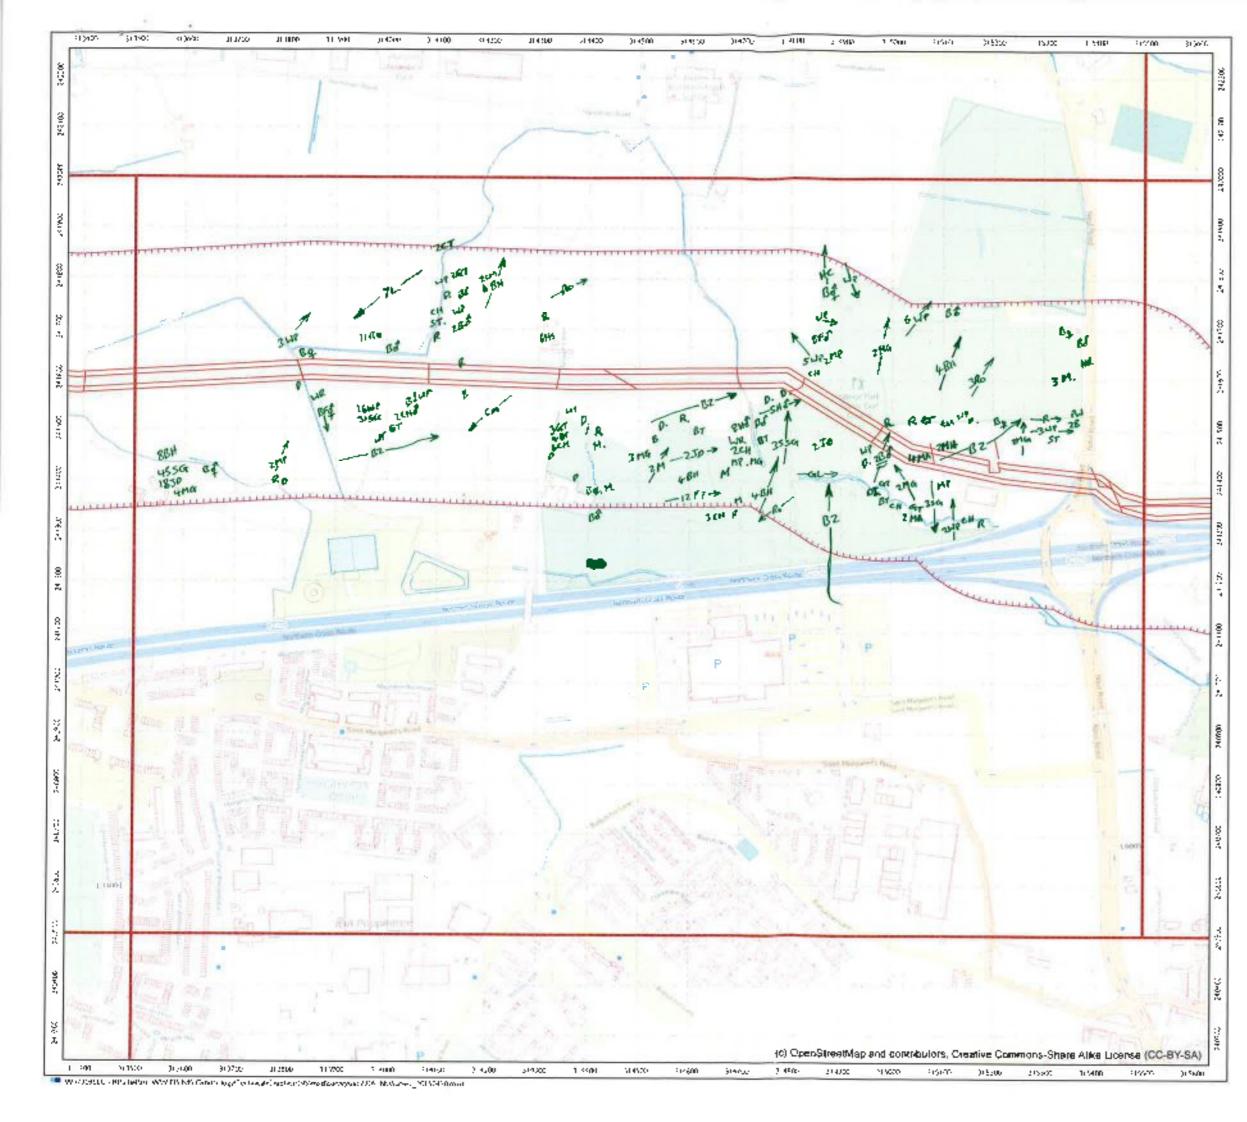

- m	1161
ы.	. · · · ·
- I N	<b>ں</b> ا

Surveyor. N. Vean	
Date Zo III Zor	IS
Start time: 💈 😡	End time: 14:05

Please	attach	weather	sheet
Notes			

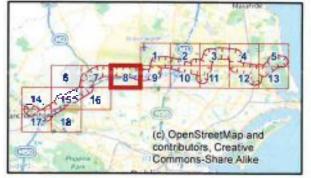

l egend


BBS/WWO survey boundary (250 m buffer, supplied 20, 10420, plus 250 m buffer of protrucing access track supplied 20150917)

Greater Dublin Drainage

Breeding/winter bird survey

Page 8 of 18

C Scare c7,500	200 m 	-
Cate 20/:0/2015	job No: 50C7909	Bev h
Crawn: CH	Checkrol DRAFT	Approved DRAFT
	: 2000 Market Reptakted Komine ( armen Likeray No	Ordinance Survey On Instand by

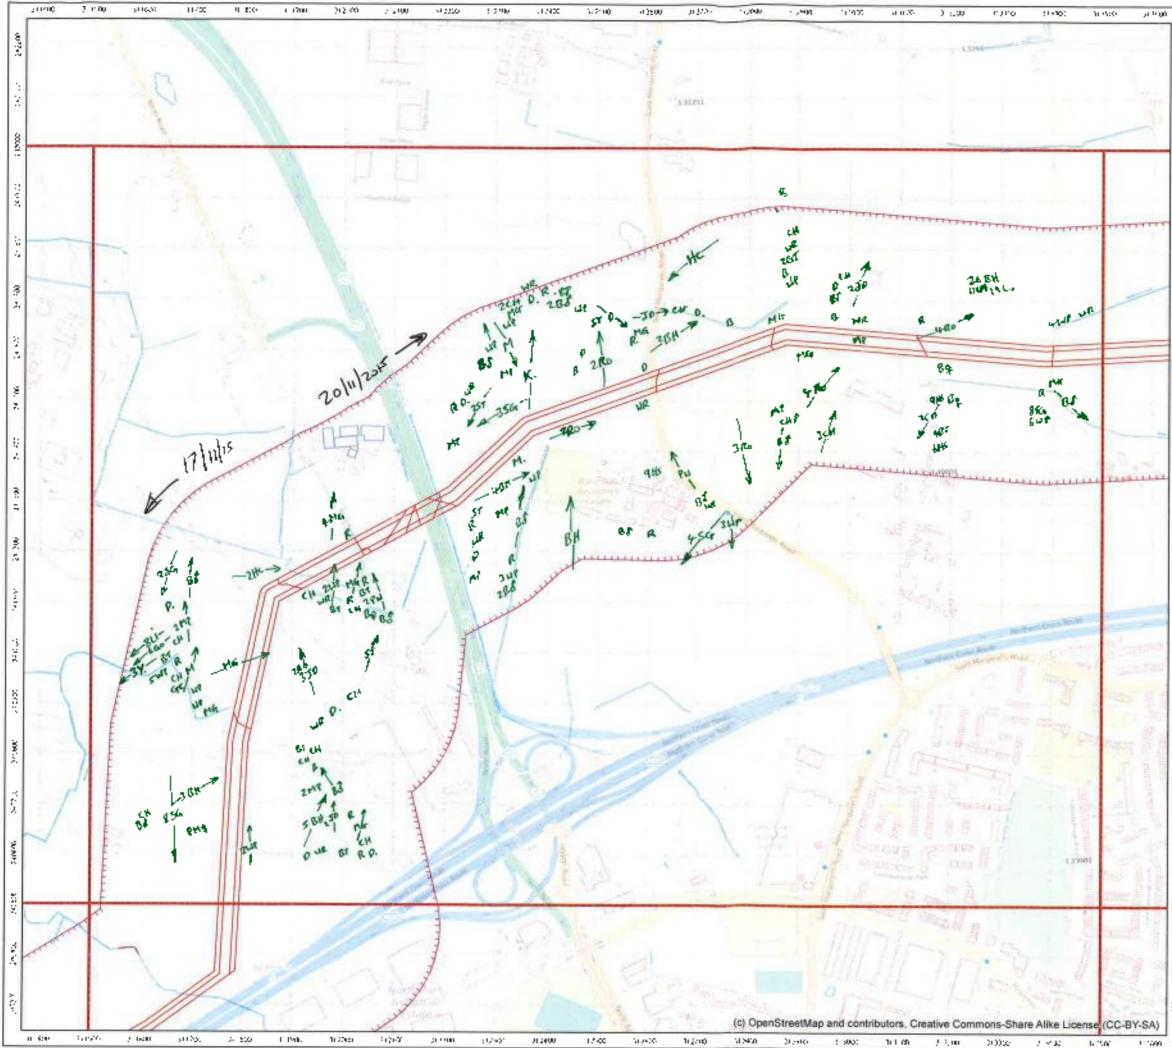

💻 90 - Anthe - MIT Andre - Alter Chester Constanting on a social Chapter of the next series and 200 - Next Series \_ 201 (2620) and


.

.

1.4.8

RPS	
	Verte
Date: 17.11	1 2015 + 20/11/2015
Start time:	End turne
*Please attach v Notes:	weather sheet
-	Materioe
	1
a	7-8-19 10 711 12 11
14 (15)	15
17-18	Ici. OpenStreelMap and contributors. Creebve
Abypus Tata Tata	Commons Share Alike
Legend	
BBS/\	WWO survey boundary (250 m
E m bu	r, supplied 20140420, plus 250 lifer of protouding access track
suppl	led 20150917)
	ublin Devenee
Greater D	Jublin Dramage
Greater D	)ublin Dramage winter bird survey
Greater D	winter bird survey
Greater D Breeding/v	winter bird survey
Greater D Breeding/v Page 7 of	200 m
Greater D Breeding/v Page 7 of	200 m

Site Date Survey L		Weather Sheet	Deads Duim	Deed		Direction		MO	Cover		
ey				Beautort			-	c	_	Height of doud	Book (a then) D
ey	G-00		Light air		25	zΨ	Drizzle: Mist		e 13.378	ebove average heidht of	Ē
-	24/11/2	2215	Light breeze Gentle breeze		4-7 B-12	щщ	LigN showers Heavy showers	nvers 2 novers 3		wernshed	Good (>3km) 2
	Jinker U	0	Mod. breeze Fresh breeze	-	13-18	s WS	Heavy rain Lying Show		Frost	<150m 0 150-500m 1	
	N.Vecte		Strong breeze	-	25-31	W.			NARA	>500m 2	
Start Time	02.8		Fresh gala	- e2 4	39-40 39-40		On site	• - •		Please be as accu wealher detarts, er	Please be as accurate as possible, with weather detarts, entering only one flowe
Finish Time	15', 20		Whole gale							not a range. e.g. WS - 5, not 5-6. Use notes for extra info.	NS - 5, not 5-6. a into.
Sheet 1/ & [ ]	] Maps attached	ched	Storm Hurricane	в 12 12	64-72 73+					E.g. WS - 5, gushng 6 [in notes]	ng 6 (in notes).
Weather Wind	Wind	Rain	-	Cloud	Visibility	Frost	Snow	Notes(e.t	Notes(e.g. lemperature)	re)	
	0	0	1	ngian	ſ			70,			
Hr 1 8:80 5	۶Ľ	0	2/0	7	7	ļ		2			
Hr 2 4:20 4	3	-	2/8	-		Ì	[	725			
Hr 3 to a 4	3	5	814		1	1	4	704			
Hr 4 N'AO 4	Σ	ہ	8/8	_	-	1	ł	8°C			
Hr5 124- 4	M	_	8/8	_		1	l	S°C			
Hr 6 1270 lp	3	-	8/8	+	-	}	ł	2.8			
HI7 15 24	3	5	8/8	_	_	Ì	ł				
Hr 8											
Field Notes: Maps attached											
For office use only. NB- Initial <u>AND</u> dote <u>ALL</u>	e. Logged		Databas	Database Entered		Database Validated	'alidated		GIS Entered	GIS Validated	ldated

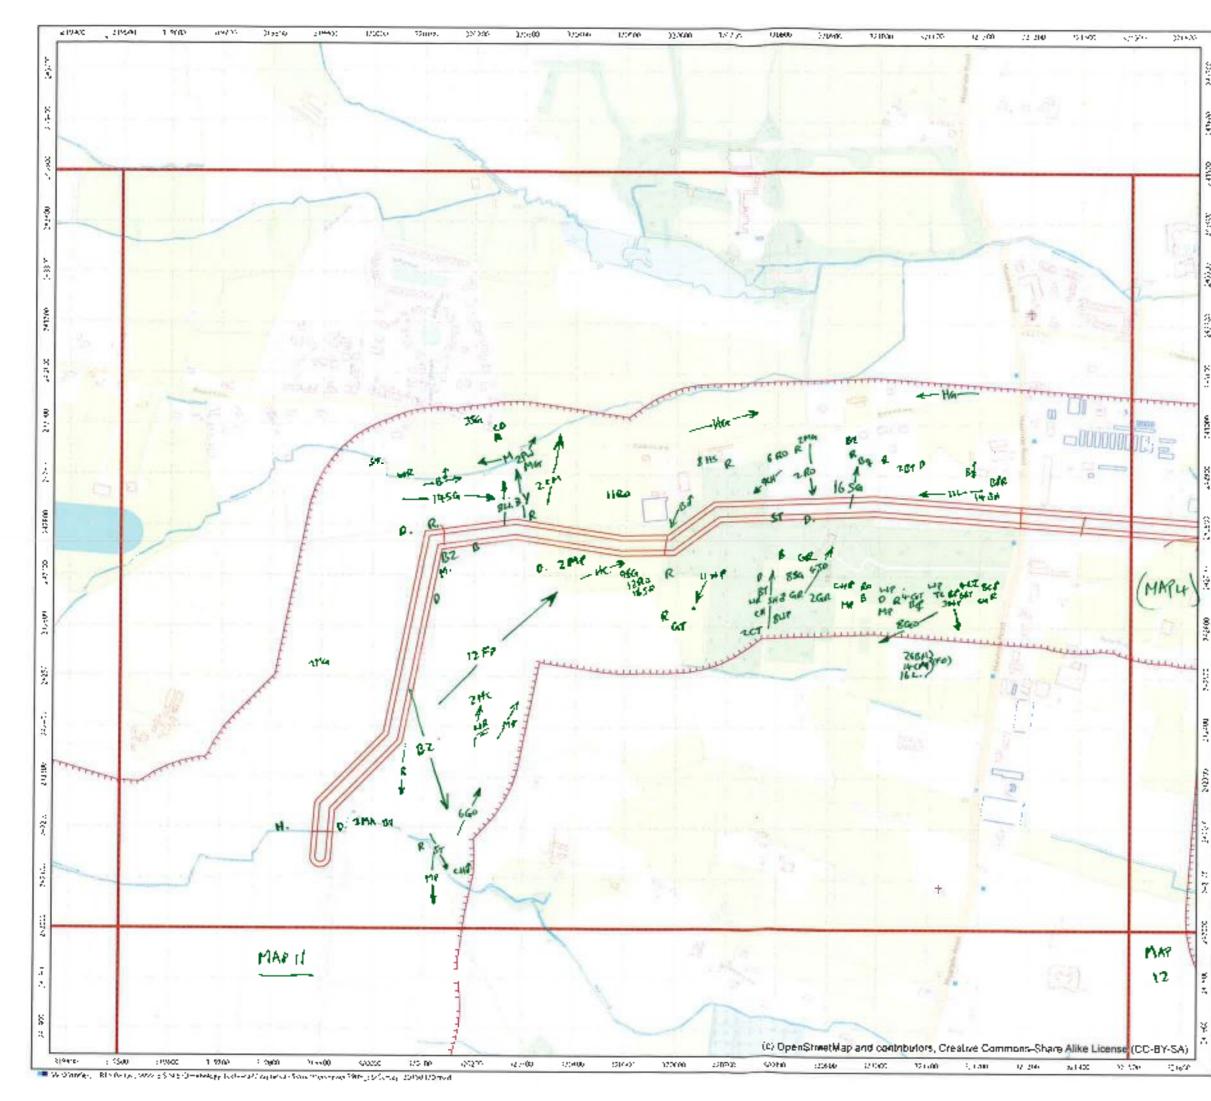

Surveyor: N. V	Veste
Date: 24/1	11 2015
Start time \$ : 2	End time: 15'.20
"Please attach wea Notes.	ather sheet
B 7 14 15 16 17 18 6 17	(c) OpenStreetMap and contributors, Creative Commons-Share Alike
buffer, su en buffer	WO survey boundary (250 m upplied 20140420, plus 250 i of protruding access track (20150917)
	lin Dranage
Greater Dubl	
	nter bird survey
	nter bird survey
Breeding/win	200 m

прадскыр пол




W 4305517 - Dk. Report (3505) Constraining Constraints and Article Activity of State (2004) and an an antipart of the state of the stat

ate. 24/11/- art time: 8:20 Please attach weather st otes:	End time 15:20
Please attach weather st	
	hcel
	A J Marine
5 7 8 4	(c) OpenStreetMap and contributors, Creative Commons-Share Alike
buffer, supplied	rvey boundary (250 m 20140420, plus 250 druding access track 917)
Greater Dublin Dr	ainage
Breeding/winter bi	rd survey
Page 4 of 18	
5 200 i	m i
Date 20/10/2015 Jab No	s SFC7916 Rev. b ec. DRAFT Approved DRA

14

0 DC	3	Weather Sheat	1	Wind Speed	peed		Direction	Rain/Show	N	Cloud	Cloud Height	Visiolity
	:		ī		Beautort	rt Mph						
Site		002		Callm Lightair		- <sup>2</sup>	zŸ	None Drizzle:Mist		in cightis A.C. 3:8	Height of doud above avarage	Poor (<1km) 0
Date	- 2	26/11/24	2102	Light treeze Gentle treeze	ą	4-7 8-12	шŴ	Light showers Heavy showers	wers 2	-	height of viewshed	Good (>3km) 2
Survey.	1	I ster W.	0.	Mod. br <del>oe</del> ze		13-18	6	Heavy rain		-	<150m D	
Observer	2	N. Veale		Strong breeze	828 182 <b>8</b>	18-24 18-25	MS M	Lying Show	MOK	Frosi	150-500m 1 >500m 2	
Start Time		8.30		Mod, gale Fresh gale	ereo. ar∰	32-38 38-46	MN	Nane On site	о-	_		Plettes be as accurate as possible, with
Finish Time		15:30		Strong gale Whole gale	-	47-54 55-63		High ground		All day		weather details, entering only one tigure. not a range, e.g. WS · 5, not 5-6.
Sheet 1/	&[ ]	] Maps attached	ched	Storm Humcane	92 *	73+					Use were tor extra mix, E.g. WS - 5, gusting 6 (in notea),	a rulo. 13 6 (in no <del>te</del> a).
Weather	Wind	Wind	Rain	Cloud	-	Visibility	Frost	NOUS	Noles(e.	Noles(e.g. temperature)	re)	
Hr 1 & 3a	2	(~)		6/14	I I I	-		4	10%	0.000		
Hr 2 9/50	2	3	-	210		-	1	(	10%	Derth		
Hr 3 [630	£	3	0	8/23	-	-		{	1200	1 14 14		
Hr 4 USo	5	Su	-	316	-	-	1	5	124	DAETLE		
Hr 5 (2:3 a	3	Su	-	8/8	_	_	1	ſ	1200	Onerte		
Hr 6 (3:3>	ς	ςu	2	818	-	_	ļ	1		CANN S	S Houses	
Hr 714:35	ς	Su	2	8/8	-	_	ļ	1		Continue	in lain	
Hrß												
Field Notes: Meps attached	ched											
For office use only. NB- Initial <u>AND</u> data <u>ALL</u> boxes.	only, NB- HALL	. Logged		Database En	ie Enlered		Database Validated	alidated	ଣାର	GIS Entered	GIS Validated	dated

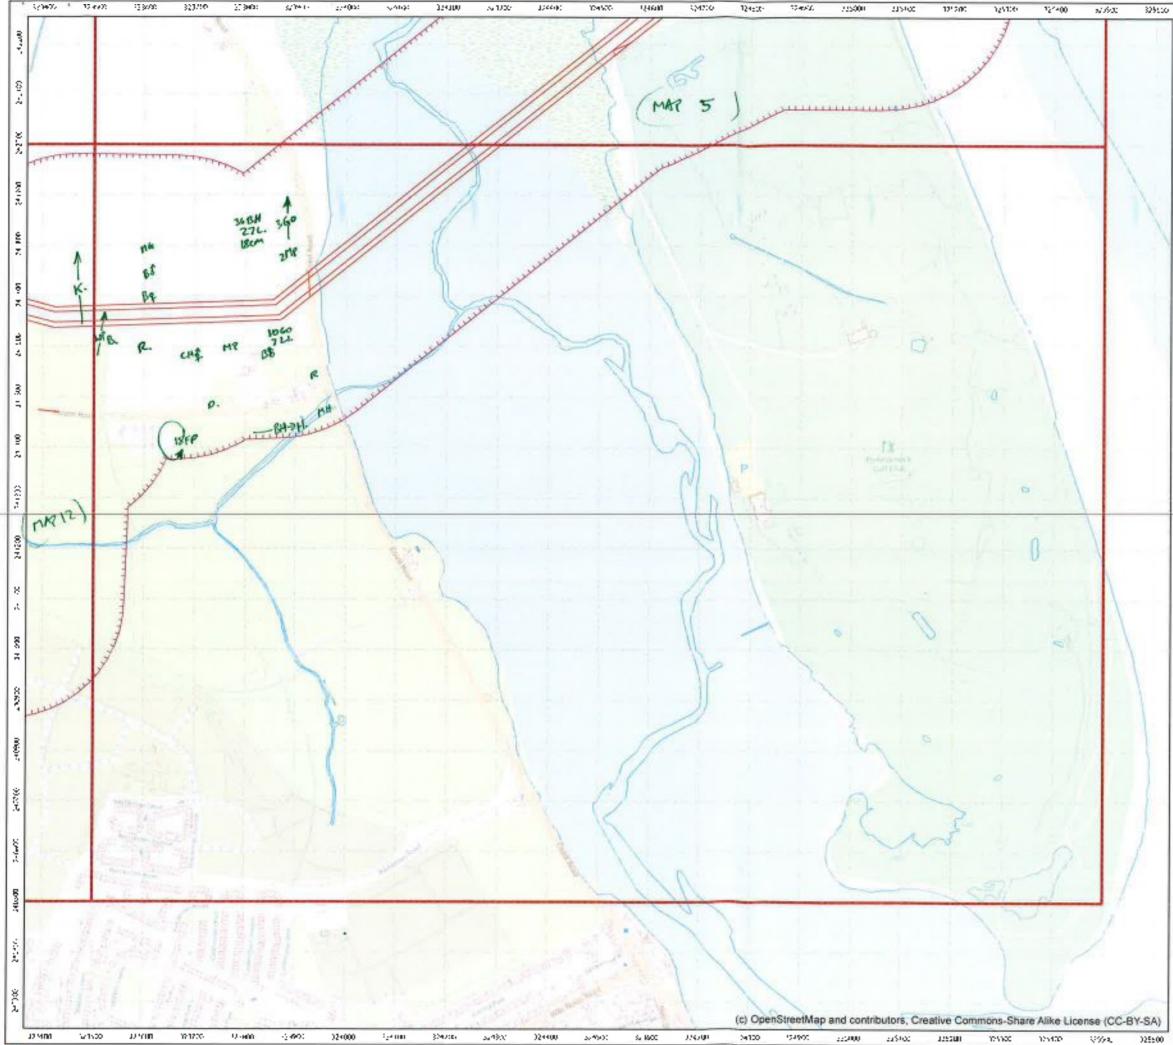

📲 W 1995555 - 80% hill all 199W 85 Mis Challoning Cachera Skapherez, Smallandey (2017) 1895 (1997) 1997 (1997)


Surveyor: N. Va-	
14. 465	
Date: 26/11/	અડ
Start time 08730	End time: 15:30
Please attach weather sh	ee1
Nates:	
T T	Marride
	- 10-5
	2-2-53-4 1
11-8-	9 10 11 12 1
14 (155 16	
17.4 18	(c) OpenStreetMap and contributors, Creative
T Praint	Commons-Share Alike
Legend	
	vey boundary (250 m
many buffer suppled	20140420, ples 250
	truding access track
m buffer of pro	truding access track
m buffer of pro	truding access track
m buffer of pro	truðing access træck 917)
Greater Dublin Dra	truding access track 917) ainage
m buffer of pro supplied 20150	truding access track 917) ainage
Greater Dublin Dra	truðng access track 917) ainage
Greater Dublin Dr. Breeding/winter bin Page 13 of 18	truding access track 917) ainage rd survey
Greater Dublin Dra Breeding/winter bin	truding access track 917) ainage rd survey
Greater Dublin Dr. Breeding/winter bin Page 13 of 18	truding access track 917) ainage rd survey
Greater Dublin Dra Breeding/winter bin Page 13 of 18	truding access track 917) ainage rd survey
Greater Dublin Dra Breeding/winter bin Page 13 of 18 0 200 r Jack 2/00 (04) Date 20/10/2015 (10) No	truding access track 917) ainage rd survey

the relation of the




💷 var 1998 b. 1815 de lan Web BB MS Conchelaged Alamand Agene Disformationsystem (WE) (MeSarary 2018) (2000)

Surveyor: N. Venue Date: 2.6/11/32-15 Start time: 9:30 End time: 15:30 Please attach weather sheet Notes Vote		


supplied 20140420, pks 250 m buffer. supplied 20150917)         Image: Selection of the survey boundary (250 m) buffer. supplied 20140420, pks 250 m buffer. supplied 20150917)         Image: Selection of the survey boundary (250 m) buffer. survey bind survey bin		2 / 2 3
14       15       16         177       18       (c) OpenStreetMap and contributors, Creative Commons-Share Alike         Legend       SBS/WWO survey boundary (250 m buffer, supplied 20140420, pks 250 m buffer, supplied 20140420, pks 250 m buffer of protructing access track supplied 20150917)         Greater Dublin Drainage         Breeding/winter bird survey         Page 5 of 18         0       


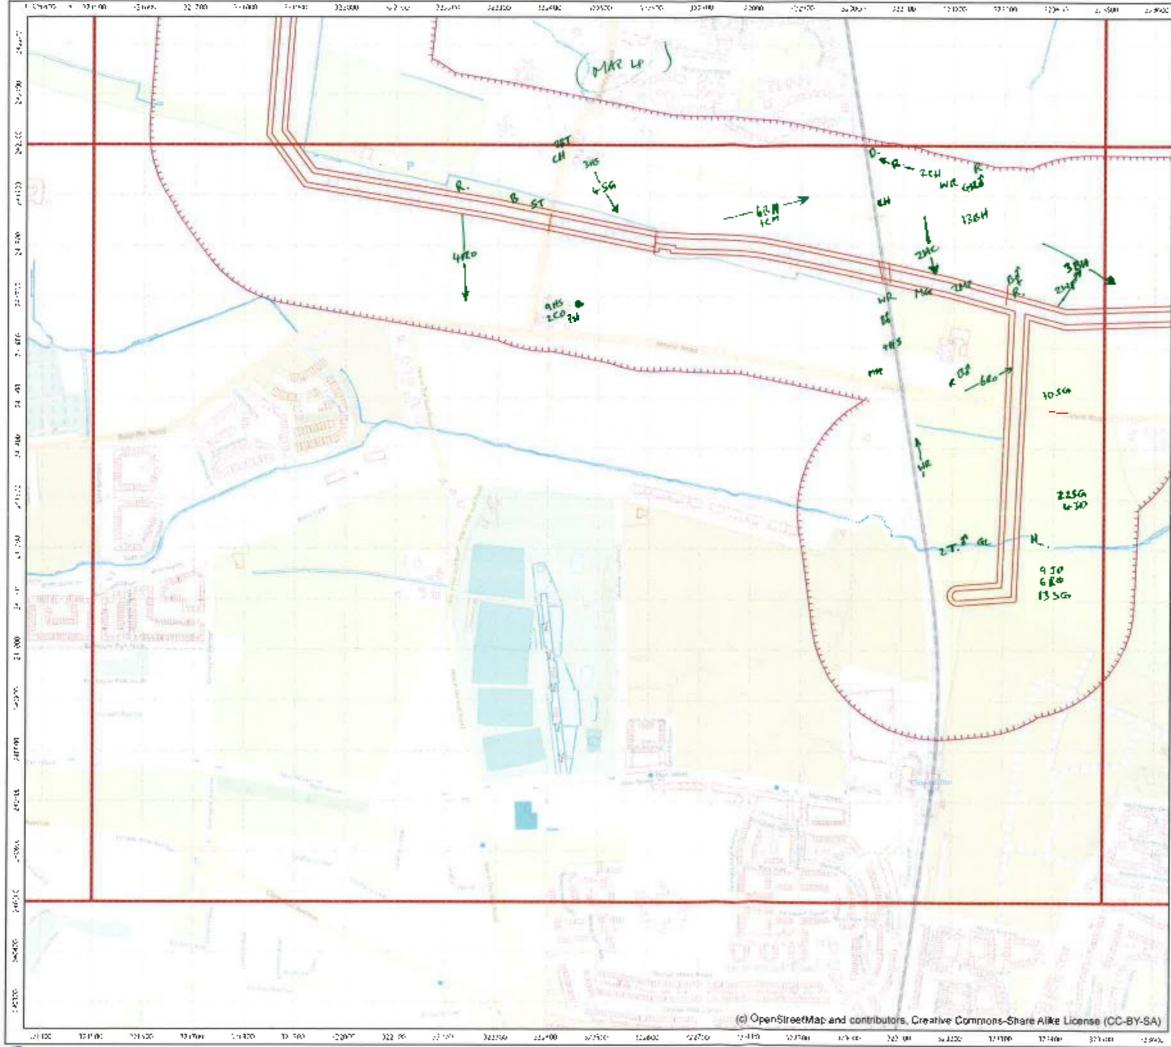


urveyor Nick 1 Date: 26/11/	
tart time: 08-30	Find time: ) 51:30

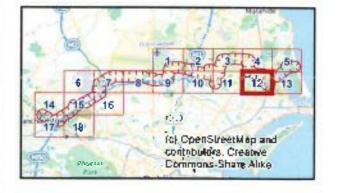

## Legend

ĩ

۶

Ξ.

ī

BBS/WWO survey boundary (250 m buffer, supplied 20140420, plut 250 m buffer of protributing access track supplied 20150917)


Greater Dublin Drainage

Breeding/winter bird survey

Page 12 of 18

0 L I	200 m	4
State 7,500	<u>(1</u> 23)	~
Date: 20/10/2015	Jub Nor SEC7909	Key b
Drawn, CH	Christed CRAFT	Approved ORAE.
	1990) 5 Carl Reportunes (carl the C martin describer (carl the M	ochanne ante Officiency

magroup,com

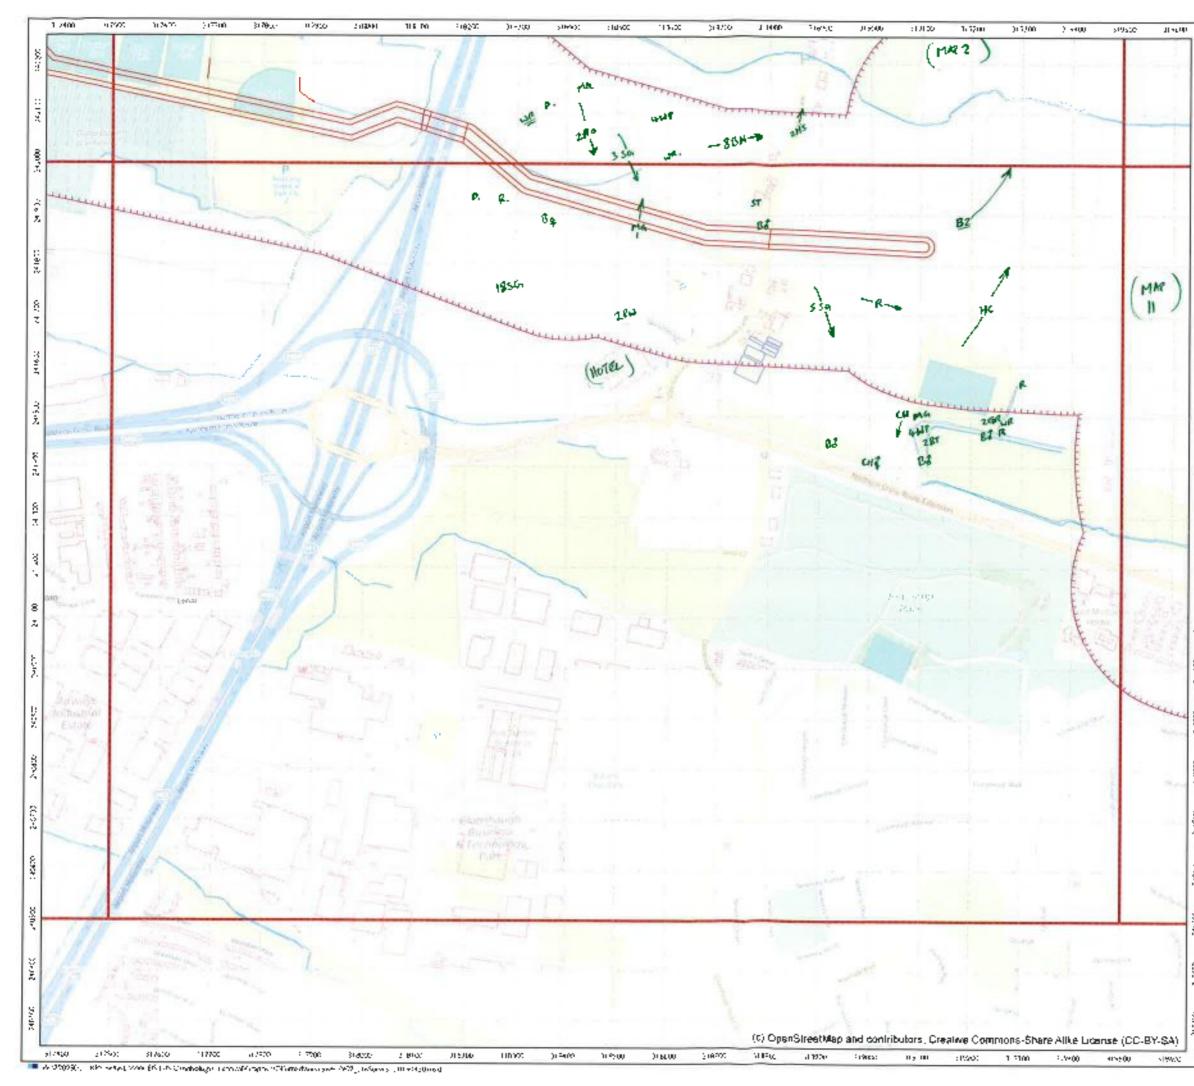

erreger in the last 1	Jose
Unveyor Nick 1	
	15 #26/11/2
laittime \$30	End time: 14:50
Please attach weather sh lotes:	
(Stalwared	or maril
or Contract	2 1 4 3
-	Am 2 F 34 4 15
5 7 8	97 101 11 12 13
14 15 16	÷
L'and the second	(c) OpenStreetMap and contributors, Creative
Pari Pari	Commons-Share Alike
anacd	
Legend BBS/WWO sur	vey boundary (250 m
buffer, supplied	20140420, plus 250 truding access track
supplied 20150	
Greater Dublin Dr.	ainage
Breeding/winter bir	rd survey
a	
a .a	
Page 10 of 18	
Page 10 of 18	ν <b>Ι</b>
	۳


RPS	Ŵ	Weather Sheet	set	Wind Speed	ipted Beautori	WW be	Direction	Hain/Show	NO.	Cover	Cloud Height	Visibility
Site	0	666		Calm Light àir			₽Ÿ	None Drizzle/Mist	Aist o	In eighths e.g. 38	Height of cloud above average	Poor (<1km) 0 Moderale (1-3km) 1
Dete	23	7 10 2005	N	Light breeze Ganile hicezo	eeze 2 bieteze 3	4 4 8 12	л В С	Light showers Heavy showers			viewshed	
Survey	3	1. A. A. U.O		Mod breaze Freeh hreeze		13-18	s n	Heavy rain		Eret	<150m 0	
Observer	2	Side Voor	J	Stord breeze		16.52	3				>500m 2	
Start Time		08:30		Fresh gale		96-26	MA2	e sis	≎	Ground 1	Please be as acc	Please be as accurale as possible, with
Finish Time		HF.50		Strong uale Whole gate				High ground		All day 2	molainor details, enerring only one not a range, e.g. WS - 5, not 5/6.	waamer oetalis, enering only one houre. not a range, e.g. WS - 5, not 5,6.
Sheet 1/	&[ ]]	) Maps attached	ched	Storm	19 I 1 1 1 1 1 1 1 1 1 1 1 1 1 1 1 1 1 1 1	2 2 2					Use notes for exite unto, E.g. WS - 5, gusting 6 [in notes]	e uno. ng 6 [in notes].
Weather	Wind	Wind	Rain	Cloud	Cloud	Visibility	Frost	Snow	Notes/e.(	Notes(e.g. temperature)	(e)	
Hr 18:30	47	Set.	0	6/8	2	2						
Hr 2 913 +	÷	3	0	7/8	2	2						
Hr 3 (6)36	S	SU	-	8/8	13	-						
Hr 4 [135	s	3	-	8/8	-	-			Gusha	an spirit	5 X 4 6	Starting Differen
Hr5[2130	式 金	N30 54	4343	Hie	Alon +	- 20					5	
Hr 613:3o	÷	3	4	8/2	-	-			Swa	CONT. OF	4 13.45 es	1 Und Reser
Hr 714:30	w	MZ	2	8/8	-	-			Survey	Strand	14:50	Freesing Licht
Hr 8												
Field Notes: Maps attached	ached											
For office use only. NB- Initial <u>AND</u> date <u>ALL</u> bound	e only. NB- rie <u>ALL</u>	Logged		Databa:	Database Enterec	_	Database Validated	'alidatec		GIS Enlered	GIS Validated	idated

÷,


e.

-

00/24

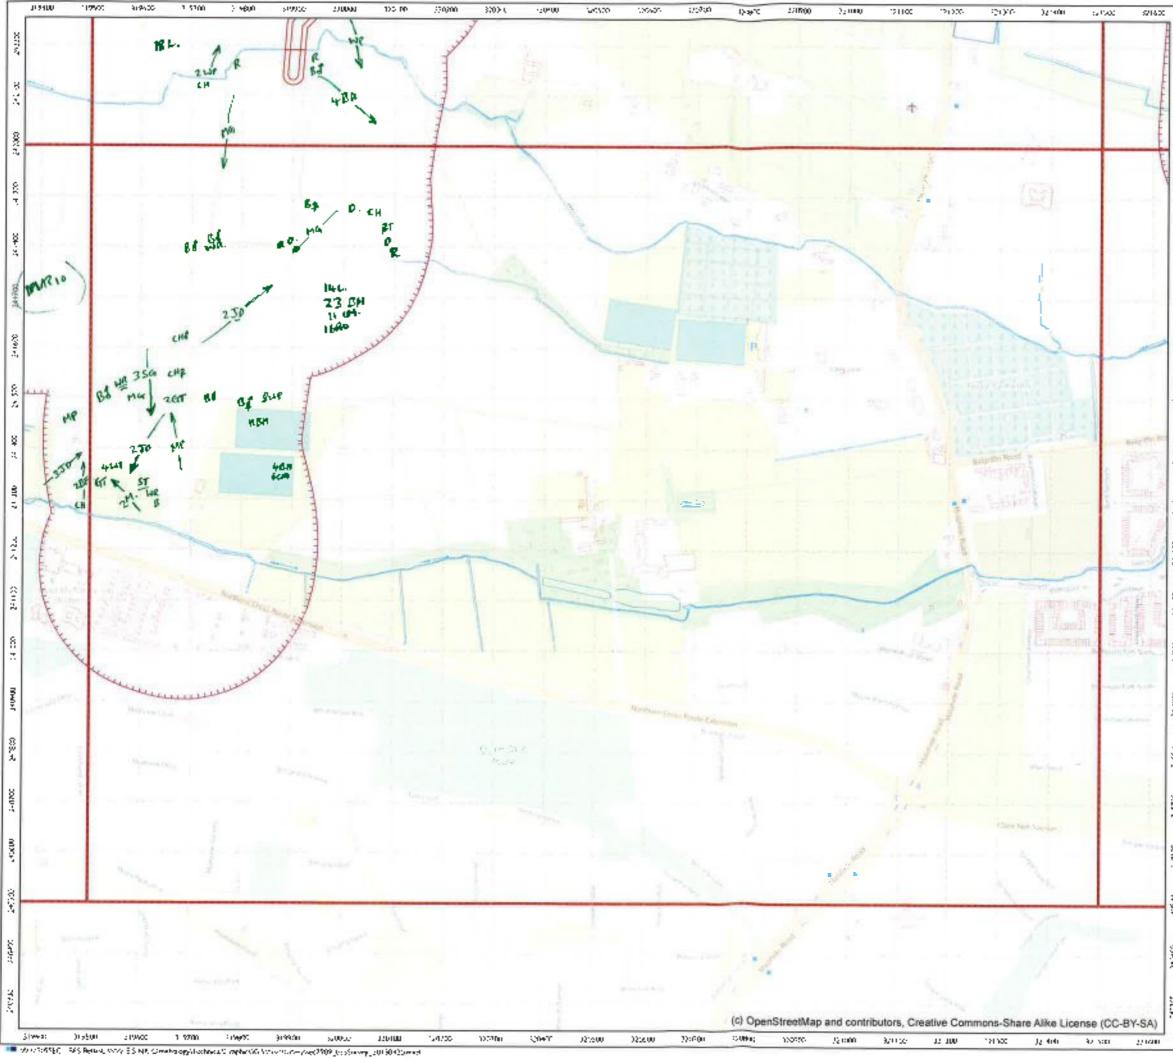


Date. 2-7/11	2015
Start time. 8:30	End time: 14:56
"Please attach weather she Notes:	cci
(ontinue)	from MAR 10
A Charles	
4 Q	CO Lotto I
5 FGILLER	1 1 1 1 1 1 1 1 1 1 1 1 1 1 1 1 1 1 1
14 (15) 16	19 10 911 12 11
172 18	
	(c) OpenStreetMap and contributors, Creative
The second of the	Commons-Share Alike
Legend	
Legend 685/WWO sur	vev boundary (250 m
685/WWO sum buffer, supplied	vey boundary (250 m 20740420, plus 250
685/WWO sum buffer, supplied in buffer of prot supplied 201509 Greater Dublin Dra Breeding/winter bin Page 11 of 18 0 State 17,500 @43	20/40420, plus 250 inuding access track 917) ainage d survey

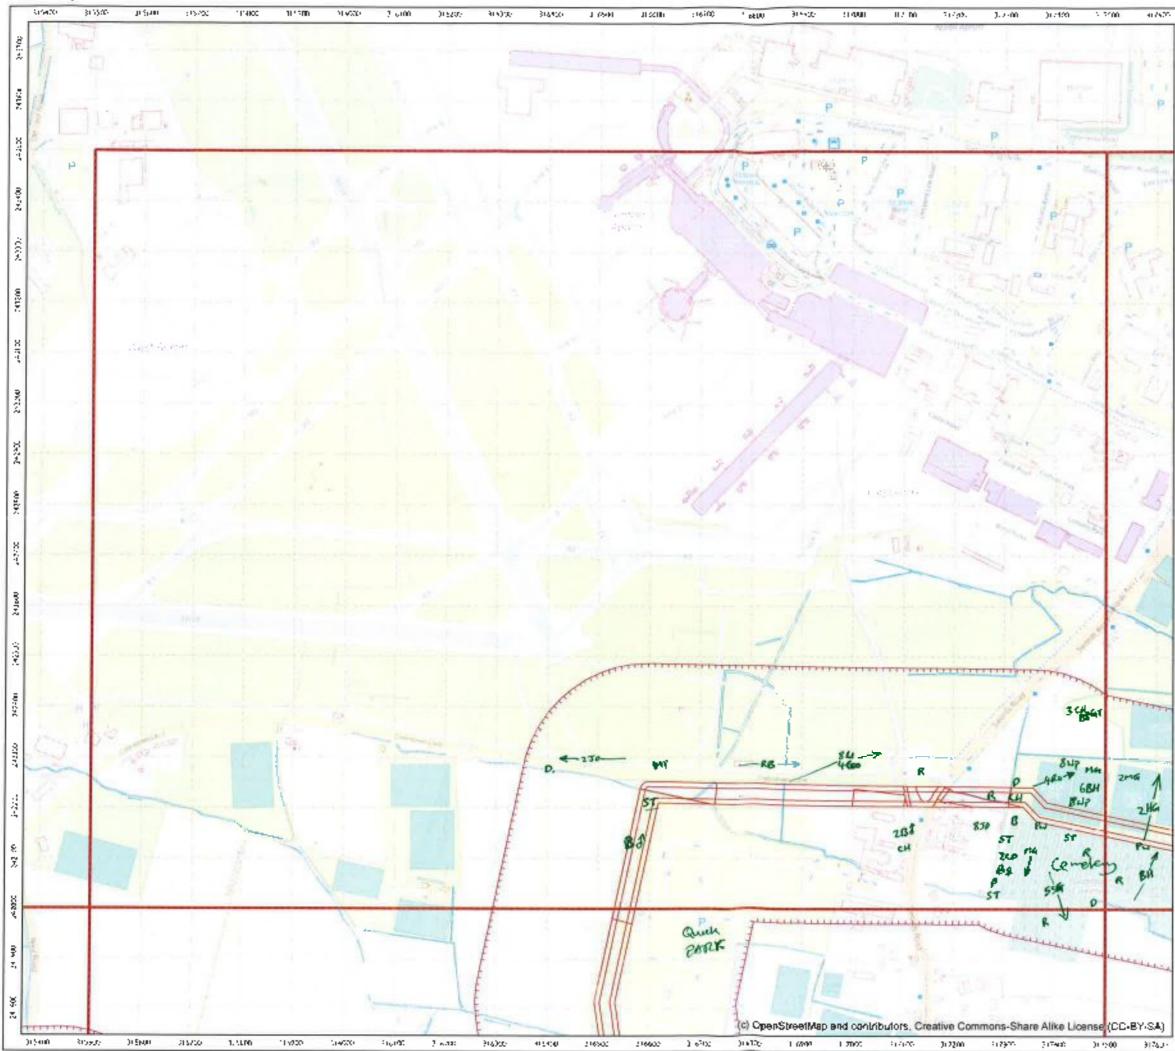

W17909-6-7 PPS Before WW104 NR CommoNug/Technike CompAct/Second commons/M82 pN/secong/20110420 mail

Surveyor	N. Ver	e	
	7/11/201		
Date: Z	7/11/251	1	
Start time	08:30	End time:	148.50
Please at Notes:	tach weath <del>o</del> r sl	1001	
Tre	used c	vosa y <del>r</del> ry	47 S
(	1,2,+	٩)	
Ĩ	10	50	Maario
	6 7.48	1	3 4 51 i 12 13
- One	15 16 18:	(c) OpenStre	etMap and
Ŧ	Phoens A	Contributors, Commons S	and the second sec
Legend	RBS046MO su	rvey boundar;	
	buffer, supplier m buffer of pro	1 201 40420, p otruding acces	
	buffer, supplied	1 201 40420, p otruding acces	
()	buffer, supplier m buffer of pro	1 201 40420, p otruding acces 9917)	
Great	buffer, supplied m buffer of pro supplied 20150	1 201 40420, p otruding acces )917) rainage	
Great	buffer, supplied m buffer of pro supplied 20150 ten Dublin Dr	1 201 40420, p otruding acces )917) rainage	
Great	buffer, supplied m buffer of pro supplied 20150 ter Dublin Dr ling/winter bi 1 of 18	1 20140420, p otruding acces 0917) rainage ind survey	
Great Breed Page	buffer, supplied m buffer of pro supplied 20150 ter Dublin Dr fing/winter bi	1 20140420, p otruding acces 0917) rainage ind survey	

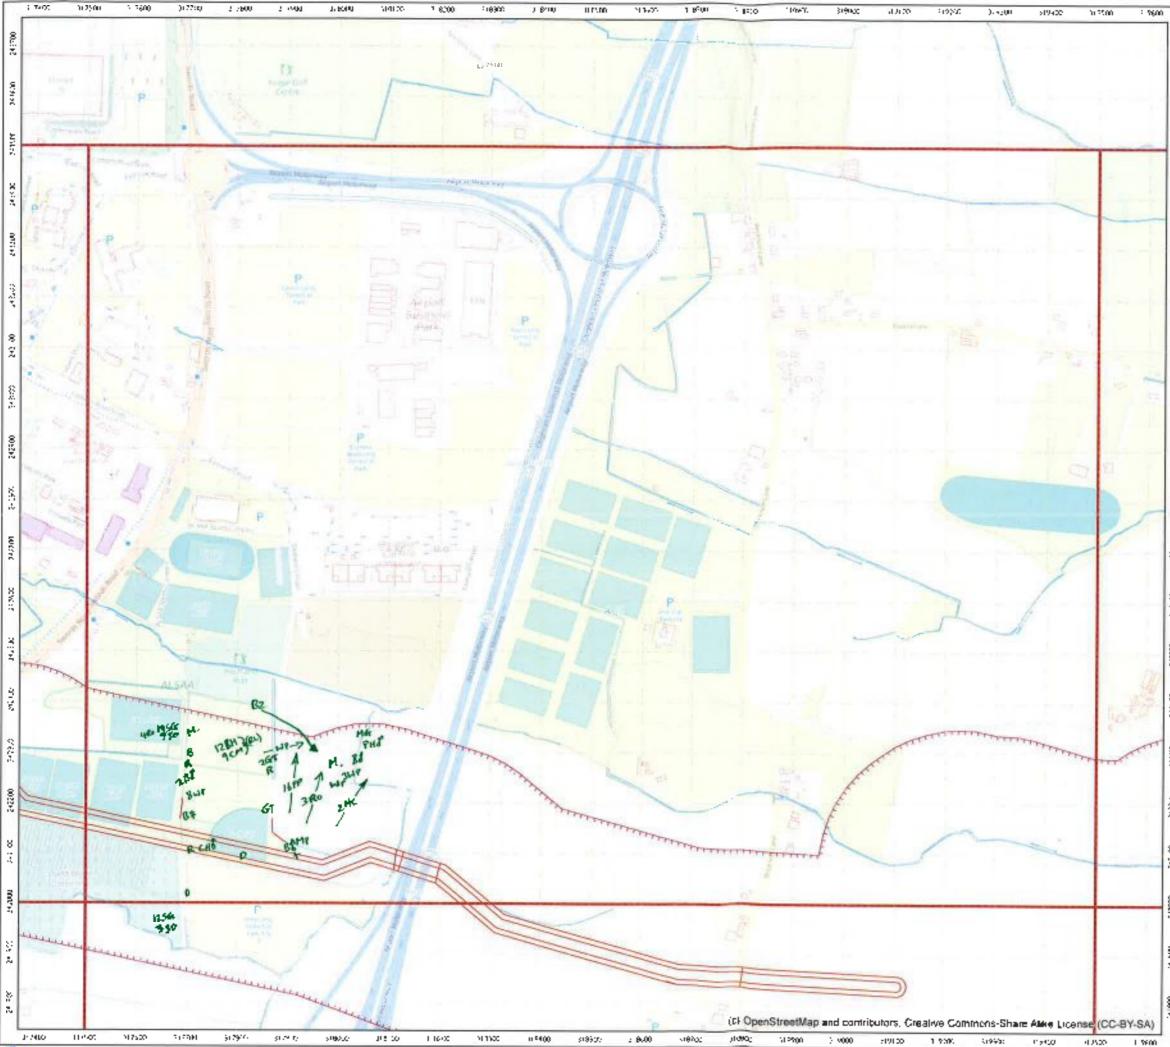

wy 34/54/2018 Peters 2002 LISING Demotological is an affirment of Provide Longitud 2009 (Lindower 2019) 2020 meters

.

,	DDC
24.100	RPS
Cuctor	Surveyor Nick Veda Date: 27/11/2015
2030	Start time: 0830 End time: 14: 50
00r:r2	Please attach weather sheet Notes.
001117	Transection spin over Maps 1,2,+9
X.7757	1,2,+9
-10 Ke	
5+100	
0.212	T Part And
004276	<b>3</b> <b>3</b> <b>3</b> <b>3</b> <b>4</b> <b>5</b> <b>5</b> <b>5</b> <b>5</b> <b>5</b> <b>5</b> <b>5</b> <b>10</b> <b>10</b> <b>11</b> <b>12</b> <b>13</b> <b>14</b> <b>15</b> <b>15</b> <b>16</b> <b>16</b> <b>16</b> <b>16</b> <b>16</b> <b>16</b> <b>16</b> <b>16</b>
2010	14 (15) 16 173 18 (c) OpenStreetMap and
242600	Commons-Share Alke
00202	Legend
3-11	BBS/WWO kurvey boundary (250 m buffer, supplied 20140420, plus 250 m buffer of protroiding access track
01717	supplied 20150917)
223.4	Greater Dublin Drainage
8 22	Breeding/winter bird survey
2 000012	Page 2 of 18
2 00 A	0 200 m
	Scale 17,500(6A)
061	Drawme CH Cherkers, DRAFT, Approved, DRAFT Fride Nassaal und 11% of 2000 5. Openials - Man concerned as Reproduced, remove Orbitals Savay Of Infanding Ferreinse of the Savantaisers, concernal as 1974

magraup.com





w 2008/2017 KIS bellet Work Fig.Pfs Createlygy: echael/Kistle -Olifeumwerkerer 2009\_005/cm\_\_2 - 500.00 mm]

1	RPS
8°*0	
242 00	Surveyor. Nick Veale
(4)/20	Date: 2.7 11 2015
	Start time: 08 3. End time: 14'3.
045196	Notes:
005 ET	Truets Split over
X406	Travets Split over MARS 1,2, +9
105.17	
24/200	
54 4 L	- Charles Andrews
361:00	
14 200	14 (15) 16 17 18 (c) OpenStreetMap and
8	Contributors, Creative Commons-Share Alike
VX 17	Legend
2+0800	BBS/WWO survey boundary (250 m buffer, supplied 20: 40420, pros 250 m buffer of protruding access track
7324	supplied 20150917)
2+620	Greater Dublin Drainage
01904	Breeding/winter bird survey
	Page 9 of 18
005061	0 200 m
0.017	Srate 17,500 @A3
346500	Date: 20/10/2015         Job No. SEC7909         Rev: Ib           Drawn: C11         Checked DRAFT         Approved DRAFT           vib Nerseal Unit 850, 2000         Provide Checked DRAFT         Approved DRAFT           Provide Checked DRAFT         Second Unit 850, 2000         Second Unit 850, 2000         Second Unit 850, 2000           Provide Checked DRAFT         Second Unit 850, 

# **APPENDIX 4**

# WINTER 2017 (MARCH)

The data from the March 2017 winter walkover surveys were mapped, and are enclosed below (along with the associated survey recording sheets).

RPS	W	eather Sh	seet	Wind	Speed Beav	kont Mich	Direction	Rain/S	inow	C	buol		Cloud Height	Visibility	-
Site	6	.00		Caim Light a	0 jr 1	>1	N NE	None Drizzle/	0		oightha		Height of cloud above average	Poor (< livin)	0
Date		003/2	017	Light b		4-7	E	Light of	Kowers 2	2	.g. 3/8		height of viewshed	Moderate (1-3km) Good (>3km)	1
Survey		J. Alter La		Mod. la	reeze 4	13-18	8	Heavy r		4			<150m ()		
Observer		J. Verl		Strong	breeze 5 breeze 6		SW W	Lying	Snow	F	rost		150-500m 1 >500m 2		
Start Tim	e	07:15		Mod. g Fresh			NW	None On site	a		one	a		urate as an able	
Finish Tir		15:00		Strong	gale 9	47-54	i	High gr	zundi 2		raund I day	2	weather details, e	rate as possible. «	i lüh Kulinê
Sheet 1/		Maps atta	ched	Storm	Ť 1	1 64-72							not a range, e.g. V Ute notes for axir E.g. WS - 5, gustk	A Into.	
Weather	Wind speed	Wind direction	Rain	Cloud cover	Cloud height	Visibility	Frost	Snow	Notes(e.	g. te	mpera	tlure		eg er finn renangt.	_
Hr 1 7:15	3	50	0	6/8	2	2	_	-	(0° -						_
12 8:15	2	SE	101	8/8	2	2		-	light	d	rizzla	-			_
Hr 3 9/15	3	SE		1/8	2	2		_	light	-	Azele				-
1r 4 10:15	3	SE	Ö	8/8	2	2	-	-	1220						_
Ir 5 11-15	3	SE	0	1/8	2	2		_	122						_
1612:15	3	SE	σ	7/8	2	Z			1+						_
Hr 71215	3	SR	Ð	1/8	Z	2		-	1406			-			_
1 81415	4	SIE	0	218	2	2		-		-		-			_
Field Notes: Meps all															
or office use vitial <u>AND</u> da oxez.	only. MB ate <u>ALL</u>	Logged		Databas	se Entere	I DA	tabase Vi	alidated	GIS	Ente	bered	-	GIS Valid	dated	_

RPS	w	eather Sh	eet	Wind	Speed Beau	lon Mob	Direction	Rain/S	now	Cloud Cover	Cloud Height	Vialbility
Síte	1	500	-	Calm	0	21	N	None	0	in eighthe	Height of cloud above average	Poer (<1km) g
Date		7/03/2	17	Light a Light b	reeze 2		NE E	Drizzle/	ówrens 2	8.9.3/8	height of	Noderale (1-3km) 1 Good (>3km) 2
Survey		3,-12 -	_	Mod. b			SE S	Heavy : Heavy r	ain 4		vavished <150m ()	and brand t
Observer		lin Ve	10 A		breaza 5 breaza 6		SW W	Lying		Front	150-500m 1	
Start Time		olco	cla	Mod. g Fresh	ale 7	32-38	NW	None	0	None 0	>500m 2	
Finish Tin				Sirong	gale 9	47-54		On site High gro	1 1,000 2	Ground 1 Aliday 2	weather details, en	rate as possible, with ntering only one figure
		6415		Storm	gale 1 1						not a range, e.g. V Use notes for extra	VS - 5, not 5-6
Sheet 1/	-	Maps atta		Hunica							E.g. WS - 5, gustin	ngi 6 [in noles].
Weather	Wind speed	Wind direction	Rain	Cloud cover	Cloud height	Visibility	Frost	Snow	Notes(e.g.	temperatu	re)	
Hr 1(0:00	2	ENE	0	418	2	2		-	10°C			
Hr 241.95	2	E	0	3/8	7	2		_				
Hr 31240	2	Ē	0	3/8	2	2		-				
Hr 413:59	3	e	O	3/8	2	7			1200			
Hr54∉as	3	ENE	0	218	2	r		~		-		
Hr 615:58	3	NZ	0	4/8	2	2		_	1200			
Hr 716c	3	NE	0	418	2	2		_	11 " C			
Hr B									11 2			
Field Notes: Meps all:	ached											
for office use nitial <u>AND</u> da paxes.	only. NB- ite <u>ALL</u>	Logged		Databas	e Entere	nd Da	tabase V	alidated	GISE	hered	GIS Valio	lated

. . . .

RPS	W	eather Sh	eet	Wind :	Speed Beauto	ort Moh	Direction	Rain/Sr	ю₩	Cloud Cover		Cloud Height Height of cloud	Visibility
Site	1	00		Calni LioMiai	r 1	>1 1-3	N NE	None Drizzlevi	d Misi 1	in eignthe e.g. 3/8		above average	Poor (<1km) 0 Moderate (1-3km)
Date	2	1	17	Light br		4.7 8-12	ESE	Light six Heavy s	owers 2			height of viewshed	Good (>3km)
Survey		inter Li		Mod. In	9828 <b>4</b>	13-18	s	Heavy re	awi 4			<150m 0	
Observer		. Vede	<u>~</u> .	Fresh b Strang		19-24 25-31	5W W	Lying 5	Show	Frost		150-500m 1 ⊳500m 2	
				Mod. ge Fresh g	ale 7	32-38 39-46	NW	None On eite	0	None Ground	<u>e</u>	Please be as accu	urate as possible, with
Start Time		15		Strong	gale 9	47-54		High gro	und 2	All day	2	weather details, e not a range, e.g. V	ritering only one ligure
Finish Tid		100		Whole Storm	gaka 10 11							Lipp notes for exir	a into.
Sheet 1/	&[]	Maps atta	ched	Hurnca	ne la		-				_	E.g. WS - 5. gusti	ng o (in no <del>les</del> ).
Weather	Wind speed	Wind direction	Rain	Cloud cover	Cloud height	Visibility	Frost	Snow	Notes(e.g	. tempera	aure	9)	
Hr 1 July S	Ъ	ENR	2	8/8	2	2			8%		_		
Hr 212 <sup>1</sup> 15	3	ENE	0	10	\$P +	2					_		
Hr 3 <i>1345</i>	3	E	0	- 0	tt.	2			10%				
Hr 4 Mis	3	e	1	7/8	A	1							
Hr 56015	3	NE	Ø	718		2	-		10 ° C				
Hr6#'rs	3	E	0	7/8	ы	2							
Hr 71715	3	E	0	018	4	2		-	11°C		_		
Hr S	3	E		0/8	- 14	2							
Field Notes Maps ell													
For office us Initial <u>AND</u> d bokes.		· Logged	-	Databa	se Enten	ed D	alabase f	/alidated	t GIS	Enlered		GIS Va	lidaled

1 N N N N


÷ 1


RPS Site Date Survey Observer Start Tim Finish Tin Sheet 1/	e C	leather Sh 203/20 203/20 203/20 1. 10 1. 10 1	ы7 .0	Calm Light s Genits Mod. b Fresh i Stong Mod. g Fresh i Strong Whole Storm	vaaze 2 breeze 3 breeze 4 breeze 6 breeze 6 jale 7 jale 9 gale 9 gale 1	) 51 1-3 4-7 8-12 13-18 19-24 25-31 39-46 47-54 0 55-63 1 64-72	Ofrection NE E SE SW W NW	RainvS None Drizzle/ Light sh Heavy r Heavy r Lying S None On sile High gro	D Misi 1 www.s 2 showers 3 rain 4 Snow 0 1	Cloud Cover In eighths <i>e.g.</i> 33 Fraet None 0 Ground 1 All day 2	not a range, e.g. V Use notes for extra	a info.
Weather	Wind	Wind	Rain	Cloud	Cloud	2 79+ Visibility	Frost	Snow	Notes(e.g.	. temperatu	E.g. WS - 5, gustin re)	нд 6 (ил лоная).
Hr 16 22	speed 4	direction	0	COVer 210	height						.,	
Hr 27.20	4	N	1	7/8 8/8	2	4	1	0	I <sup>®</sup> ⊂			
Hr 38 20	4	่่่∧้€		01.5	2	_	0	0	2°2			
Hr 4 4 30	4	NE	2	11	2		0	_	you			
Hr 5 (à. 22	3	NE	3	P	2	1	0	0	400			
Hr 6 <del>(f.Z</del> a	3	NE	2		2		0	-	S°C S°C			
Hr 7(1:20	4	NE	2	- 10	2	-		0	590			
Hr 8(3:22	4	NE	3	41	2	1	0	0	Sac	_		
Field Notes: Maps with												
or office use	only. NB-	Logged		Databas	se Entere	d Da	labase Va	alidated	GISE	ntered	GIS Valid	alad

RPS Weather Sh Site GOD		eet	Wind	ion Moh	Direction Rain/S		now	Cloud Cover In eighths e.g. 3/8	Cloud Heighi Visibility Height of cloud above everage Neight of Moderate (1-3km) 1	Visibility		
		-00		Cabra 0 >t Ughla⊯r 1 1-3			N NE			None 0 Drizzla/Mist 1		
Date	2	21/03/2017			Light breeze 2 4-7 Genile breeze 3 8-12			Light showers 2 Hoavy showers 3 Heavy rain 4 Lying Snow			height of viewshed Good (>3km) ( <150m 0 150-500m 1 >500m 2	
Survey	Nin Vede			Mod. breeze 4 13-18 Frosh breeze 5 19-24 Strong breeze 5 25-31			-16 S -24 SW -31 W					
Observer												
Start Tim	e C	07:50			jale 8		89-46	None 0 On site 1		None D Ground 1	Please be as accurate as possible, with	
Finish Time 14:30			Strong gale 9 47-54 Whole gale 10 55-53				High ground 2		All day 2	not a range, e.g. WS - 5, not 5-6.		
Sheet 1/	&[]	Maps atta	sched	Storm Hurrica	1				9		Use notes for ear E.g. WS - 5, grate	a Into.
Weather	Wind speed	Wind direction	Rain	Cloud cover	Cloud height	Visibility	Frost	Snow	Notes(e.g.	lemperatu		
Hr 1 67 Sc	3	L	0	648	2	1	I	1	-12			
Hr 20854	4	LJ .	2	718	2	1	1	4	- )°C	SNOW SHOWERS		
Hr 309:30	4	L.	0	7/8	2	1	0	0	0"4			
Hr 4 (0.150	4	L)	$\mathcal{O}$	6/8	2	2	0	0	2 20			
Hr 5 II: 50	44	W	2	7/8	2	1	0	0	2.0	(SLee	+)	
Hr 6 17\\$	3	512	0	5/8	2	2	Ð	0				
Hr 7 13:50	3	دىك	0	5/8	2	2	0	0	4°C			
Hr 8 Field Notes:	3	ى ب	0	5/8	2	2						
Maps att												,
For office use only. NB- milel <u>AND</u> date <u>ALL</u> boxes.		Logged		Database Entered Da			tabase V	alidated	AIS E	GIS Entered		dated


RPS	V	eather Sh	ree	Wind	Speed Begu	kon: Moh	Direction	Rain/S	now	Cloud Gover	Cloud Height	Visibility
Site	0	500		Calm Light a	0		N NE	None	0	In eignths	Height of cloud above average	Poor (-c1km) D
Date		03/2017	7	Lightb	reeze 2	4-7	E	Drizzle/ Light sh	KOWYEITE 2	0.9.38	height of viewshad	Modelate (1-3km) 1 Good (>3km) 2
Survey			1.0	Mod, b	19929 4	13-18	S€ S	Heavy a	showers 3 ain 4		<150m 0	
Observer	N	, Veile			breeze 6		SW W	Lying	Snow	Frost	150-500m 1 >500m 2	
Start Tim	ec	7.30		Mod. g Fresh (			NW	None On site	0	None 0 Ground a		rate as possible, with
Finish Tir	ne /	5.30		Strong Whole	pale 9	47-54		High gro		All day 2	weather details, er not a range, e.g. V	ntering only one liture.
Sheet 1/		Maps atta	ched	Storm	Č 1	1 64-72					Use notes for extra E.g. WS - S, gustin	a info.
Weather	Wind speed	Wind direction	Rain	Cloud cover	Cloud height	Visibility	Frost	Snow	Notes(e.g	l temperatu		-y o (in noise).
Hr 17:30	4	W	0	7/8	2	2		-	700			
Hr 2 8: 50	4	ŵ	0	8/8	2	2		-				
Hr 3 9! 30	4	قرا	2	8/8	2	1		-	900			
Hr 4 10 3 v	4	L L	0	818	2	2						
1511.30	4	N	0	818	2	Z	_		100 4			
Ir 6 17:54	4	لکر	0	818	2	2		_		- Thirty -		
Hr 7 13:30	4	50	2	818	2	1		-	10 ° C			
Ir 8 4-30	4	SW	2	8/8	2	1		_	-			
Field Notes: Meps all:												
or office use Idel <u>AND</u> de pres.	only, NB ite <u>ALL</u>	Logged		Databas	ië Entere	d Da	itabase Va	alidated	GISE	Entered	GIS Valio	laled

1.10

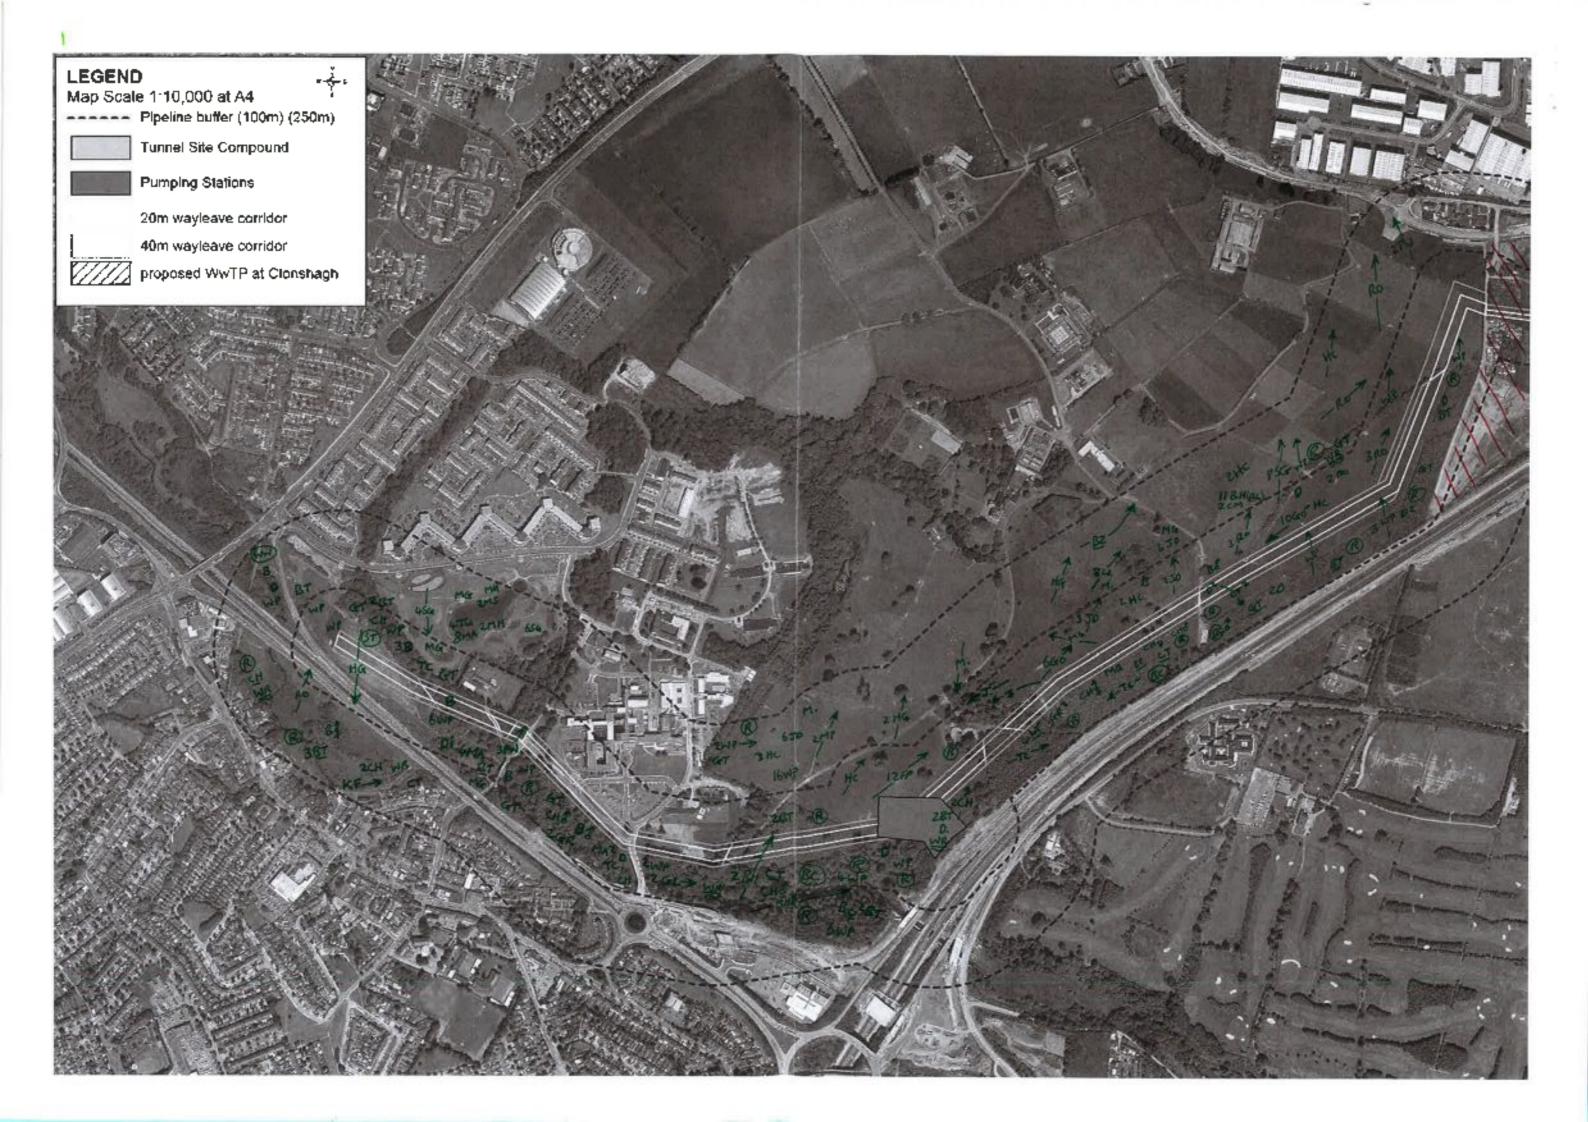


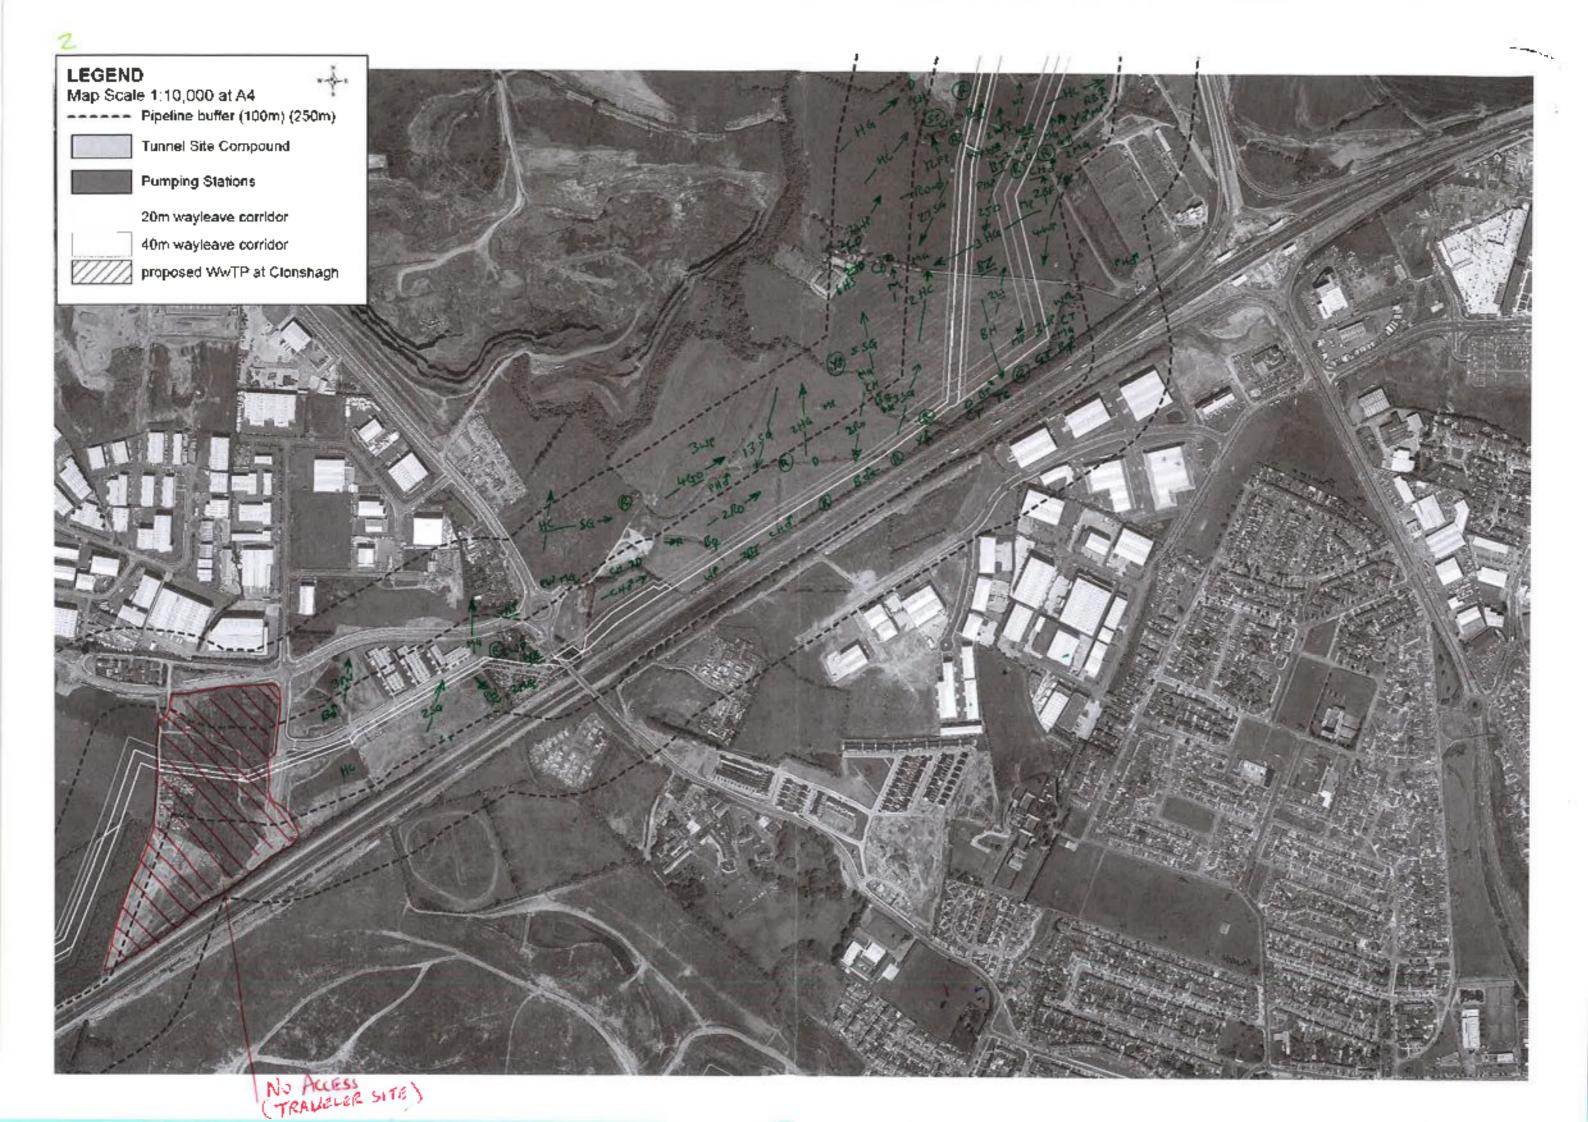




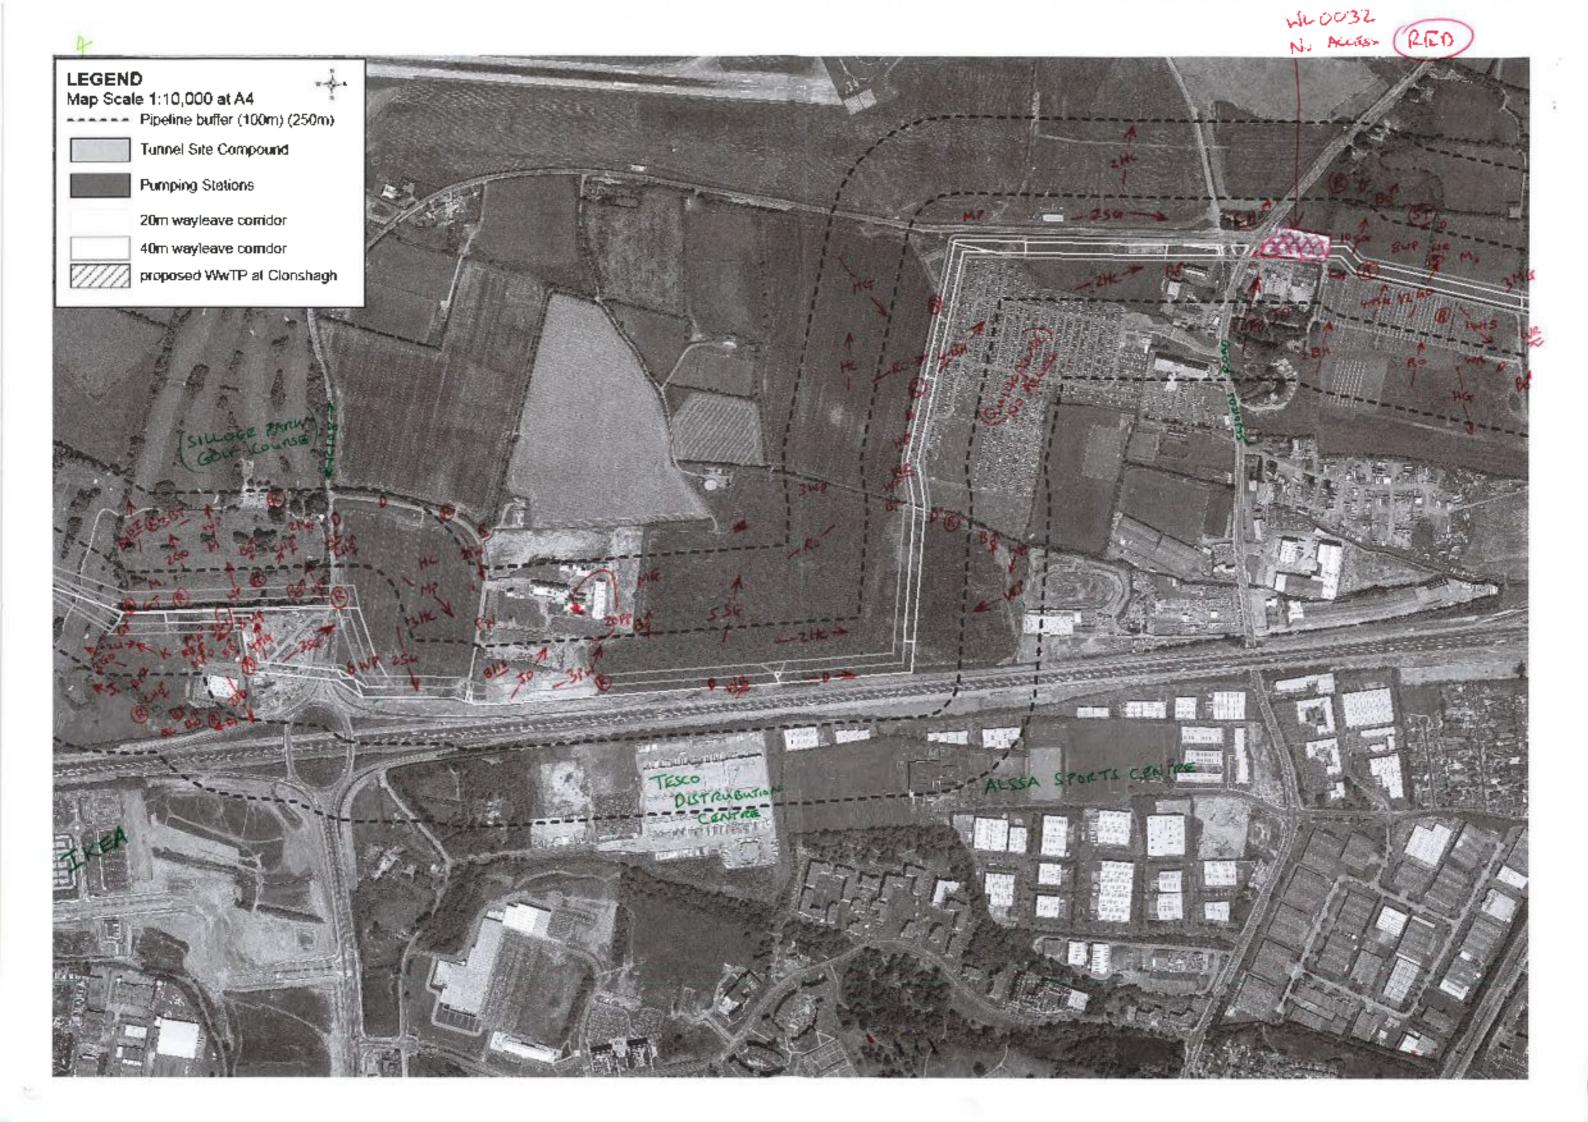



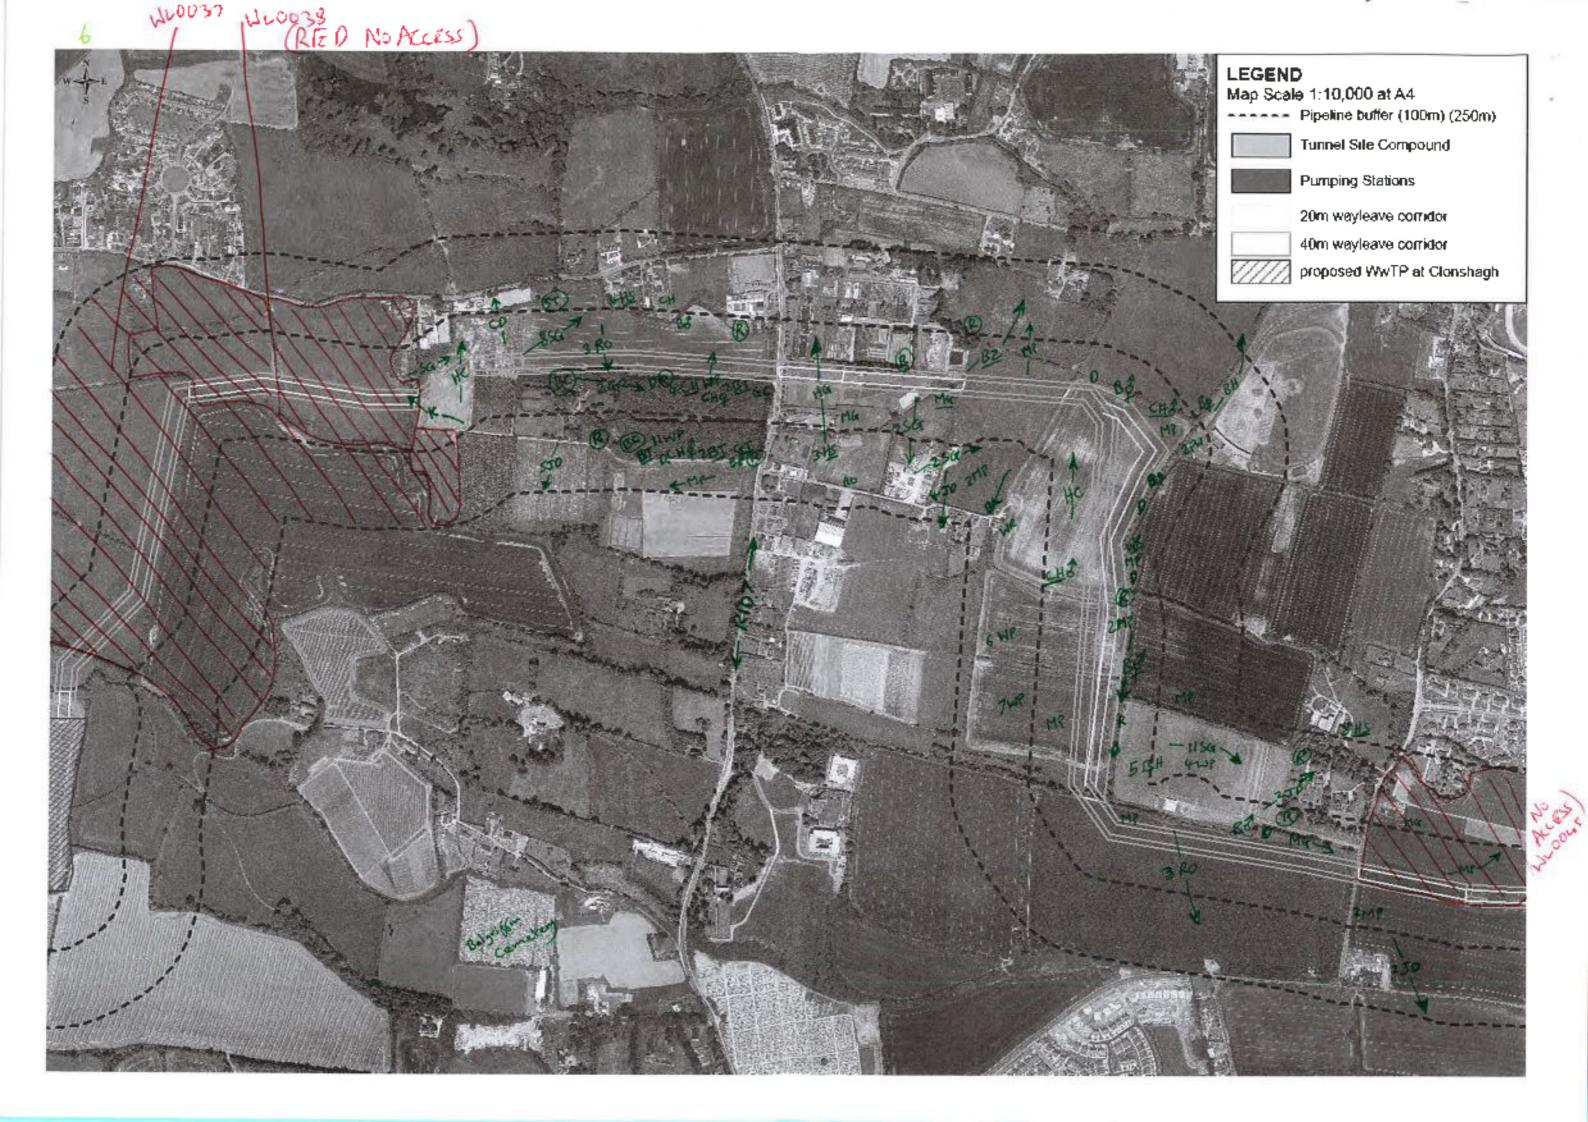



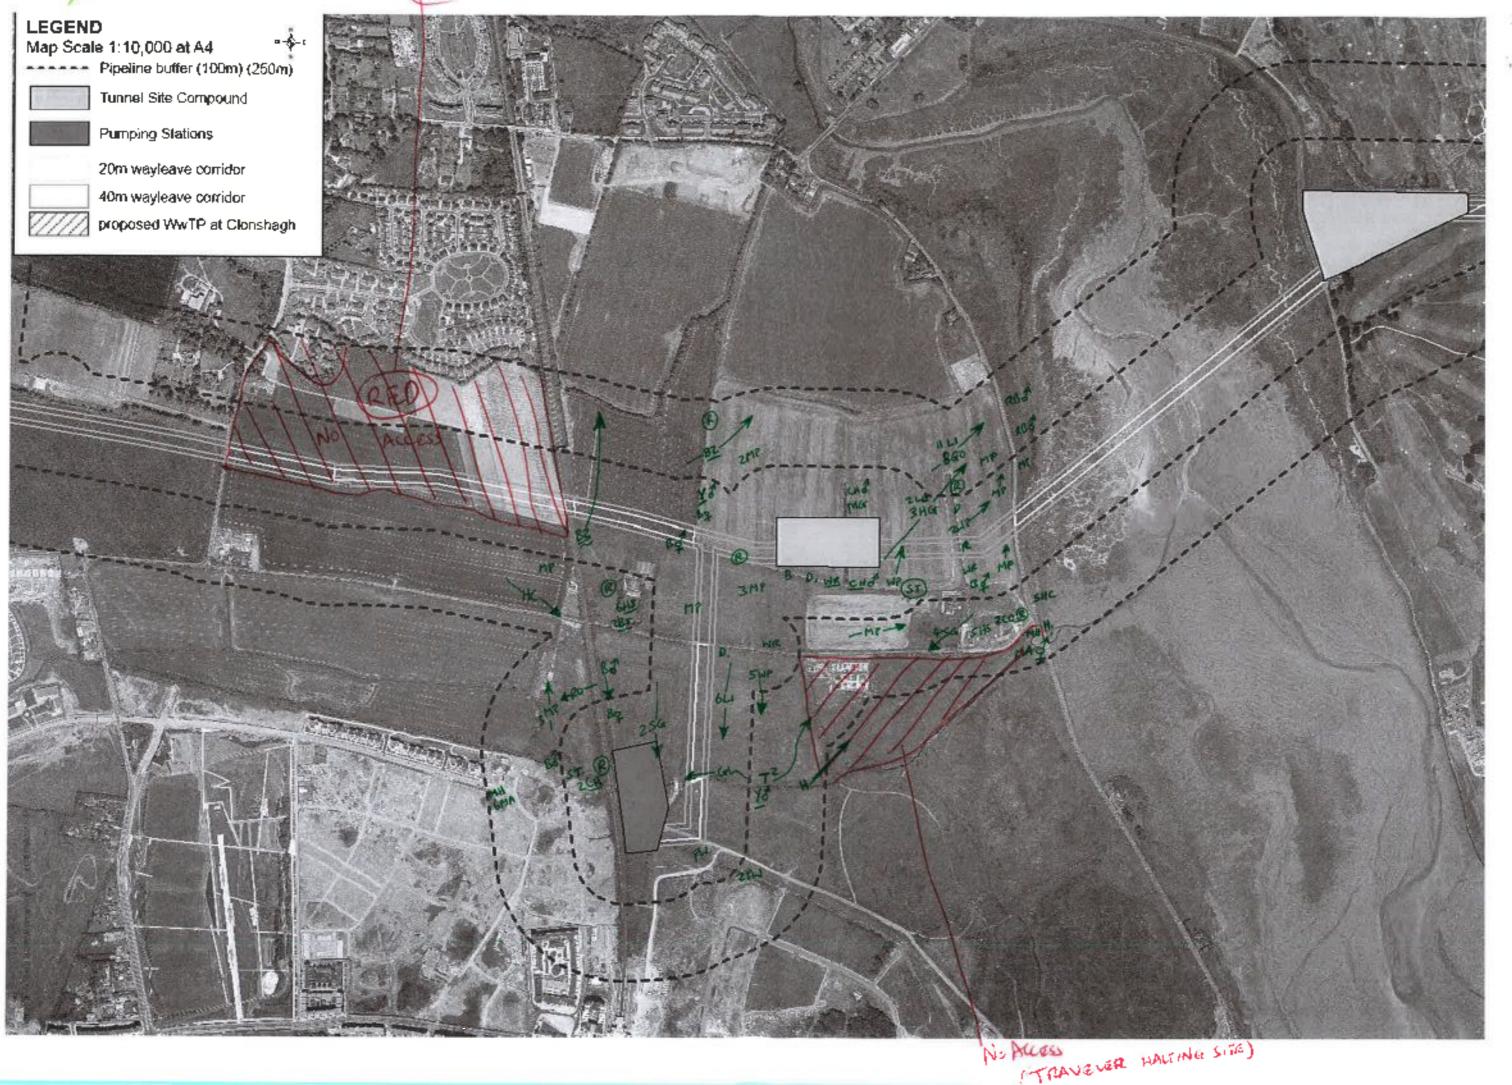




## GDD Oral Hearing Response to Inspector's Questions

## APPENDIX 5 WIN1

WINTER 2017 (NOVEMBER)

The data from the November 2017 winter walkover surveys were mapped, and are enclosed below (along with the associated survey recording sheets).

RPS Site Date Survey Observer	6	eather Shi DD 111 17 110 Newb	et	Wind S Calm Light ai Light br Gentle Mod. br Fresh b Strong	Beauk 0 r 1 eeze 2 breeze 3 reeze 4 ireeze 5	ort Mph >1 1-3 4-7 8-12 13-18 19-24 25-31	Direction N NE E SE S SW W	Rain/Sr None Drizzle/M Light sho Heavy si Heavy ra Lying S	0 Aist 1 owers 2 howers 3 ain 4	Cloud Cover In eighths e.g. 3/8 Frost	Cloud Height Height of cloud above average height of viewshed <150m 0 150-500m 1 >500m 2	Visibility Poor (<1km) 0 Moderate (1-3km) 1 Good (>3km) 2
Start Time Finish Tin Sheet 1/	e O ne la	8:.\0 5:20 Maps atta	ched	Mod. gr Fresh g Strong Whole Storm Hurrica	ale 7 jale 8 gale 9 gale 10 1	32-38 39-46 47-54 0 55-63 1 64-72	NW	None On site High gro	0 1 und 2	None 0 Ground 1 All day 2	Please be as acc	a info.
Weather	Wind	Wind direction	Rain	Cloud	Cloud height	Visibility	Frost	Snow	Notes(e.g	i. temperatu	ire)	
Hr 1	speed 4	SW	0	S/8	Z	2	1	_	220			
Hr 2	4	SW	0	418	2	2	0	-				
Hr 3	3	SU	0	618	2	2	0	-	1			
Hr 4	3	Sw	0	618	2	2	0	/	4°C			
Hr 5	4	Sw	2	6/8	1	2	0	-				
Hr 6	4	SU	2	518	2	2	0	-				
Hr 7	3	SW	2	618	1	2	0	-				
Hr 8	4	SW	0	5/8	2	2	0	/	9°C		1997 - San Colombia (1997 - 1997)	
Field Notes Maps at												
For office us Initial <u>AND</u> of boxes.	ie only. Ni late <u>ALL</u>	- Logged	1	Databa	ise Enter	ed D	atabase \	Validated	i GIS	Entered	GIS Va	idated

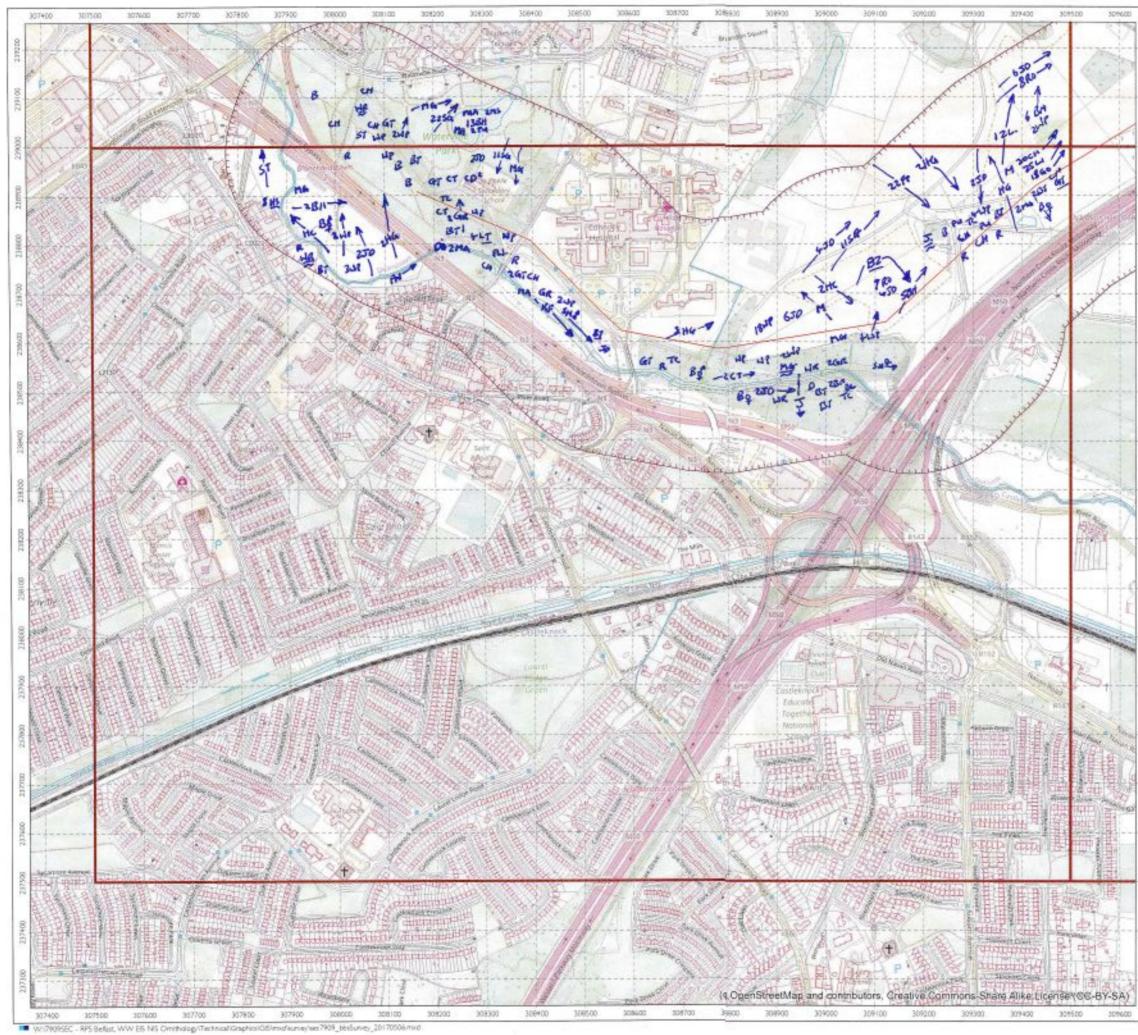

surveyor: N	ich Ved	e	
Date: 08	ich Vede (11) 2017		
Start time:	End t		



Legend

BBS/WWO survey boundary (250 m buffer of route supplied 20170405 appended to previous boundary)

- Pipe route (supplied 20170405)

Greater Dublin Drainage


Breeding/winter bird survey

Page 17 of 18

0	200 m	. 1
Scale: 197.	00 @A3	**
Date: 06/04/20	17 Job No: SEC7909	Rev: c
Drawn: CH	Checked: DRAFT	Approved: DRAFT
	PSG 19902 Intribution: Reproduced from the oversiment. License No. 3-3-34	Ordnance Survey Of Instand by

rpsgroup.com

11

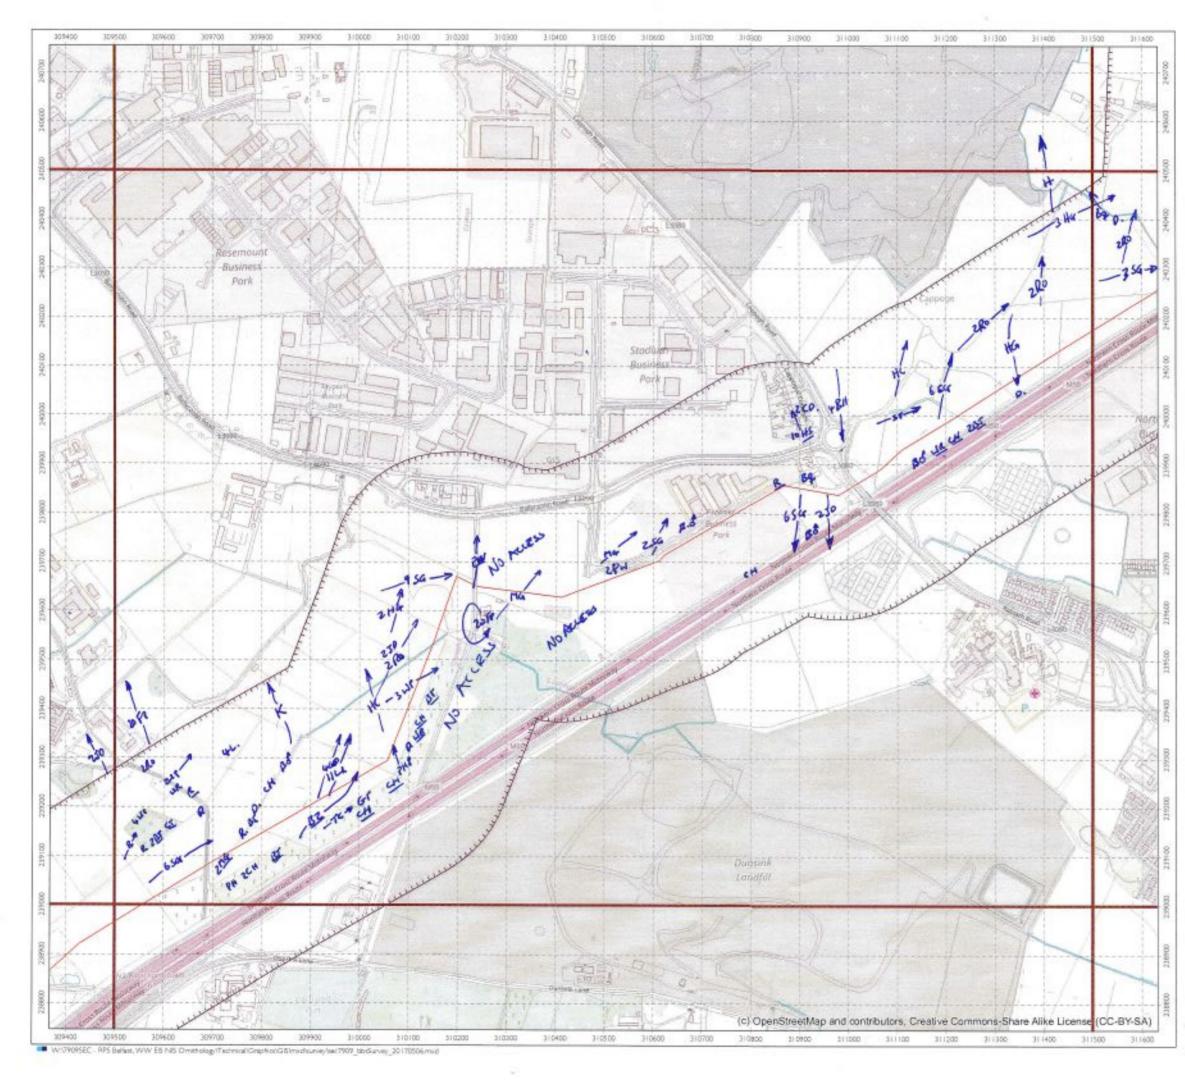

Surveyor: N.ch	
Date: 8 11 2	27 + 9/11/2017
Start time:	End time:
*Please attach wea Notes:	ther sheet
-103	Macanica M
A	
6 7	Baser Hill
19 A	1 2 3 4 5

BB5/WWO survey boundary (250 m buffer of route supplied 20170405 appended to previous boundary)

- Pipe route (supplied 20170405)

Greater Dublin Drainage


Breeding/winter bird survey

Page 15 of 18

Insh National Grid, EPSG 29902 * OpenStreet/Vac contributors, Reproduced from the Ordnance Survey Of Ireland by							
Drawn: CH	Checked: DRAFT	Approved: DRAFT					
Date: 06/04/2017	Job No: SEC7909	Rev: c					
Scale: 1:7,500	6AJ	~					
ī		1					
0	200 m						

mos.quorgeq1

RPS	w	eather She	eet	Wind 9	Speed Beaut	ort Mph	Direction	Rain/S	now	Cloud Cover	Cloud Height Height of cloud	Visibility
Site Date	Date 9 11/17			Calm         0         >1           Light air         1         1-3           Light breeze         2         4-7           Gentle breeze         3         8-12           Mod. breeze         4         13-18			N None NE Drizzle/M E Light shot SE Heavy sh S Heavy rai		owers 2 howers 3	In eighths e.g. 3/8	above average height of viewshed	Poor (<1km) 0 Moderate (1-3km) 1 Good (>3km) 2
Survey		A CONTRACTOR OF THE OWNER		Fresh b	preeze 5	19-24	SW	Lying		Frost	<150m 0 150-500m 1	
Observer	N	in Veal	e	Strong Mod. ga		25-31 32-38	W NW	None 0		None 0	>500m 2	
Concession of the local data and		8:30	Fresh gale 8 39-46 Strong gale 9 47-54				On site 1 High ground 2		Ground 1 All day 2	Please be as accurate as possible, with weather details, entering only one figure		
		5: 30		Whole gale 10 55-6		55-63		rigi grouna z		Au day 2	not a range. e.g. WS - 5, not 5-6. Use notes for extra info.	
Sheet 1/	&[]	Maps atta	ched	Storm Hurrica	ne 1:	No. 1977. A 67 1					E.g. WS - 5, gusti	
Weather	Wind speed	Wind direction	Rain	Cloud	Cloud height	Visibility	Frost	Snow	Notes(e.g	. temperatu	ire)	
Hr 1	5	NU	1	8/8	1	2	-	_	82			
Hr 2	4	W	1	818	1	2	-	_				
Hr 3	4	W	0	6/8	1	2	-	_				
Hr 4	4	NU	0	6/8	2	2	-		11°C			
Hr 5	4	NW	0	6/8	2	2		_				
Hr 6	4	NW	0	SIS	2	Z		-				
Hr 7	5	W	0	3/8	2	2	-	_	11°C			
Hr 8	5	W	0	3/8	2	2		_				
Field Notes Maps att												
For office us Initial <u>AND</u> d	e only. NB ate <u>ALL</u>	- Logged		Databa	se Enter	ed D	atabase \	/alidated	GIS	Entered	GIS Val	idated

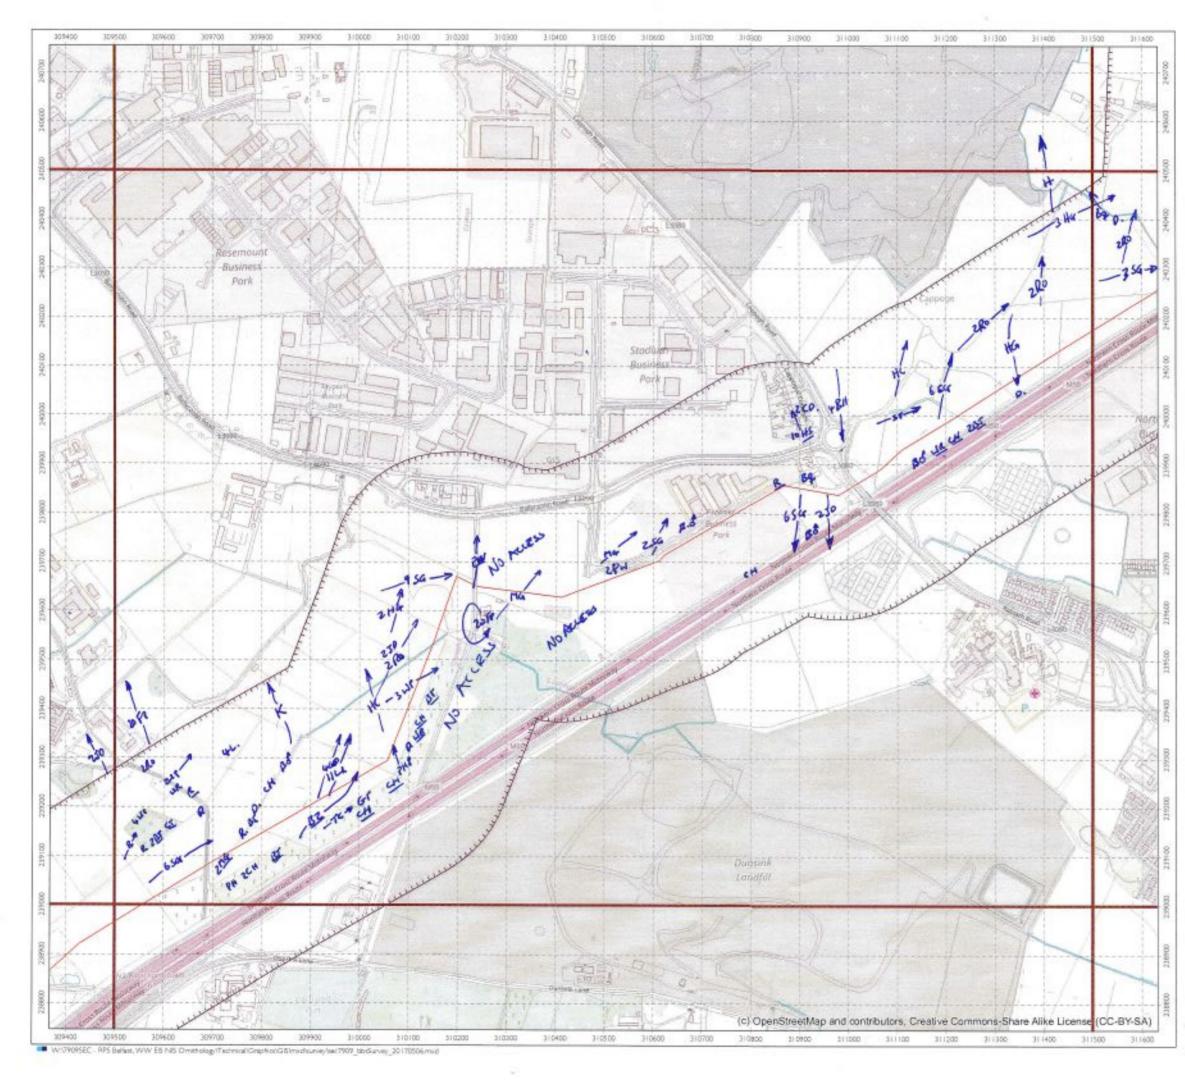

Surveyor: N.ch	
Date: 8 11 2	27 + 9/11/2017
Start time:	End time:
*Please attach wea Notes:	ther sheet
-103	Macanica M
A	
6 7	Baser Hill
19 A	1 2 3 4 5

BB5/WWO survey boundary (250 m buffer of route supplied 20170405 appended to previous boundary)

- Pipe route (supplied 20170405)


Greater Dublin Drainage

Breeding/winter bird survey

Page 15 of 18

Insh National Grid, EPSG 29902 * OpenStreet/Vac contributors, Reproduced from the Ordnance Survey Of Ireland by							
Drawn: CH	Checked: DRAFT	Approved: DRAFT					
Date: 06/04/2017	Job No: SEC7909	Rev: c					
Scale: 1:7,500	6AJ	~					
ī		1					
0	200 m						

mos.quorgeq1

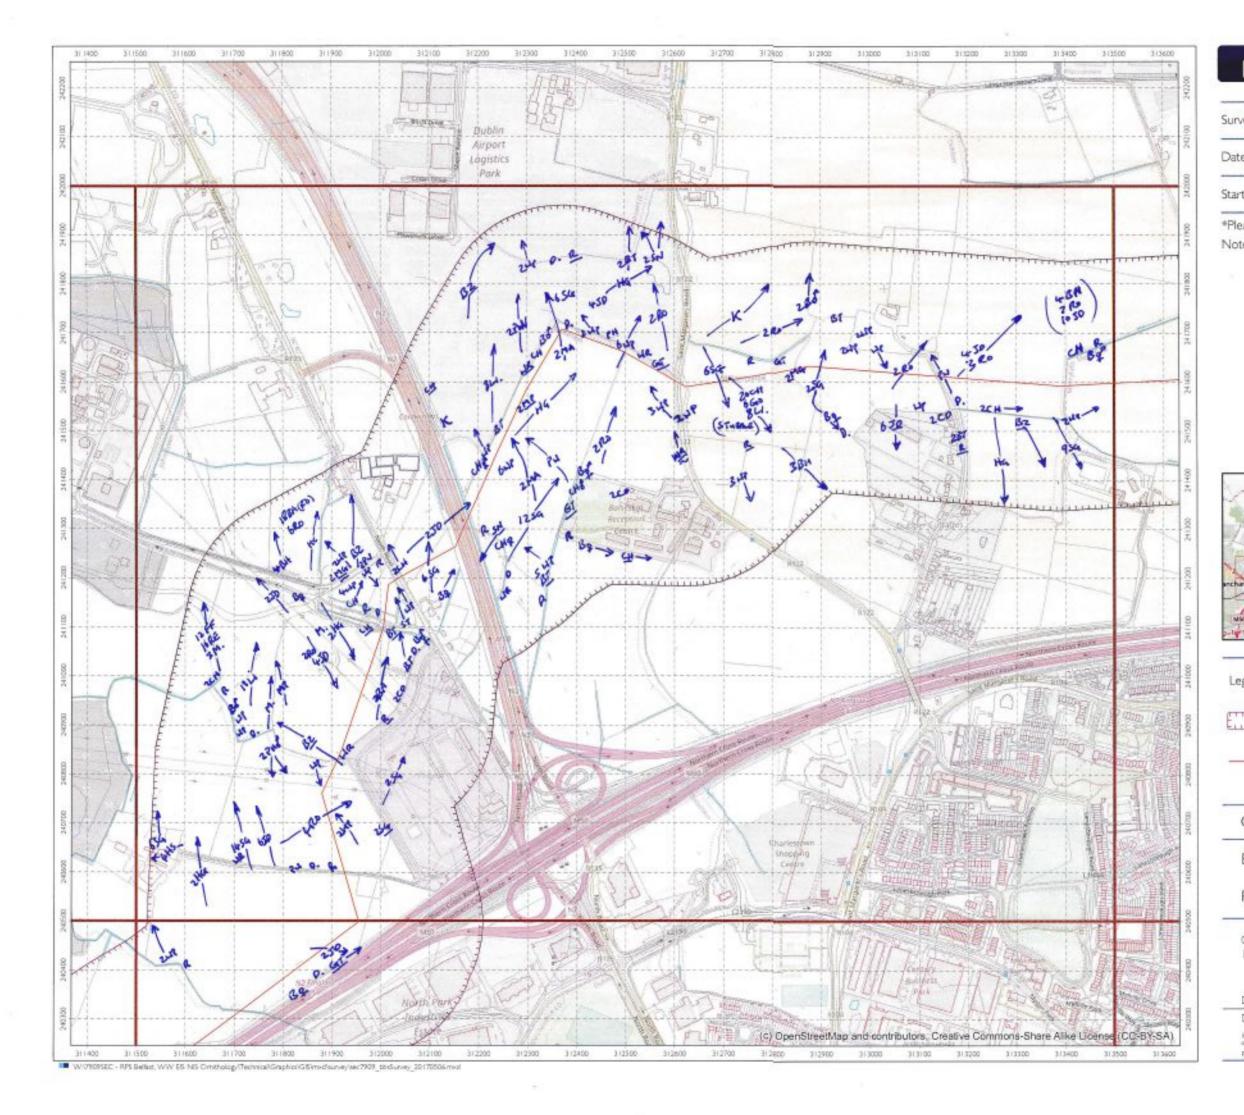

RPS

RPS	
urveyor: Nich	Vert
Date: 9/11/2	קובו
tart time:	End time:
Please attach wea lotes:	ther sheet
6 7. 14 15 16 17 18 17 18	Reference of the second
Legend	
buffer o appende	WO survey boundary (250 m f route supplied 20170405 ed to previous boundary) ite (supplied 20170405)
Greater Dub	olin Drainage
Breeding/wir	nter bird survey
Page 7 of 18	
Page 7 of 18	200 m


Iroh National Grid, EPSG 29902 © OpanStreetMap contribution: Reproduced from the Ordnance Survey Of Ireland by Remtacion of the Government License No. 3-3-34

Checked: DRAFT


Drawn: CH

rpagroup.com

Approved DRAFT

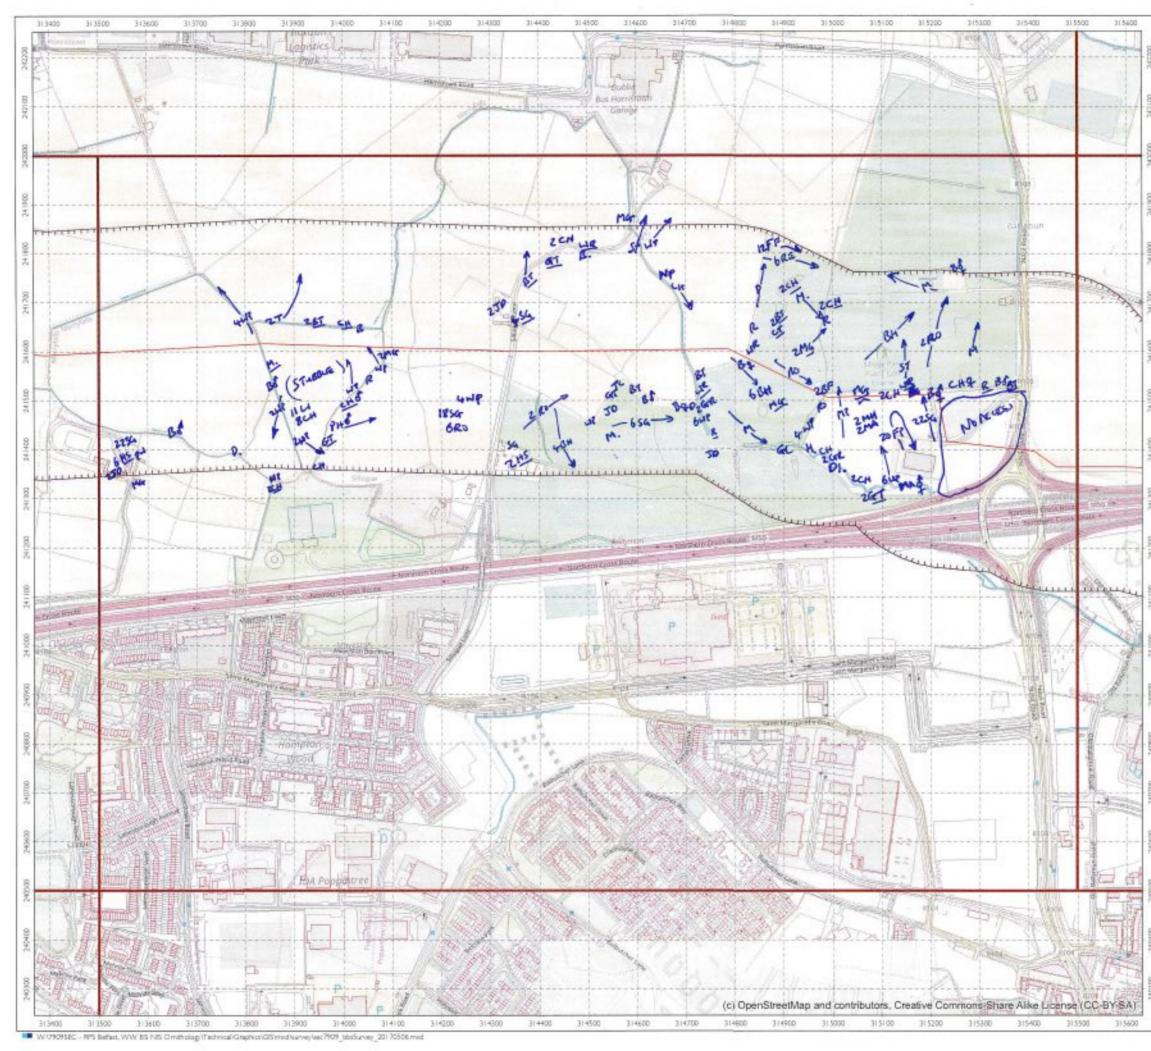

RPS		4
Surveyor: Nici	ved	
Date: 9/11)	17	
Start time:	End time:	

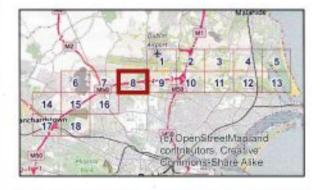

Legend

BBS/WWO survey boundary (250 m buffer of route supplied 20170405 appended to previous boundary)

Pipe route (supplied 20170405)

Greater Dublin Drainage


Breeding/winter bird survey

Page 8 of 18

	200 m	4
Scale: 1:7,500	®A3	
Date: 06/04/2017	Job No: SEC7909	Rev: c
Drawn: CH	Checked: DRAFT	Approved: DRAFT
	29902 buton: Reproduced from the C ment. License No. 3-3-34	Distrance Survey Of Initiand by


mos.quorgeqt

RPS Weather Sheet		Wind Speed Beautort Mph		Direction			Cloud Cover	Cloud Height Visibility Height of cloud Rest fuller					
Site Date Survey		500		Calm Light ai Light br Gentle Mod. br	eeze 2 breeze 3	1-3 4-7 8-12	N E SE S	None Drizzle/I Light sh Heavy s Heavy r	owers 2 howers 3	In eighths e.g. 3/8	above average height of viewshed	Poor (<1km) 0 Moderate (1-3km) 1 Good (>3km) 2	
Observer		WUO		Fresh b Strong	reeze 5	19-24	SW	Lying		Frost	150-500m 1		
Start Time		N. Vecce 08:40		Mod. ga	ale 7	32-38	NW	None 0 Opisite 1			>500m 2		
Finish Tin				Strong gale 9 47-5		47-54	4 Hig		On site 1 High ground 2		Please be as accurate as possible, with weather details, entering only one figure, not a range, e.g. WS - 5, not 5-6. Use notes for extra info. E.g. WS - 5, gusting 6 [in notes].		
Sheet 1/ & [		1.240		Storm									
Weather	Wind speed	Wind direction	Rain	Cloud cover	Cloud height	2 73+ Visibility	Frost	Snow	Notes(e.g	g. temperature)			
Hr 1	3	U	0	6/5	Z	2	1		1ºC				
Hr 2	4	W	2	5/8	2	2	0						
Hr 3	3	لك	0	7/8	2	2	6						
Hr 4	3	su	0	6/8	2	2	0		Soc				
Hr 5	3	SU	2	7/8	2	2	0						
Hr 6	3	Su	2	7/8	2	2	0						
Hr 7	4	sw	2	8/8	1	2	0		700				
Hr 8 Field Notes	4	SW	2	8/8	1	2	0		7°C				
Maps att													
For office us Initial <u>AND</u> d boxes.	e only. Në ate <u>ALL</u>	- Logged		Databa	se Enter	ed D	atabase \	/alidated	GIS	Entered	GIS Val	dated	

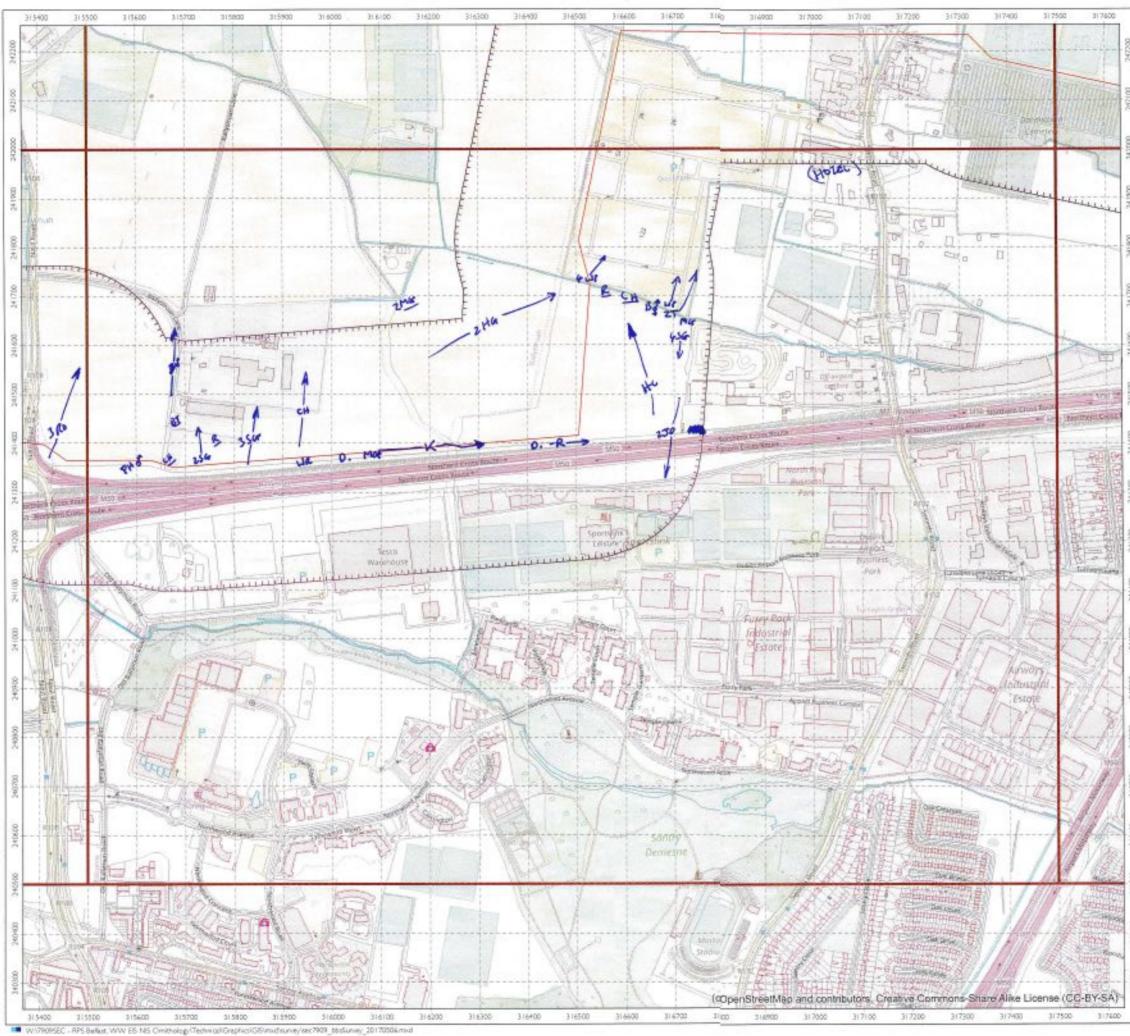

RPS	;
	-

iurveyor: N.1		
Date: 13/1	11/17	
Start time:	End time:	
Please attach wea	ther sheet	
Notes:		
T	I I KI	Marahide
X W	acer W	
MZ	+ 2	3 4 5
6 7	-8-1-9-10	11 12 13
Colorana Alta Child William rel Print		
MOR.		7.7
14 15 16		
MOR.	(Et OpenSife	eethagrand
14 15 16	(Et OpenSile contributors	eetMapland a. Creative
survey 3	eetMagrand s. Creative Share Alke any (250 m 170405 ndary) 2405)


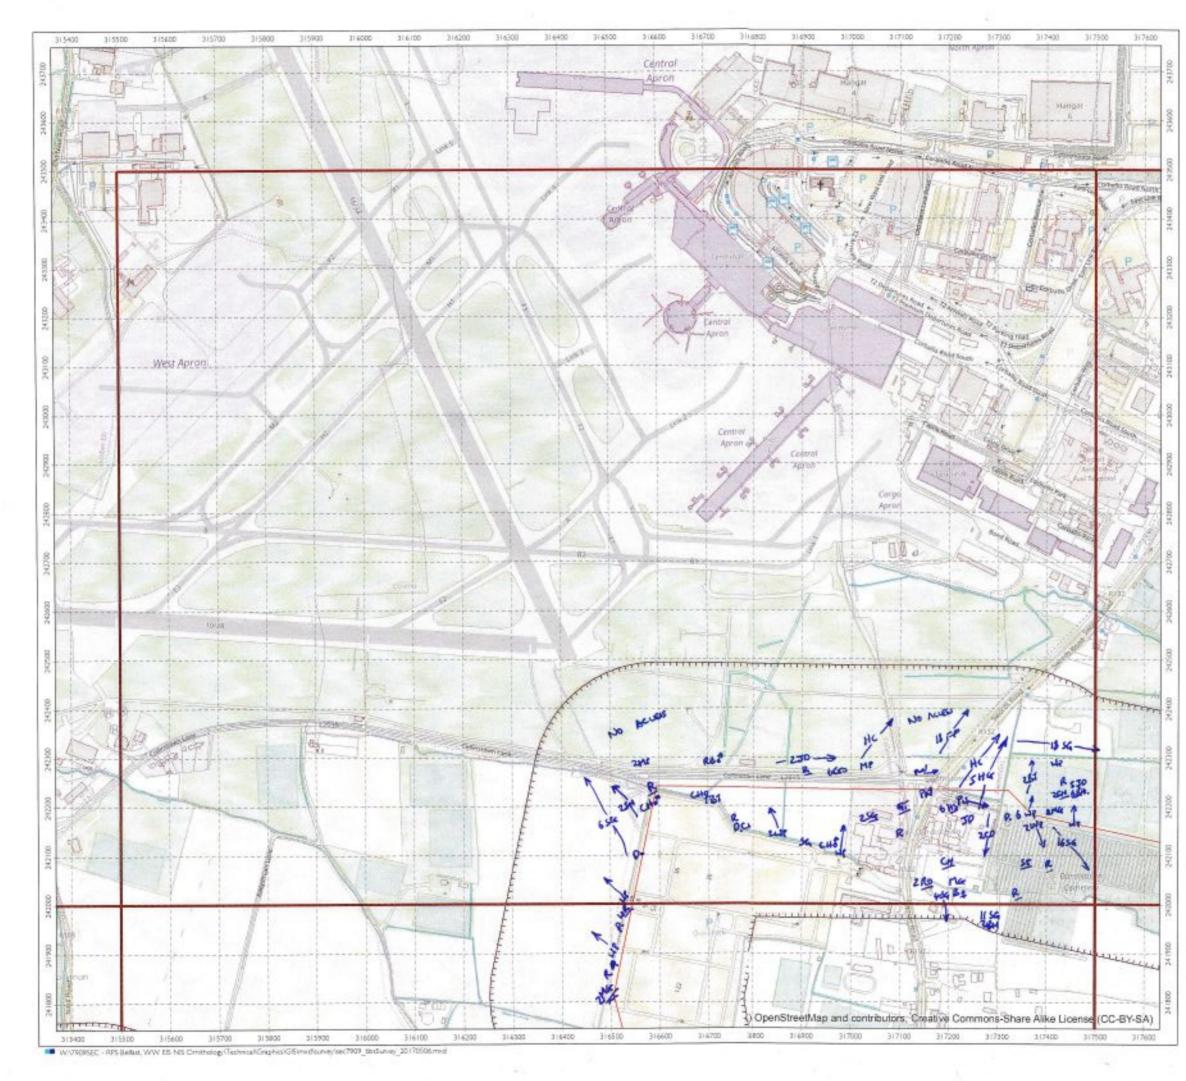


Surveyor: N.1	lecte			
Date: 13/	11/17			
Start time:	En	d time:		
*Please attach wea Notes:	ther sheet			
			Malarize ,	
19 M	1	2 3	4 5	1
6 7 14 15 16 17 18 17 18		0perSife Instators Instators	1 12 13 stMapians Creative	
Legend BBS/WV buffer of appende		DpenSifier triatitions himonasSi boundary lied 2017 us bound	1 12 13 etMapiane Creative are Alike (250 m 70405 lary)	

rpsgroup.com

The second secon



Surveyor: N.a	· Veal	
Date: 13/11	117	
Start time:	End time:	

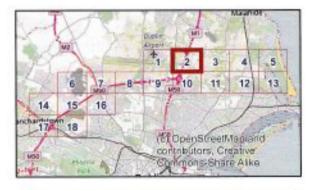

Legend

BBS/WWO survey boundary (250 m buffer of route supplied 20170405 appended to previous boundary)

Pipe route (supplied 20170405)

Greater Dublin Drainage

Breeding/winter bird survey

Page 2 of 18

	0 . L I	200 m	1
	Scale: 1:7,500	6A3	21
	Date: 06/04/2017	Job No: SEC7909	Rev: c
1	Drawn: CH	Checked DRAFT	Approved DRAFT
		29902 butors: Reproduced from the G	Orchence Survey Of Instand by

RPS Weather Sheet		eet	Wind \$	Speed Beauto	ort Mph	Direction	Rain/S	now		Cloud Cover		loud Height	Visibility		
Site		:00		Calm Light ai	0	>1 1-3	N NE	None Drizzle/			In eighths e.g. 3/8	ab	aight of cloud cove average	Poor (<1km) Moderate (1-3km)	0
Date		+11117		Light br Gentle	eeze 2	4-7 8-12	ESE	Light sh	the second se				viewshed of viewshed of viewshed	Good (>3km) 2	
Survey				Mod. br	eeze 4	13-18	S	Heavy r				-			
Observer		WHO		Fresh breeze 5 19-24 Strong breeze 6 25-31		19-24 25-31	SW W	Lying	Lying Snow	Frost		150-500m 1 >500m 2			
		Nich Veal		Mod. ga	ale 7	32-38	NW	None		_	None 0	Please be as accurate as possible, with			uith
Start Time		9:00		Fresh gale Strong gale		39-46 47-54		On site High ground	ound		Ground 1 All day 2	weather details, entering only one	ntering only one fig	Jure	
Finish Tin	ne	6:00		Whole Storm	gale 10			000000				not a range, e.g. WS - 5, not 5-6. Use notes for extra info.			
Sheet 1/	&[]	Maps atta	ched	Hurrica								E.g. WS - 5, gusting 6 [in notes].			
Weather	Wind speed	Wind direction	Rain	Cloud cover	Cloud height	Visibility	Frost	Snow	Notes(e	.g.	temperatu	ire)			
Hr 1	4	W	1	8/8	1	1	-	_	10%						
Hr 2	5	U	0	8/8	L	2									
Hr 3	5	SU	2	5/8	2	2	-								
Hr 4	4	SW	0	6/8	2	2	-		lic						
Hr 5	4	W	0	618	2	2	-		1						
Hr 6	4	SU	0	6/8	2	2									
Hr 7	4	SU	0	5/8	2	Z			12°C						
Hr 8	5	Sw	0	418	2	2									
Field Notes Maps at	-														
For office us Initial AND d		B- Logged	1	Databa	ise Enter	ed D	atabase '	Validate	d Gl	SE	intered		GIS Val	idated	_




RPS	
10.5	

Surveyor N. V	ech	
Date: 14/1	1/17	
Start time:	End time:	
		_

8

\*Please attach weather sheet Notes:

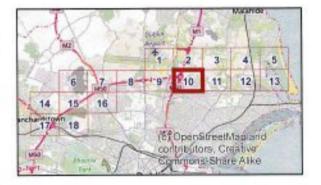

Legend

BBS/WWO survey boundary (250 m buffer of route supplied 20170405 appended to previous boundary)

Pipe route (supplied 20170405)


Greater Dublin Drainage

Breeding/winter bird survey

Page 10 of 18

0	200 m	4
Scale: 1:7,500	(@A3	**
Date: 06/04/2017	Job Na: SEC7909	Rev: c
Drawn: CH	Checked: DRAFT	Approved: DRAFT
	5 29963 vibutors: Reproduced from the I	Ordnance Survey Of Ineland by

resproup com

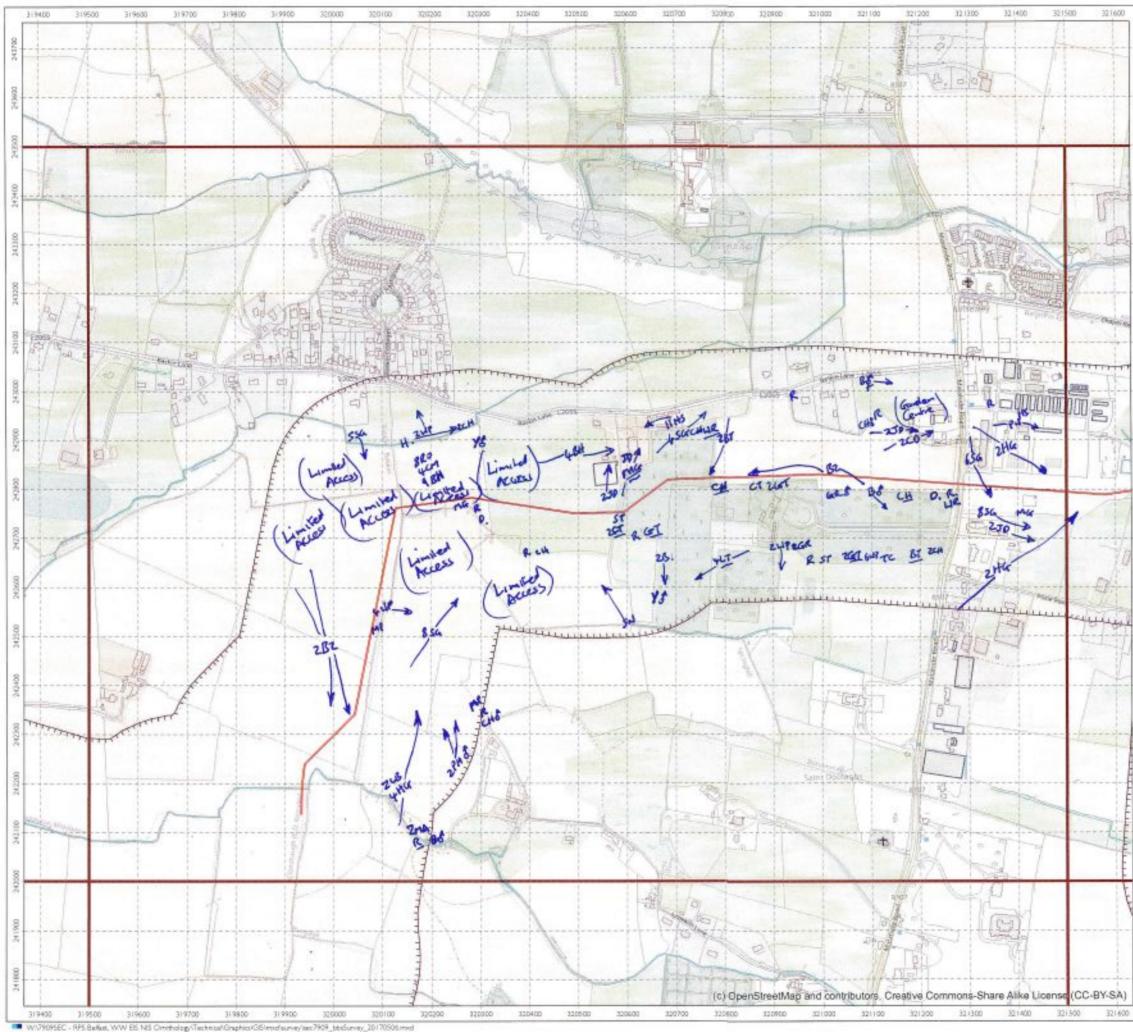

_	_		
D		)(	21
LV.	г		21

Surveyor: N.C	n Veale	
Date: 14/11/2	קוב	
Start time:	End time:	

q

\*Please attach weather sheet Notes:



Legend

BBS/WWO survey boundary (250 m builter of route supplied 20170405 appended to previous boundary)

Pipe route (supplied 20170405)

Greater Dublin Drainage


Breeding/winter bird survey

Page 3 of 18

0 L	200 m	1
Scale: 1	7,500 @A3	-
Date: 06/04/	2017 Job No: SEC7909	Rev: c
Drawn: CH	Checked: DRAFT	Approved: DRAFT
	d, EPSG 29902 ap contributors: Reproduced from th Government, License, No. 3-3-34	te Orchance Survey Of Instand by



RPS	10	
Surveyor: N. Vea		
Date: 14/11/1	7	
Start time:	End time:	

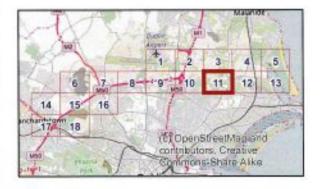

Legend

BBS/WWO survey boundary (250 m buffer of route supplied 20170405 appended to previous boundary)

Pipe route (supplied 20170405)

Greater Dublin Drainage

Breeding/winter bird survey

Page 11 of 18

0 LI	200 m	1
Scale: 1:7,500	@A3	~
Date: 06/04/2017	job No: SEC7909	Rev: c
Drawn: CH	Checked DRAFT	Approved DRAFT
	29902 buton: Reproduced from the C ment, License No. 3-3-34	Orchance Survey Officerand by

RPS	w	eather Sh	eet	Wind	Beaute		Direction	Rain/S			Cloud Cover	Cloud Height Height of cloud	Visibility		
Site G		600		500		Calm Light a		>1 1-3	N NE	None Drizzle/	Mist	0	In eighths e.g. 3/8	above average height of	Poor (<1km) ( Moderate (1-3km) 1
Date	2	4/4/17	7		breeze 3	4-7 8-12	E SE	Light showers Heavy showers		23		viewshed	Good (>3km) 2		
Survey	C	VUO		Mod. b Fresh t		13-18 19-24	S SW	Heavy r		4	Frost	<150m 0 150-500m 1			
Observer	K	Juli Ve	ab		breeze 6	25-31 32-38	w			_		>500m 2			
Start Time		8:50		Fresh	hgale 8 35		NW None On site	n site 1	1 Ground	Ground 1	Please be as acc	Please be as accurate as possible, with			
Finish Tin	ne 1	5:30		Strong Whole				High ground	bund	not a		not a range. e.g. \	details, entering only one figure, ge. e.g. WS - 5, not 5-6.		
Sheet 1/	100 C 100	Maps atta	ached	Storm Hurrica	11 ine 12							Use notes for extr E.g. WS - 5, gusti			
Weather	Wind speed	Wind direction	Rain	Cloud cover	Cloud height	Visibility	Frost	Snow	Notes(e	.g.	temperatur	e)			
Hr 1	5	W	0	3/8	2	2	-	-	200						
Hr 2	5	W	0	5/8	2	Z		_	1.1						
Hr 3	5	N	02	5/8	2	2	-		3.0						
Hr 4	4	W	1	618	2	2	-			_					
Hr 5	5	W	2	6/8	2	2	-		4°C						
Hr 6	5	W	2	6/8	2	2	-	-							
Hr 7	5	W	0	7/8	2	2	-		4°C						
Hr 8 Field Notes	5	L	0	5/8	2	2	-								




RPS	

Notes:

Surveyor. N. Veale						
Date: 24/	11/2017					
Start time:	End time:					

11

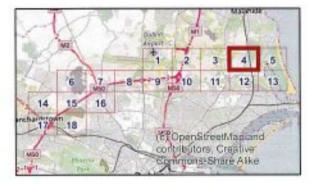

Legend

BBS/WWO survey boundary (250 m buffer of route supplied 20170405 appended to previous boundary)


Pipe route (supplied 20170405)

Greater Dublin Drainage


Breeding/winter bird survey

Page 4 of 18

0 L Scale: 1	200 m 	~
Date: 06/04/	2017 Jab Nox SEC7909	P Rev. c
Drawn: CH	Checked: DRAFT	Approved: DRAFT
		the Ordinance Sun ay Of Instand by

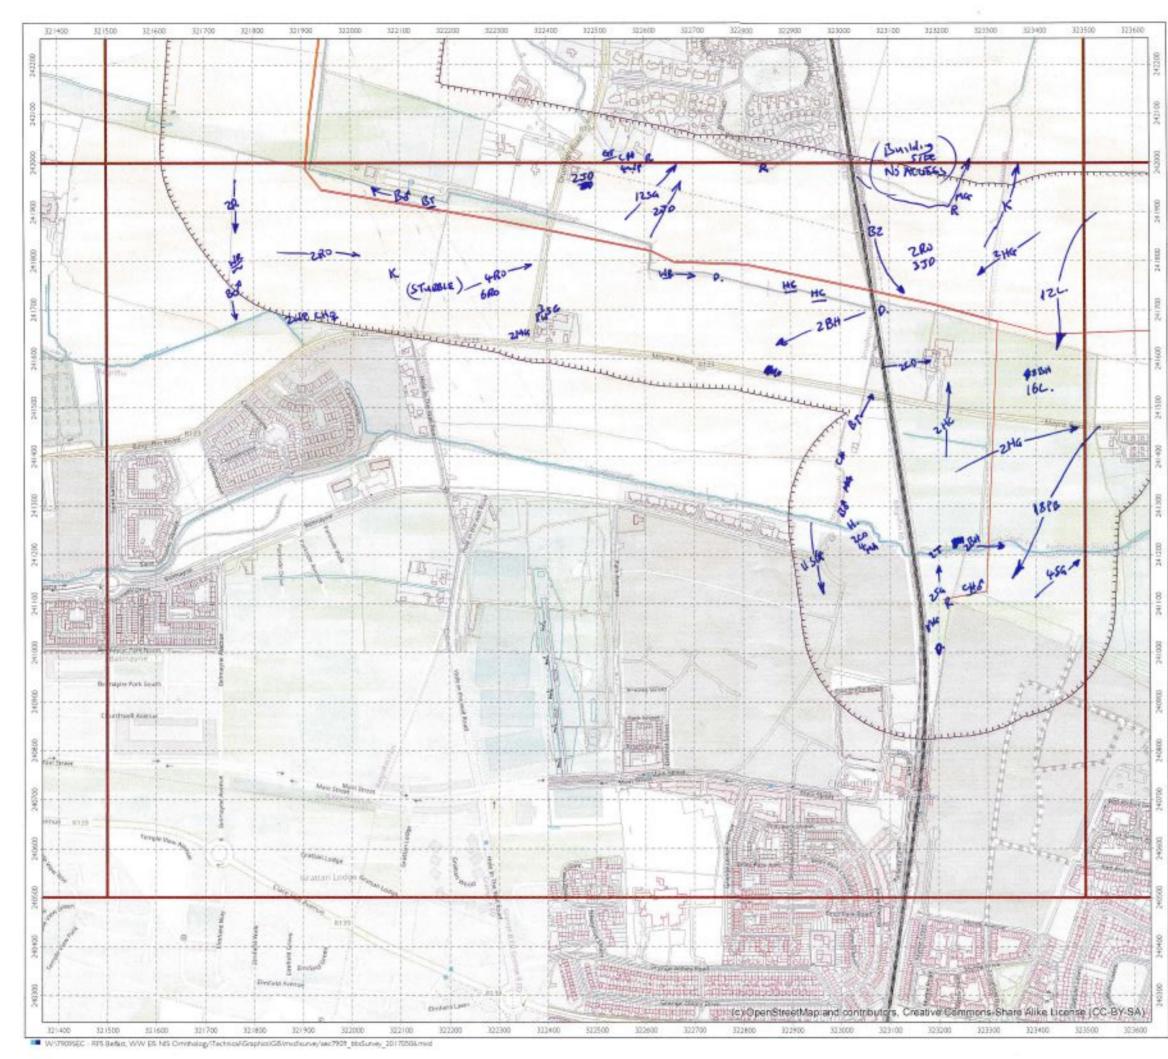

RPS	12
Surveyor: N	leave
Date: 24+	28/11/2017
Start time:	End time:

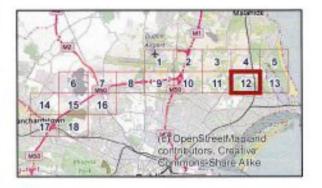

Legend



BBS/WWO survey boundary (250 m buffer of route supplied 20170405 appended to previous boundary)

Pipe route (supplied 20170405)


Greater Dublin Drainage

Breeding/winter bird survey


Page 12 of 18

0 Ll Scale: 17,500	200 m	~
Scale: 19,500	(LAIG)	100.00
Date: 06/04/2017	Jab No: SEC7909	Rev: c
Drawn: CH	Checked: DRAFT	Approved: DRAFT
	29902 butant: Reproduced from the 0	Ordnanos Survey Of Instand 5

RPS Site Date Survey Observer	G 24 1	hather Sheet		Wind S Calm Light ai Light br Gentle Mod. br Fresh b Strong	Beauth 0 r 1 teeze 2 breeze 3 reeze 4 treeze 5 breeze 6	>1 1-3 4-7 8-12 13-18 19-24 25-31	Direction N E SE S SW W NW	Rain/S None Drizzle/I Light sh Heavy s Heavy r Lying S	0 Mist 1 owers 2 howers 3 ain 4 Snow	Frost	Cloud He Height of c above ave height of viewshed <150m 150-500m >500m	cloud erage 0	Visibility Poor (<1km) Moderate (1-3km) Good (>3km)	0 1 2			
Start Time				Mod. gale 7 32-38 Fresh gale 8 39-46 Strong gale 9 47-54			NWV	On site High gro	0 1 2 und	Ground 1	Please be	Please be as accurate as possible, with weather details, entering only one figure,					
Finish Tir	ne							Strong gale 9 47-54 Whole gale 10 55-63 Storm 11 64-72			Lugir git	2010	not a range. e.g. WS - 5, no Use notes for extra info.			/S - 5, not 5-6.	it 5-6.
Sheet 1/	&[]	Maps atta	ched	Hurrica							E.g. WS -	5, gustin	g 6 [in notes].				
Weather	Wind speed	Wind direction	Rain	Cloud cover	Cloud height	Visibility	Frost	Snow	Notes(e.g	g. temperatu	ire)						
Hr 1	5	NW	0	318	2	2	1	-	Ooc								
Hr 2	4	NW	0	3/8	2	2	l –	-	100								
Hr 3	4	W	0	418	2	2	0	-	100								
Hr 4	5	U I	0	3/8	2	2	0	-	200			1000					
Hr 5	5	NW	0	2/8	2	2	0	-	3°	Euste	upto	for	e 7				
Hr 6	5	NU	0	4/8	2	2	0	-	5°C								
Hr 7	5	NJ	9	3/8	2	2	0	-	soc					252			
Hr 8	5	NW	0	4/8	2	2	0	-	Soc								
Field Notes Maps at																	
For office us Initial <u>AND</u> d boxes.	e only. NB late <u>ALL</u>	Logged		Databa	se Enter	ed [	Database \	/alidate	d GIS	Entered	GI	IS Vali	dated				

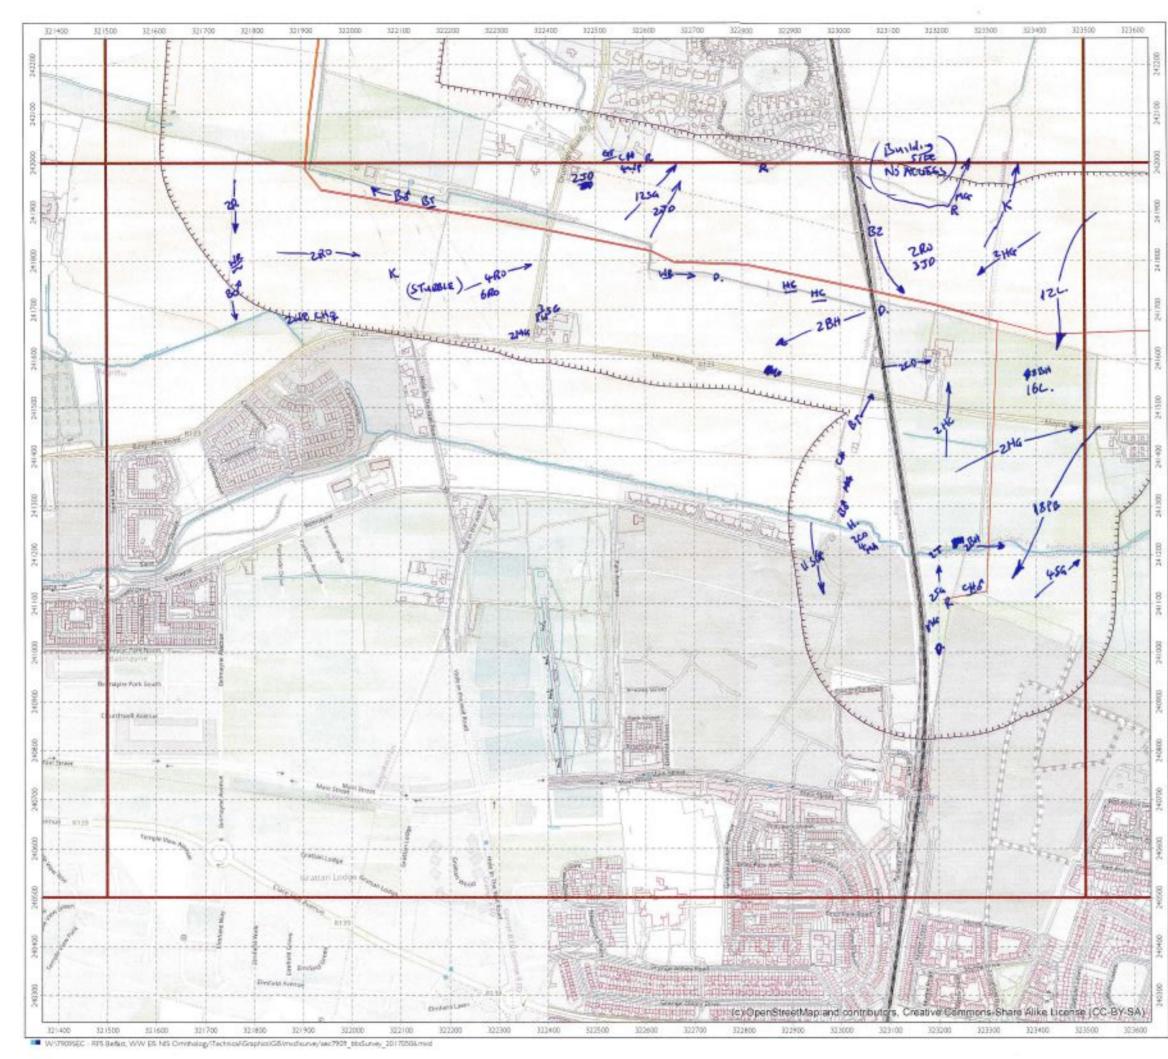

RPS	12
Surveyor: N	leave
Date: 24+	28/11/2017
Start time:	End time:

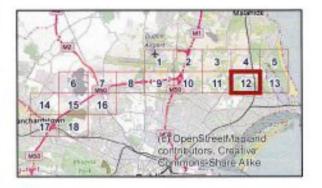

Legend



BBS/WWO survey boundary (250 m buffer of route supplied 20170405 appended to previous boundary)

Pipe route (supplied 20170405)

Greater Dublin Drainage

Breeding/winter bird survey

Page 12 of 18

0 Ll Scale: 17,500	200 m	~
Scale: 19,500	(LAIG)	100.00
Date: 06/04/2017	Jab No: SEC7909	Rev: c
Drawn: CH	Checked: DRAFT	Approved: DRAFT
	29902 butant: Reproduced from the 0	Ordnanos Survey Of Instand 5



RPS	13
Surveyor: Nick	Ved
Date: 28	111)2011
Start time:	End time:



Legend

BBS/WWO survey boundary (250 m buffer of route supplied 20170405 appended to previous boundary)

Pipe route (supplied 20170405)


Greater Dublin Drainage

Breeding/winter bird survey

Page 13 of 18

Scale: 1:7,500	(BA3	**
Date: 06/04/2017	job No: SEC7909	Rev: <
Drawn: CH	Checked: DRAFT	Approved: DRAFT

ubeducerb cour

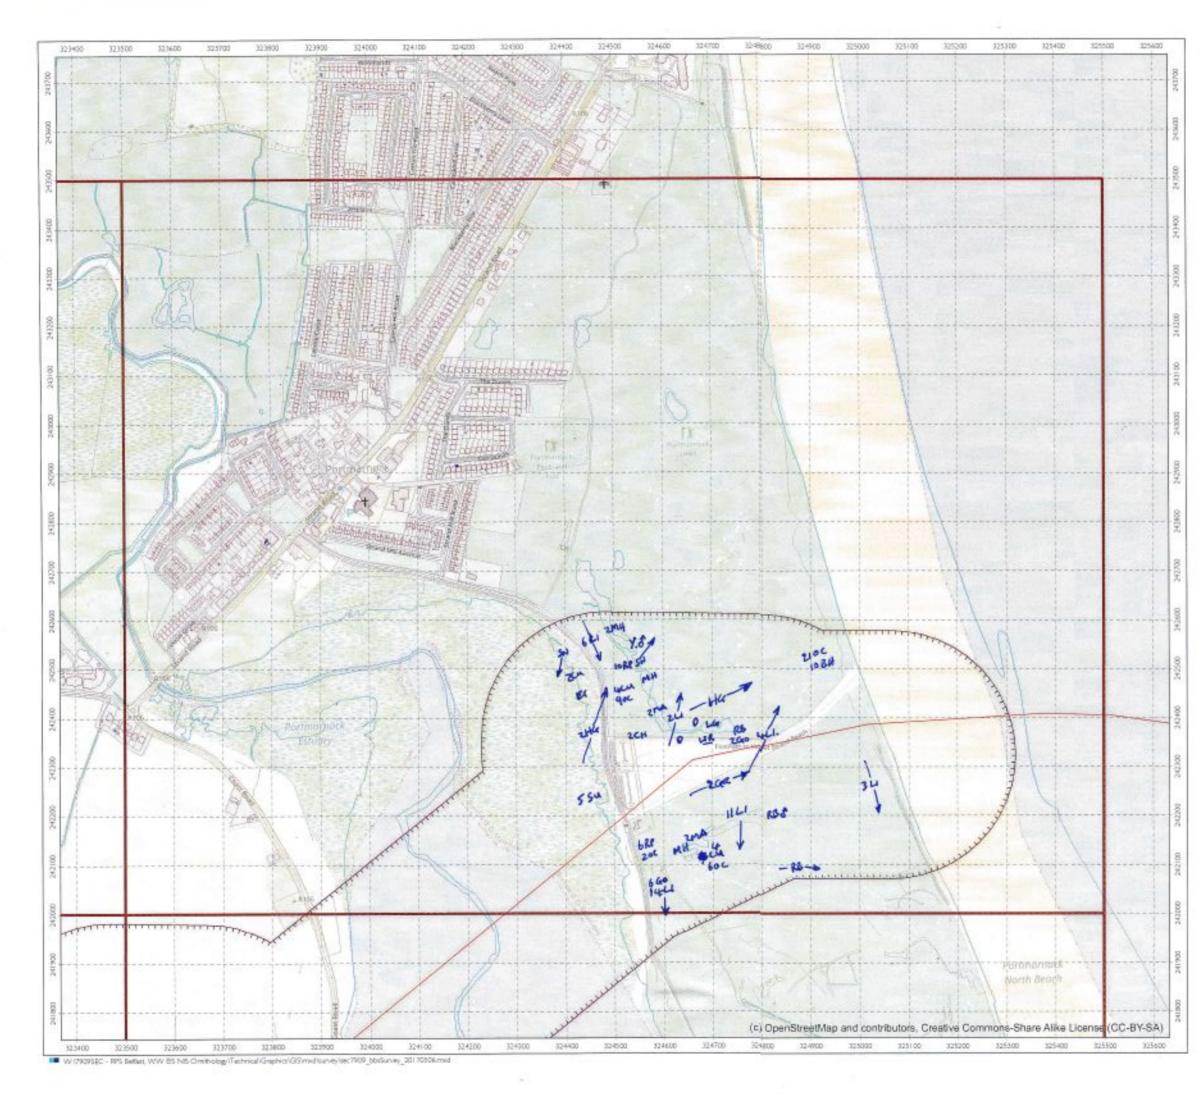

RPS	



Surveyor: N. Ve	inte	-
Date: 28/1	1/2017	
Start time:	End time:	



Legend

BBS/WWO survey boundary (250 m buffer of route supplied 20170405 appended to previous boundary)

Pipe route (supplied 20170405)

Greater Dublin Drainage

Breeding/winter bird survey

Page 5 of 18

0	200 m	1
Scale: 1:7,500	0.@A3	
Date: 06/04/2017	Job No: SEC7909	Rev: c
Drawn: CH	Checked: DRAFT	Approved DRAFT
Vish National Grid, 6PS © OpenStreetMap con	5 29902 Hibutors: Reproduced from the 6	Ordnance Survey Of Ireland b

Permission of the Government License No. 3-3-34

## GDD Oral Hearing Response to Inspector's Questions

## APPENDIX 6 SUMMER 2015 (APRIL AND JUNE)

The data from the April and June 2015 breeding walkover surveys were mapped, and are enclosed below (along with the associated survey recording sheets).

RRS	W	eather Sh	eet	Wind	Speed		Direction	Rain/S	now	Cloud Cover	Cloud Height	Visibility
Site GDP Date IS/04/2015 Survey Breeding Birds Observer Nick Vecle Start Time 07.00 Finish Time 1300		Light air 1 1-3 N Light breeze 2 4-7 E Gentle breeze 3 8-12 Si Mod. breeze 4 13-18 S Fresh breeze 5 19-24 Si Strong breeze 6 25-31 W			N NE E SE S SW W	None Drizzle/ Light sh Heavy s Heavy r Lying s	owers 2 howers 3 ain 4		Height of cloud above average height of viewshed <150m 0 150-500m 1 >500m 2	Poor (<1km) 0 Moderate (1-3km) 1 Good (>3km) 2		
			Mod. gale         7         32-38         NV           Fresh gale         8         39-46         39-46           Strong gale         9         47-54         47-54           Whole gale         10         55-63         55           Storm         11         64-72         56		NW None 0 On site 1 High ground 2		1 Ground 1	Please be as accurate as possible, with weather details, entering only one figure, not a range, e.g. WS - 5, not 5-6. Use notes for extra info.				
Sheet 1/	&[]	Maps atta	ched	Hurrica		· · · · · · · · · · · · · · · · · · ·					E.g. WS - 5, gustin	ng 6 [in notes].
Weather	Wind speed	Wind direction	Rain	Cloud cover	Cloud height	Visibility	Frost	Snow	Notes(e.g	. temperatur	re)	
Hr 1 07:00	2	SW	0	6/8	2	2	0	0	6°C			
Hr 205:00	3	SU	0	6/8	2	2	0	0	8°C			
Hr 3 Chao	3	W	1	8/8	2	1	0	0	8°C			
Hr 4 105.00	12	W	0	8/8	2	2	0	0	9°C	A lines		
Hr 5)]:00	3	W	0	8/8	2	2	0	0	11°C			
Hr 6 12:00	2	W	2	8/8	2	2	0	0	11°C			
Hr 7												
Hr 8												
Field Notes Maps att												
Initial AND da	e only. NB- ate <u>ALL</u>	For office use only. NB- Initial AND date ALL boxes.			se Enter	ed Da	atabase V	/alidated	GIST	Entered	GIS Vali	dated



RPS

Surveyor Nick Vecle 12015 Date: End time: 13:00 Start time: 07:00 \*Please attach weather sheet Notes: Transact vonte >1 1 \* Dipper Nest Active (under bridge) 2 the Digger Nest morise (under bonding) 8 3 \* Kinggesher Nest (Aduit seen going in + and ) 1-2-2-4 50 6 7 8 9 10 11 12 13 14 15 16 17-18 (c) OpenStreetMap and contributors, Creative Commons-Share Alike Legend

BBS survey boundary (250 m buffer, supplied 20140420)

Greater Dublin Drainage


Breeding bird survey

Page 17 of 18

Drawn: OH	Checked DRAFT	Approved DRAFT
Date: 20/04/2015		Rev: a
Scale: 17,500	(A)	-
L	200 m	1


magroup.znet

RPS		eather Sh	eet	Wind Speed Beaufort Mph Calm 0 >1			Direction Rain/Snow		0	Cloud Cover In eighths e.g. 3/8	Cloud Height Height of cloud above average	Visibility Poor (<1km) 0 Moderate (1-3km) 1
Date16042015SurveyBreeding BirdsObserverN. VealeStart Time06:50Finish Time12:50Sheet 1/ & [] Maps attached		Light air 1 1-3 Light breeze 2 4-7 Gentle breeze 3 8-12 Mod. breeze 4 13-18 Fresh breeze 5 19-24			NE         Drizzle/Mist           E         Light showers           SE         Heavy showers           S         Heavy rain           SW         Lying Snow		owers 2 howers 3 ain 4	2 3	height of viewshed <150m 0 150-500m 1 >500m 2	Good (>3km) 2		
		ched	Strong breeze         6         25-31           Mod. gale         7         32-38           Fresh gale         8         39-46           Strong gale         9         47-54           Whole gale         10         55-63           Storm         11         64-72           Hurricane         12         73+		On site High ground		0 1 sund 2	1 Ground 1	>500m 2 Please be as accurate as possible weather details, entering only one not a range, e.g. WS - 5, not 5-6. Use notes for extra info. E.g. WS - 5, gusting 6 [in notes].			
Weather	Wind speed	Wind direction	Rain	Cloud cover	Cloud height	Visibility	Frost	Snow		. temperatu	re)	
Hr 1 0650	2	E	0	718	2	2	0	0	4° c			
Hr 20750	3		0	718	2	2	0	0	7°C			
Hr 308.50	and the second se	LUL	0	618	2	22	0	0	T°C			
Hr 409:50	3	E	0	5/8	2	2	0	8	9°C	(Constant)		A CONTRACTOR
Hr 510.50	3	E	0	518	2	2	0	0	10°C			
Hr 6 11:50	4	E	0	5/8	2	2	0	0	10°C		No. 1 Land	
Hr 7 12.50		1		-	11.2							
Hr 8									Press Press	COLL-		No. of Contraction
Field Notes: Maps att												
For office use Initial AND da	e only. NB- ite <u>ALL</u>	Logged		Databa	se Enter	ed Da	atabase V	alidated	GIST	Entered	GIS Val	idated

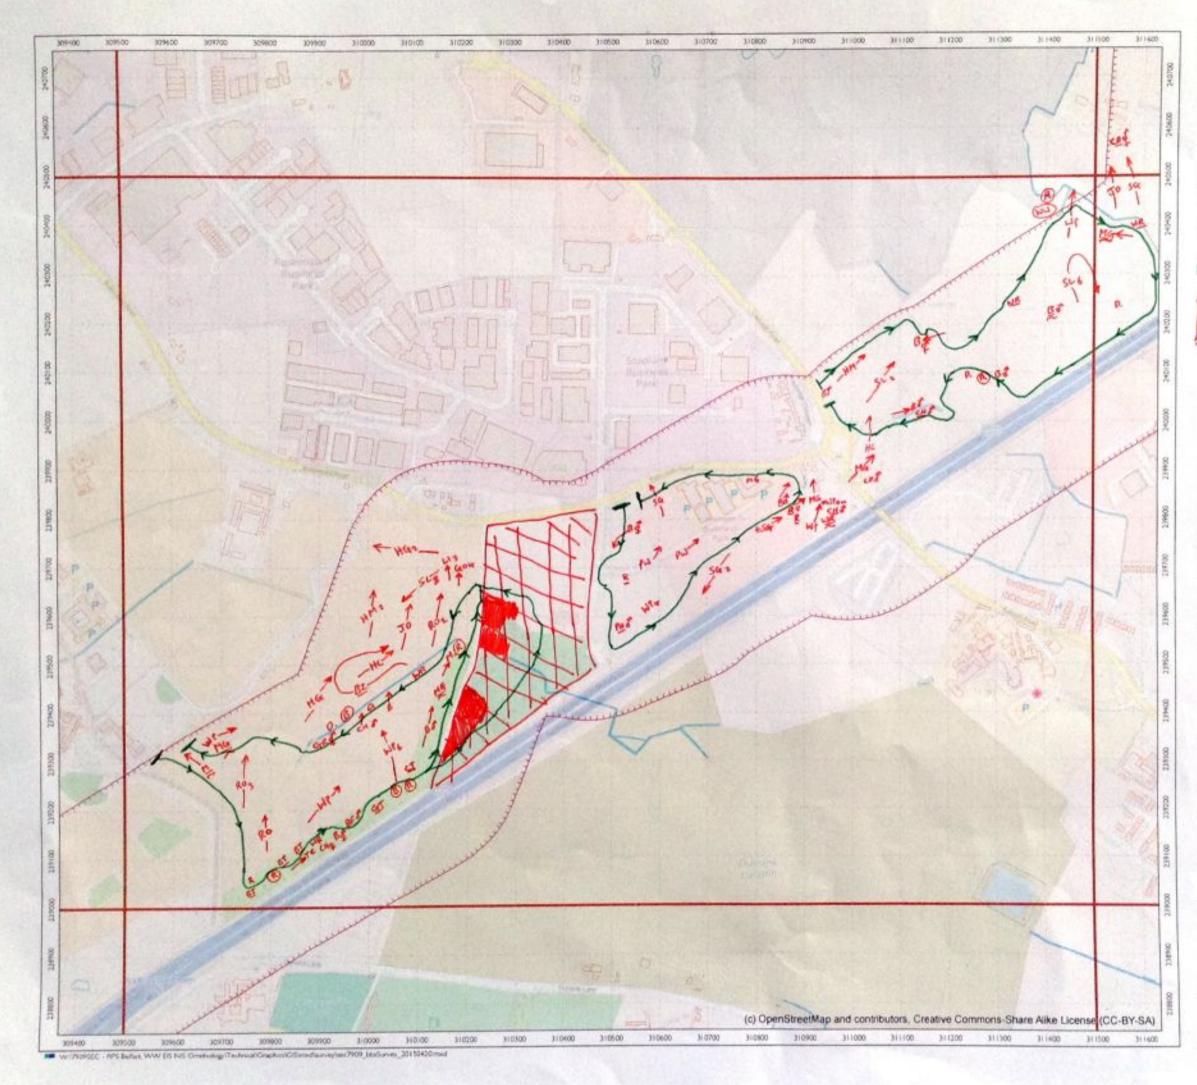

-	-	-	I
R	Р	5	l
		-	,

Surveyor Nick Veck Date: 16 04/2015 Start time: 🥮 06:50 End time: 12:50

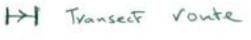

No Access (Traveler Holding site)

1-12 24 4 53 7-8-1-9 10 11 12 13 (c) OpenStreetMap and contributors, Creative Commons-Share Alike

## Legend

BBS survey boundary (250 m buffer, supplied 20140420)

Greater Dublin Drainage

Breeding bird survey

Page 15 of 18

0	200 m	1
Scale 17.	500 @A3	
Date: 20/04/20	15 Job No: SEC7909	Rec a
Drawn: OH	Orecked DRAFT	Approved DRAFT
	EPSG 29902 contributors Reproduced hors the	Orginance Survey Of Invited In

rpagroup.com



RPS
Surveyor Nick Vecle Date: 23/04/2015
Date: 23/04/2015
*Please attach weather sheet Notes
Transect Routes
A Providence
17 18 (c) OpenStreetMap and
contributors. Creative Commons-Share Alike
trat the second s
Legend
BBS survey boundary (250 m buffer,
supplied 20140420)
Greater Dublin Drainage
Breeding bird survey
Page 7 of 18
0 200 m
Scale 17,500 (0A) "I Date 20/04/2015 Job No. SEC7909 Rev. a
Date: 20/04/2015 Job No: SEC/90/ Nev A Drawn: CH Checked: DRAFT Approved: DRAFT
and National Oriol. (PSG 2000) # Opendeworklap constitutions, Reproduced from the Ordnance Sumey Of Initian Its Permation of the Openment License No. 3-3-34

RPS		eather Sh	eet	Wind :	Speed Beauf 0	ort Mph	Direction	Rain/S	now 0	Cloud Cover	Cloud Height Height of cloud above average	Visibility Poor (<1km) 0
Site		DD		Light a	r 1	1-3	NE	Drizzle/I Light sh		e.g. 3/8	height of	Moderate (1-3km) 1 Good (>3km) 2
Date	2	3/04/2	015	Gentle	breeze 3	8-12	SE	Heavy s	howers 3		<150m 0	
Survey	B	rocaling P	Sirds	Mod. b Fresh t		13-18 19-24	S SW	Heavy n		Frost	150-500m 1	
Observer	N	ick Ve	de	Strong Mod. g	breeze 6	25-31 32-38	W NW	None	0	None 0	>500m 2	
Start Time		6:30		Fresh	pale 8			On site	1	Ground 1	weather details, er	rate as possible, with itering only one figure
Finish Tir		2:30		Strong Whole	gale 1	0 55-63		High gro	ound 2	All day 2	not a range, e.g. V Use notes for extra	VS - 5, not 5-6.
Sheet 1/		Maps atta	ched	Storm	1 ne 1						E.g. WS - 5, gustin	
Weather	Wind speed	Wind direction	Rain	Cloud cover	Cloud height	Visibility	Frost	Snow	Notes(e.g	. temperatur	e)	
Hr 1 06:30	0	/	O	0/8	2	2	0	0	8c			
Hr 207.30	0	-	0	0/8	2	2	0	0	10°C			
Hr 3 08 5	1	SE	0	0/8	2	2	0	0	13°C			
Hr 401:30	1	SE	D	48	2	2	0	0	16°C	11025		
Hr 510.30	1	SE	0	1/8	2	2	0	0	11°С			
Hr 611:30	1	SE	0	1/8	2	2	0	0	17°C			
Hr 7 12:30	2	5	0		2	2			18°C			
Hr 8	2	5	0	in the second				- mark		10-10-10-10-10-10-10-10-10-10-10-10-10-1		
Field Notes Maps att												
For office us Initial <u>AND</u> di boxes.	e only. NB- ate <u>ALL</u>	Logged	8	Databa	se Enter	ed Da	atabase \	/alidated	GIS	Entered	GIS Val	idated




Withonsee - MS Batas, WW ES NS Orisonalig: Technical Graphics GS mindsurvey (ar 7009\_bbsSurvey\_20130420mid

-	4158374
RPS	
urveyor: N	ick Veale
Date: 23	104/2015
tart time: 0	6:30 End time:
	weather sheet
lotes	
71	and the second second
M N	o Access Rang
les	adourse 3 days in a row
lef	It numerous messages, No
Co	ntact.
-To	and the second
e m	F. J. J. STR. L.J.
6	7
14 18	16
17 18	·
1 million	(c) OpenStreetMap and contributors, Creative
in a line	Commons-Share Alike
-	the second s
Legend	
	survey boundary (250 m buffer, plied 20140420)
	Dublin Drainage
Greater	
	; bird survey
Breeding	
Breeding	
Breeding Page 8 o	of 18
Breeding Page 8 o	200 m 200 m 7500 @A3
Breeding Page 8 o	200 m 200 m 7,500 (\$A3 /2015 Job No; SEC7909 Rev: a

RPS Site Date Survey Observer	6	eather Sha ) 0 + 104/20 realing () . Veals	215	Wind S Calm Light ai Light br Gentle Mod. br Fresh b Strong	Beauf 0 r 1 eeze 2 breeze 3 eeze 4 reeze 5 breeze 6	>1 1-3 4-7 8-12 13-18 19-24 25-31	Direction N E S S S S W W	Rain/S None Drizzle// Light sh Heavy s Heavy r Lying S	0 Mist 1 owers 2 howers 3 ain 4 Snow	Cloud Cover In eighths e.g. 3/8	Cloud Height Height of cloud above average height of viewshed <150m 0 150-500m 1 >500m 2	Visibility Poor (<1km) 0 Moderate (1-3km) 1 Good (>3km) 2
Start Time		6:30	1	Mod. gr Fresh g	ale 8		NW	None On site	0 1 2	None 0 Ground 1 All day 2	weather details, e	urate as possible, with ntering only one figure,
Finish Tir		2:30		Strong Whole	gale 1	0 55-63	10000	High gro	Juno 2	All day 2	not a range. e.g. V Use notes for extr	WS - 5, not 5-6. a info.
Sheet 1/		Maps atta	ched	Storm	1 ne 1	Contraction of the second second	-			1.1.1	E.g. WS - 5, gusti	ng 6 [in notes].
Weather	Wind speed	Wind direction	Rain	Cloud cover	Cloud height	Visibility	Frost	Snow	Notes(e.g	temperatu	re)	
Hr 10630	the second s	W	0	3/8	2	2	0	0	5°C			
Hr 207.50	4	W	0	3/8	2	2	0	0	7°C		12.0	
Hr 308:30	4	SW	0	4/8	2	2	0	0	8°C	1 million		
Hr 409:30	3	SW	0	2/8	2	2	0	0	10°C	-		
Hr 510:30	3	SW	0	218	2	2	0	0	12°C	-		
Hr 611:30	2	SE	0	2/8	2	2	0	0	13°C			
Hr 7												
Hr 8								1				
Field Notes Maps att												
For office us Initial <u>AND</u> di boxes.	e only. NB- ate <u>ALL</u>	Logged		Databa	se Enter	ed D	atabase \	/alidate	d GIS	Entered	GIS Va	lidated





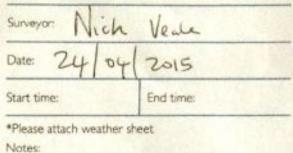

+>+ Transeet Route



Legend

BBS survey boundary (250 m buffer, supplied 20140420)

Greater Dublin Drainage

Breeding bird survey


Page 3 of 18


0	1	200 m	1
Scale	e 17,500 (	@A3	
Date 20	04/2015	Job No. SEC7909	Rev: a
Drawn C	ж	Checked: DRAFT	Approved DRAFT
* Operâtre	e Ond, EPSG edHap contro of the Gavern	29902 Butters Reproduced from the ment Lucrose No. 3-3-34	Ordnance Survey Of Instand by


magroup.com





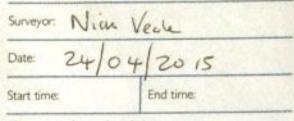

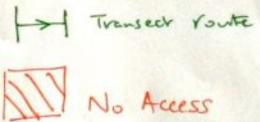

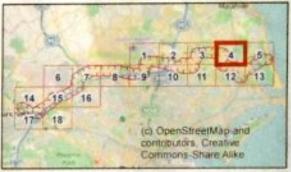

Legend

BBS survey boundary (250 m buffer, supplied 20140420)

Greater Dublin Drainage

Breeding bird survey

Page 4 of 18

0	200 m	1
Scale: 1:7	500 @A3	-
Date: 20/04/2	015 Job No: SEC7909	Rev: a
Drawn: CH	Checked DRAFT	Approved DRAFT
Nuh Natural Grid * Openitreathap Permanan of the I	ENG 27902 contribution Reproduced Inside Government License No. 5 X 44	The Carlosses (

Site GOO Light air 1 1-3 NE Drizzle/Mist 1 e.g. 3/8 boile average Moderate (1-3km)	RPS	We	ather Sh	eet	Wind s	Beauf		Direction	Rain/Si		Cloud Cover	Cloud Height Height of cloud	Visibility Poor (<1km) 0







	Field Notes										No.		No.
	For office us	e only. NB-	Logged		Databa	se Enter	ed D	atabase \	Validated	d GIS	Entered	GIS Va	lidated
For office use only. NB- Logged Database Entered Database Validated GIS Entered GIS Validated	Initial <u>AND</u> d boxes.	ate ALL	Loggeo		Databa	Se Linter		alabase	Vandated		Lintered	GIOVA	liudiou



RPS

Surveyor Nick Veale Date 27/04/2015 End time: 12:32 Start time: 06:32

-> Transect Route

(Access : Eline Quine Pertmente Galf links) 01 866692) Hord 1-2-1 3-1 4 5 6 7-8-19 10 11 12 13 14 15 16 17 18 (c) OpenStreetMap and contributors, Creative Commons-Share Alike

Legend

BBS survey boundary (250 m buffer, supplied 20140420)


Greater Dublin Drainage

Breeding bird survey

Page 5 of 18

Scale 17500	6A3	-
Date: 20/04/2015	Job No: SEC7909	Rev a
Drawn: CH	Checked: DRAFT	Approved DRAFT

reagroup.com

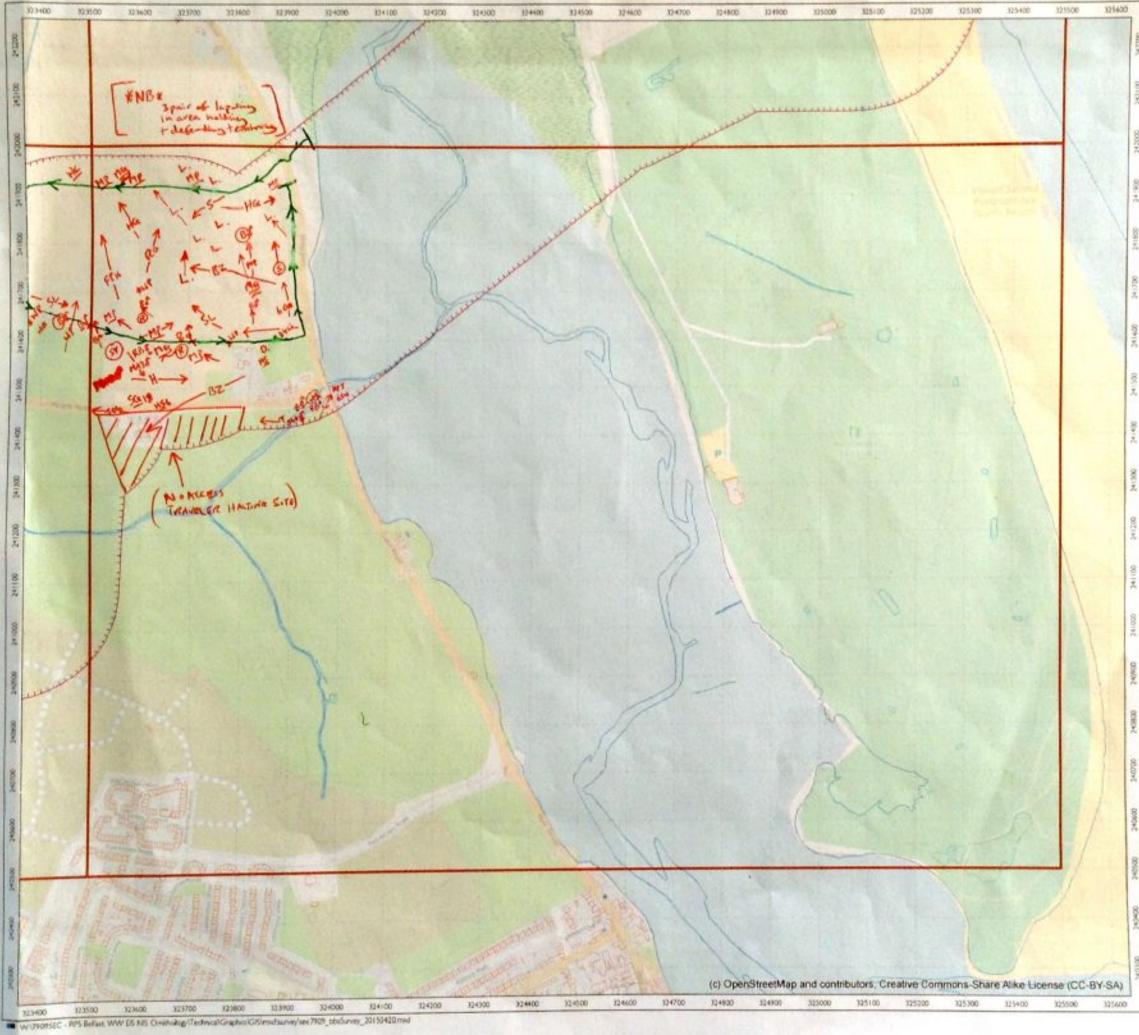

-	-	-
D	D	9
~		9

	ik Vecle	
Date: 27/0	4/2015	
Start time: 06:3:	2 End time 12:	32
Please attach wea Notes:	ther sheet	
> Tro	insect route	
13 Transed	continued on 1	1+7 (12
6 72	1200	5
14 15 16 17 18	(c) OpenStreetMap contributors, Creativ Commons-Share Al	/e
Legend BBS surv supplied Greater Dubl Breeding bird Page 13 of 11	(c) OpenStreetMap contributors. Creatin Commons-Share Al ey boundary (250 m buffe 20140420) fin Drainage d survey 8 200 m	r.

megroup.com



RPS			
Surveyor N	ich Ve	Lala	
Date: 27/0	the second second second		
Start time: 06.		time: 12:37	2
*Please attach we	ather sheet		
-> T.	ransect	Route	
No No	Access	Security	Fencing
8 7 14 15 16 17= 18	(d) O contr	110.1-1-1	5
Legend BBS sur supplied	vey boundary I 20140420)	(250 m buffer,	
Greater Dul	olin Drainag	e	
Breeding bir	d survey		6

* Open	onal Grid, EPSG breetMap control of the Govern	20902 butors: Reproduced From the E yearst. License No. 3-3-34	Ordnance Survey Of Island
Drawn	СН	Checked DRAFT	Approved: DRAF
Date 2	0/04/2015	Job No: SEC7909	Rev: a
Sc	ale: 1:7,500	@A3	~
0	1	200 m	1


megroup.com

RPS	w	eather She	eet	Wind s		ort Mph	Direction	Rain/S	now	Cloud Cover	Cloud Height	Visibility
Site Date		100 8/04/201	<	Caim 0 >1 Light air 1 1-3 Light breeze 2 4-7 Gentle breeze 3 8-12 Mod. breeze 4 13-18 Fresh breeze 5 19-24		m 0 >1 N None ht air 1 1-3 NE Drizzle/Mist ht breeze 2 4-7 E Light showers		owers 2	1 e.g. 3/8 2	Height of cloud above average height of viewshed Poor (<1km) Moderate (1-3km Good (>3km)	Moderate (1-3km) 1	
Survey		ROUNIN				13-18	SE S	Heavy rain 4	<150m 0			
Observer		and the second second second second second	and the second se				SW W		Frost	150-500m 1 >500m 2		
Start Tim	North VEEU		u	- Mod. gale 7 32-38 Fresh gale 8 39-46			NW None	0 None 1 Ground	None 0 Ground 1	Dianas ha as accurate as possible with		
		the local division in		Strong	gale 9	47-54		High gro	the second se	All day 2	weather details, e not a range, e.g. V	ntering only one figure, NS - 5, not 5-6.
Finish Tir		1:25		Whole Storm	gale 1 1					Hole Color	Use notes for extr E.g. WS - 5, gusti	a info.
Sheet 1/		Maps atta	Contraction of the second	Hurrica	100	19 10 10						ng o tin notest.
Weather	Wind speed	Wind direction	Rain	Cloud cover	Cloud height	Visibility	Frost	Snow	Notes(e.g	. temperatu	ire)	
Hr 1	3	wsu	0	1/8	2	2	1	0	1°C			and the second
Hr 2	4	LISW	0	1/8	2	2	0	0	3° c			
Hr 3	4	5	0	2/8	2	2	0	0	6° c		Real Contraction	
Hr 4	4	L	0	418	2	2	0	0	7° c			
Hr 5	4	L	0	4/8	2	2	0	0	9°C			
Hr 6	4	と	2	5/8	2	2	0	0	9°2			
Hr 7								1				
Hr 8	- Comercia	1.00					- Shu			12 - 1 - 1 - 24	Harrison and the second	and the state of t
Field Notes Maps att												
For office us Initial <u>AND</u> d boxes.		Logged		Databa	se Enter	ed D	atabase \	/alidated	d GIS	Entered	GIS Va	lidated



RPS

Surveyor: N ick Vede 28/04/2015 Date: Start time: 06:25 End time: 12:25

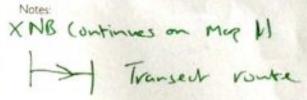



Legend

BBS survey boundary (250 m buffer, supplied 20140420)

Greater Dublin Drainage

Breeding bird survey

Page 10 of 18

seh Fational G	NA EPSC	29902 sutors Reproduced from the 0	
Drawn CH		Checked DRAFT	Approved DRAFT
Date: 20/04	/2015	Job No: SEC7909	Rev a
Scale	7.500	(A)	-
0		200 m	1

rpegroup.com




W178095EC - NPS Ballan, WW ES NEI, Devalualizg/Technical/Grachical/GErnathioney/sec7909\_1015unwy\_20150420mad

RPS surveyor Nich Vede Date 28/04/2015 Start time: 06:25 End time: 12:25 \*Please attach weather sheet Notes: XNB Continued from Map 10 F>1 Transect Voute 6 7 8 9 10 11 12 13 14 15 16 17. 18 (c) OpenStreetMap and contributors, Creative Commons-Share Alike Legend BBS survey boundary (250 m buffer. supplied 20140420) Greater Dublin Drainage Breeding bird survey Page 11 of 18 200 m 1 Scale: 17,500 @A3 Date: 20/04/2015 Job No: SEC7909 Rev: a Drawn, CH Checked DRAFT Approved DRAFT Insh Netional Grid. EPSC 19902 © Opendementing constructions Reproduced from the Orchance Survey Of Instand by Permission of the Covernment License Net 3-5-34 rpsgroup.com





Surveyor	N. VEALE				
Date	28/04/2	2015			
Start time:	06:25	End time: 12:25			

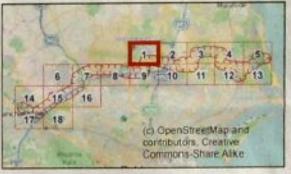

Legend

BBS survey boundary (250 m buffer, supplied 20140420)

Greater Dublin Drainage

Breeding bird survey

Page | of 18


0	200 m	1
Scale: 1.7,500	(A)	-
Date: 20/04/2015	Job No: SEC7909	Rev. a
Drawn: OH	Checked DRAFT	Approved DRAFT
Insh National Grid, 5750 * OperAtree/Plap comm	- 192	Orenance Survey Of Vesual


rpsgtoup.com



RPS

Surveyor N. VEALE Date: 28/04/2015 End time: 12:25 Start time: 06:25

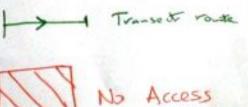

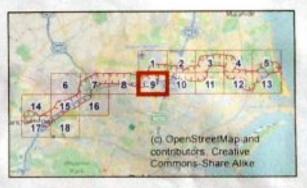

Legend

BBS survey boundary (250 m buffer, supplied 20140420)

Greater Dublin Drainage

Breeding bird survey

Page 9 of 18

Checker Brent	
Checked DRAFT	Approved DRAFT
Job No: SEC7909	Rev a
(Ag	-
200 m	1

rpagroup.com



Providence.



SURVEYOR N. VEALE Date: 28/04/2015 End time: 12:25 Start time: 06:25 \*Please attach weather sheet Notes: XNBX Transets Cross Maps 1+2 6 7 8 9 10 11 12 13 14 18 16 17 18 (c) OpenStreetMap and contributors, Creative. Commons-Share Alike Legend BBS survey boundary (250 m buffer, supplied 20140420) Greater Dublin Drainage Breeding bird survey Page 2 of 18 200 m

Scale: 17,500 @A3 Date: 20/04/2015 Job No. SEC7909

Drawn: CH Checked DRAFT

Indi National Grid, EPSG 19902. \* OperGreetPlap contribution: Reproduced from the Ontrance Summ Of Iveland to Permasion of the Government License No. 3-3-34 mea.quarget

Approved DRAFT



WCMONDEEC - RPS Bellet, WW ES N/S Creaticity/Technical/Graphics/GD/mm/sucrey/ac.7909\_sostumey\_20110-QD mud.




Surveyor Nick Vence Date: 02/06/2015 End time: Start time: 05:4-0 \*Please attach weather sheet Notes: Transect Rute \* Dipper nests apear empty at least 2 adult birds near Bridge With 3 Jur. \* Kingister seen but not near nest sife recorded in April. and the sugar 6 7 8 9 10 11 12 13 14 18 16 175 18 (c) OpenStreetMap and contributors. Creative Commons-Share Alike Legend BBS survey boundary (250 m buffer, supplied 20140420)

Greater Dublin Drainage Breeding bird survey Page 17 of 18 0 20 200 m Scale: 1.7500 @A3 Date: 20/04/2015 job No: SEC7909 Rev: a Drawn: OH Checked: DRAFT Approved DRAFT

Indh Nasional Ciril, UPSC 20920 \* Opendimentilian contributions: Reproduced from the Circlestone Survey Offentiand by Permission of the Covernment License No. 3-3-34

rptgroup.com

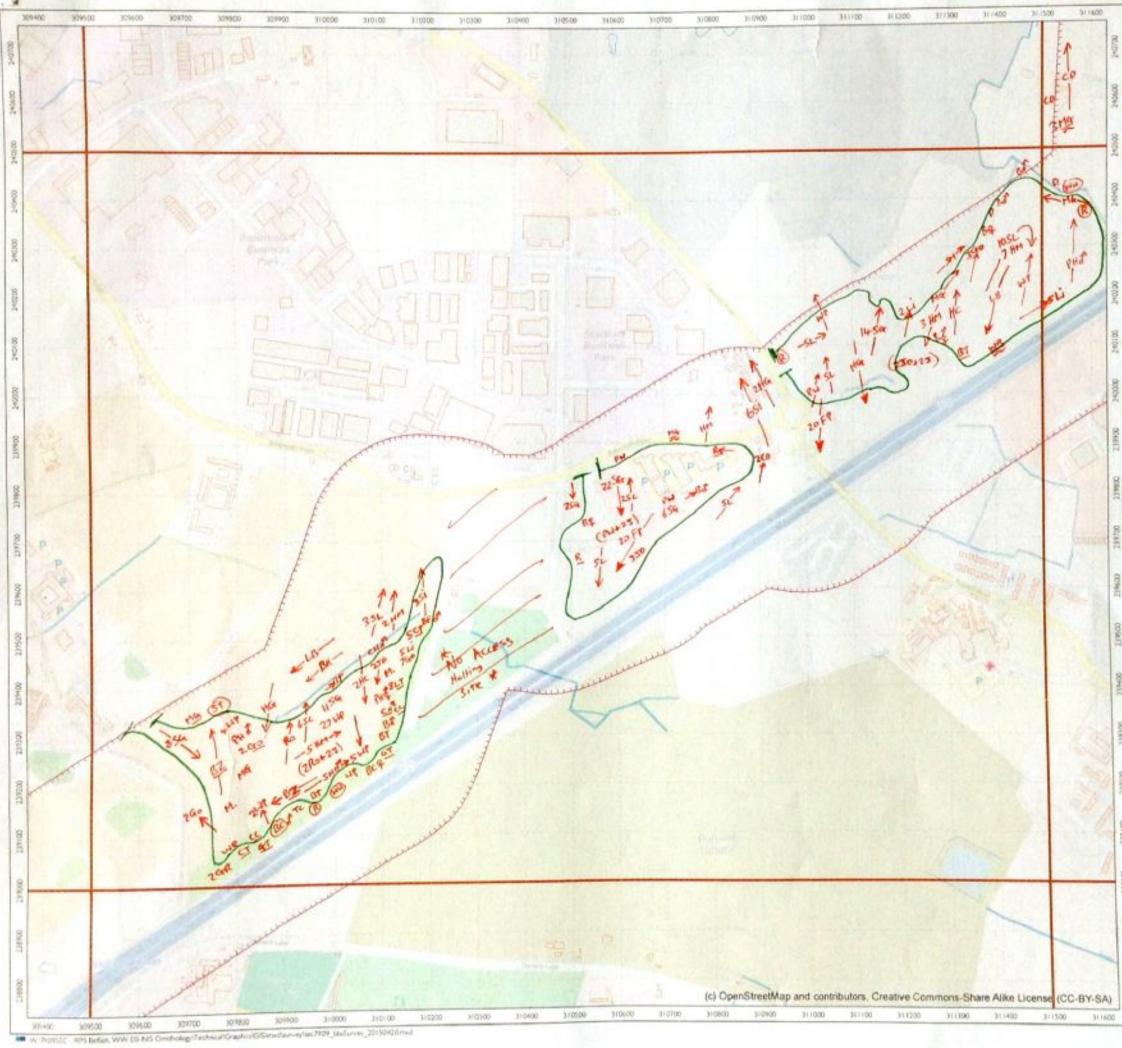

RPS

Surveyor Nick Veck Date: 03/06/2015 Start time: 05:4-5 End time: 11:4-5

-1	Transect	Voute
----	----------	-------




Legend

BBS survey boundary (250 m buffer, supplied 20140420)


Greater Dublin Drainage

Breeding bird survey

Page 15 of 18

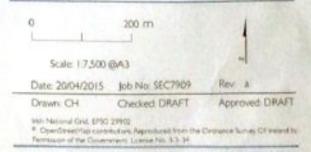

19497049.0011

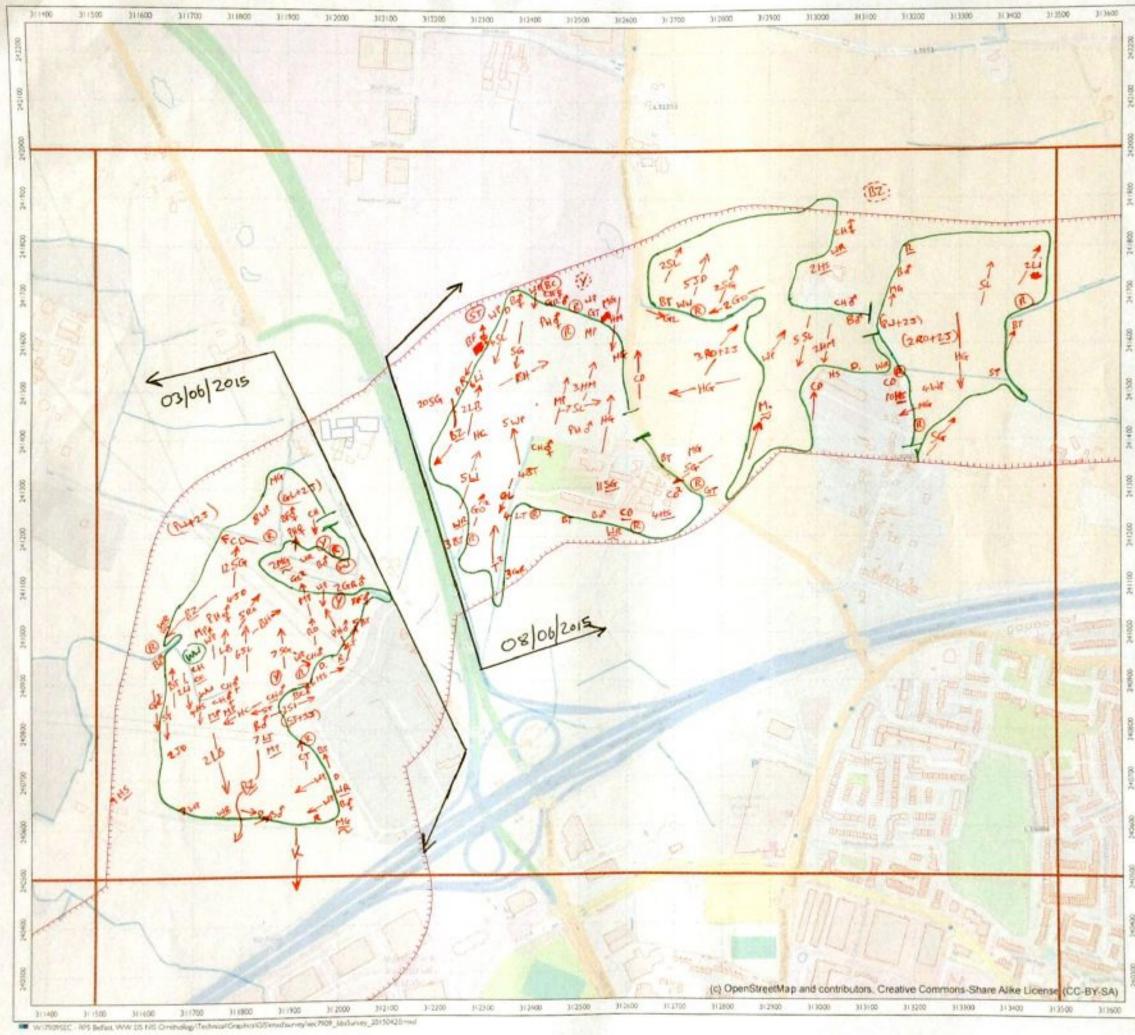

RPS	
Surveyor: N. Veale Date: 03/06/2015+08	l. Jane
03         04         2×45         05:445         11:4-5           Start time:         05:465         End time:         11:30	100/2015
*Please attach weather sheet Notes:	
H Trensect	route



Legend



BBS survey boundary (250 m buffer, supplied 20140420)

Greater Dublin Drainage

Breeding bird survey

Page 7 of 18


0	200 m	1
Scale: 17.500	(A)	-
Date: 20/04/2015	Job No: SEC7909	Rev a
Drawn: OH	Checked: DRAFT	Approved DRAFT
	29902 Inforts Reproduced from the I ment License No. 3.3-31	Ordinantia Survey Of Instand 5
1//		10-50-map com





RPS Surveyor: Nick Vede Date: 08/06/2015 Start time: 05:30 End time: 11:30

Notes:

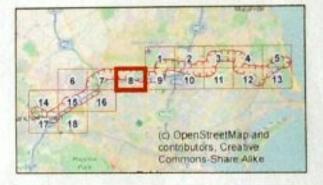


Legend

BBS survey boundary (250 m buffer, supplied 20140420)

Greater Dublin Drainage Breeding bird survey Page 8 of 18

0	200 m	1
Scale: 17,500	BAJ	-
Date 20/04/2015	Job Na: SEC7909	Rev. a
Drawn: OH	Checked DRAFT	Approved: DRAFT
	29902 future: Reproduced from the ment Lorena No. 3, 3, 34	Ordney a farring Of Intend 1

rpagroup.com

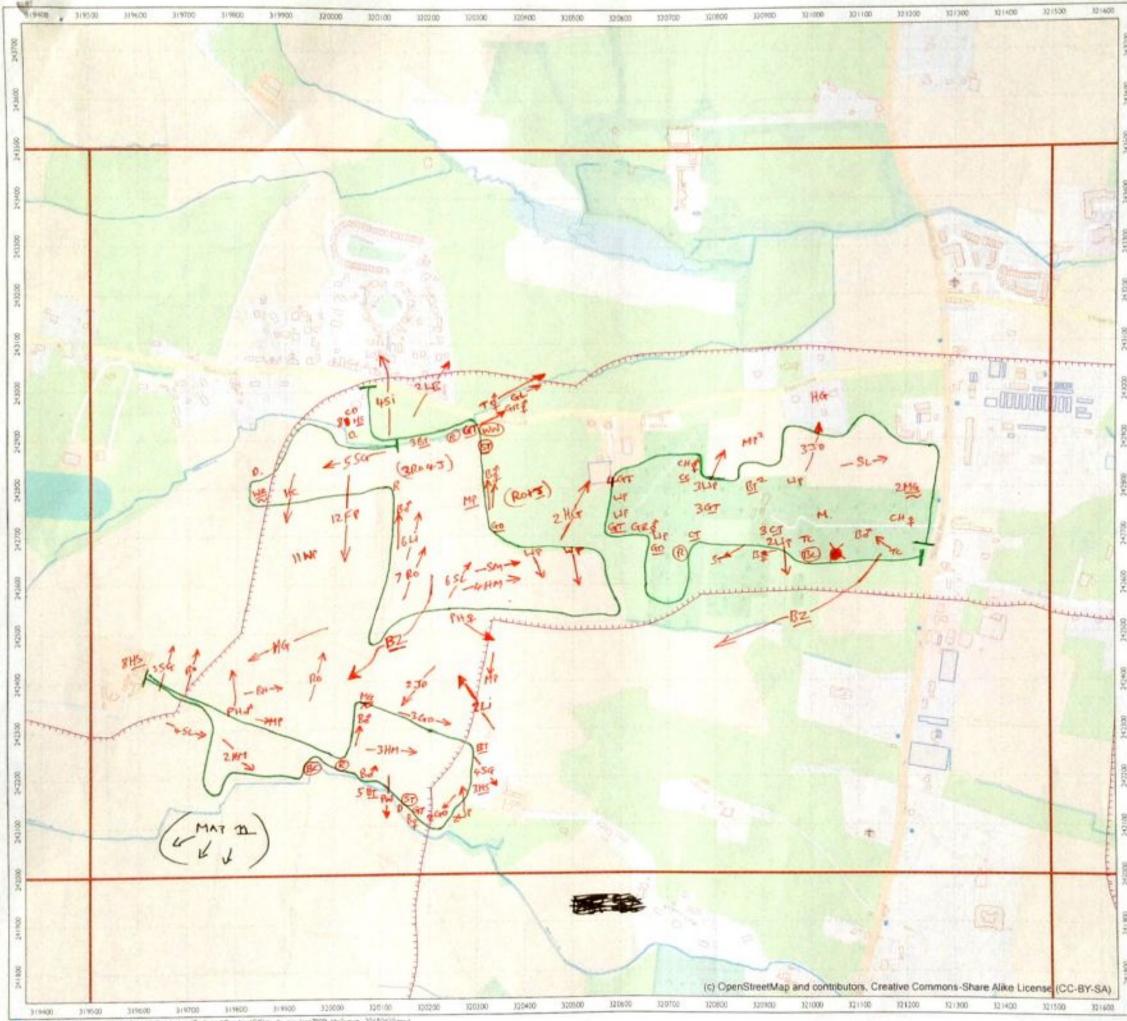


WU1005SEC - RPS Befax, WW ES NS Omeholog//Technical/Oraphic/GS/min/syney/ser7909\_bb/Junio\_20/50021mid


RPS

Surveyor:	Nich	Vecle
Date:	10/06	2015
Start time.		End time: 11:30

\*Please attach weather sheet Notes:

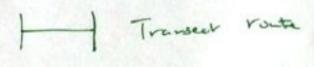



Legend

BBS survey boundary (250 m buffer, supplied 20140420)


Greater Dublin Drainage

Breeding bird survey

Page 3 of 18

* Operditivet)	nd, EPSG 29902 Tap contributoris Repréduis « Government, License No	d from the Ordnesse Survey Of Ineland In
Drawn CH	Checked: D	RAFT Approved DRAFT
Date: 20/0-	/2015 Job No: SE	C7909 Rev: a
Scale	7,500 @A3	-
0	200 m	1

rpagroup.com

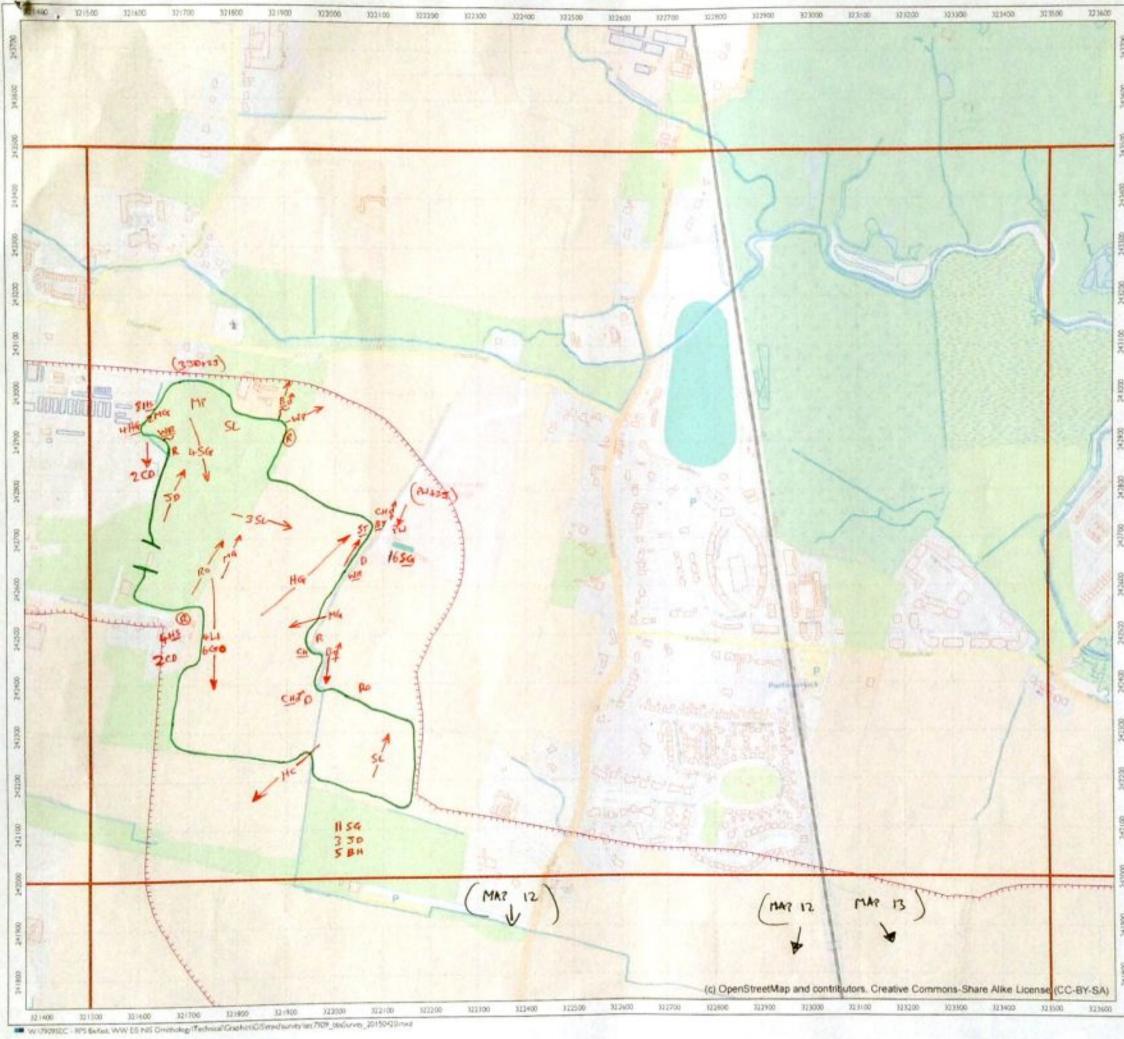

R	PS		
Surveyo	- N	. Ve	de
Date:	10	06	2015
Start tir	ne: OS	5:30	End time: 11:30

Notes:



Legend

BBS survey boundary (250 m buffer. supplied 20140420)

Greater Dublin Drainage

Breeding bird survey

Page 4 of 18


	tonal Grid, (7%)	2 20402 ributors: Reproduced from the I	
Drawn	n CH	Checked DRAFT	Approved DRAFT
Date	20/04/2015	Job No: SEC7909	Rev a
5	cale: 1:7,500	(DA)	-
0		200 m	1

Paratisup.com



RP	S		
Surveyor	Nick 1	Veala	
Date:	1106/20	15	
Start time:	05:30	End time:	11:30

Notes:

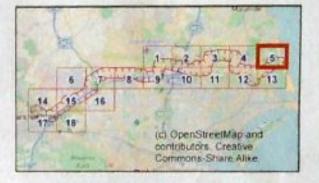

Legend

BBS survey boundary (250 m buffer, supplied 20140420)

Greater Dublin Drainage

Breeding bird survey

Page 5 of 18

0	200 m	1
Scale: 15	500 (BA3	-
Date 20/04/2	015 Job No: SEC7909	Rev a
Drawn: CH	Checked DRAFT	Approved DRAFT
	EPSG 20102 contributors. Reproduced from the Glosenseret License Fes. 3-3-34	e Cristainie Turney Of Second 1




RPS	
Surveyor N. Ve	cle
Date: 1106/2	2015
Start time: 05:30	End time: 11:30

Notes



Legend

BBS survey boundary (250 m buffer, supplied 20140420)


Greater Dublin Drainage

Breeding bird survey

Page 13 of 18


Hati National Grid, EPSG * OpenStrachtap carbo Permission of the Gouern	299kg Indons, Reproduced from the C ment, License No. 3.3-34	And Marcin Survey Of Instand by
Drawn: CH	Checked DRAFT	Approved DRAFT
Date: 20/04/2015	Job No: SEC7909	Rev: a
Scale: 1.7,500	(0A3	-
0	200 m	1

magroup.com

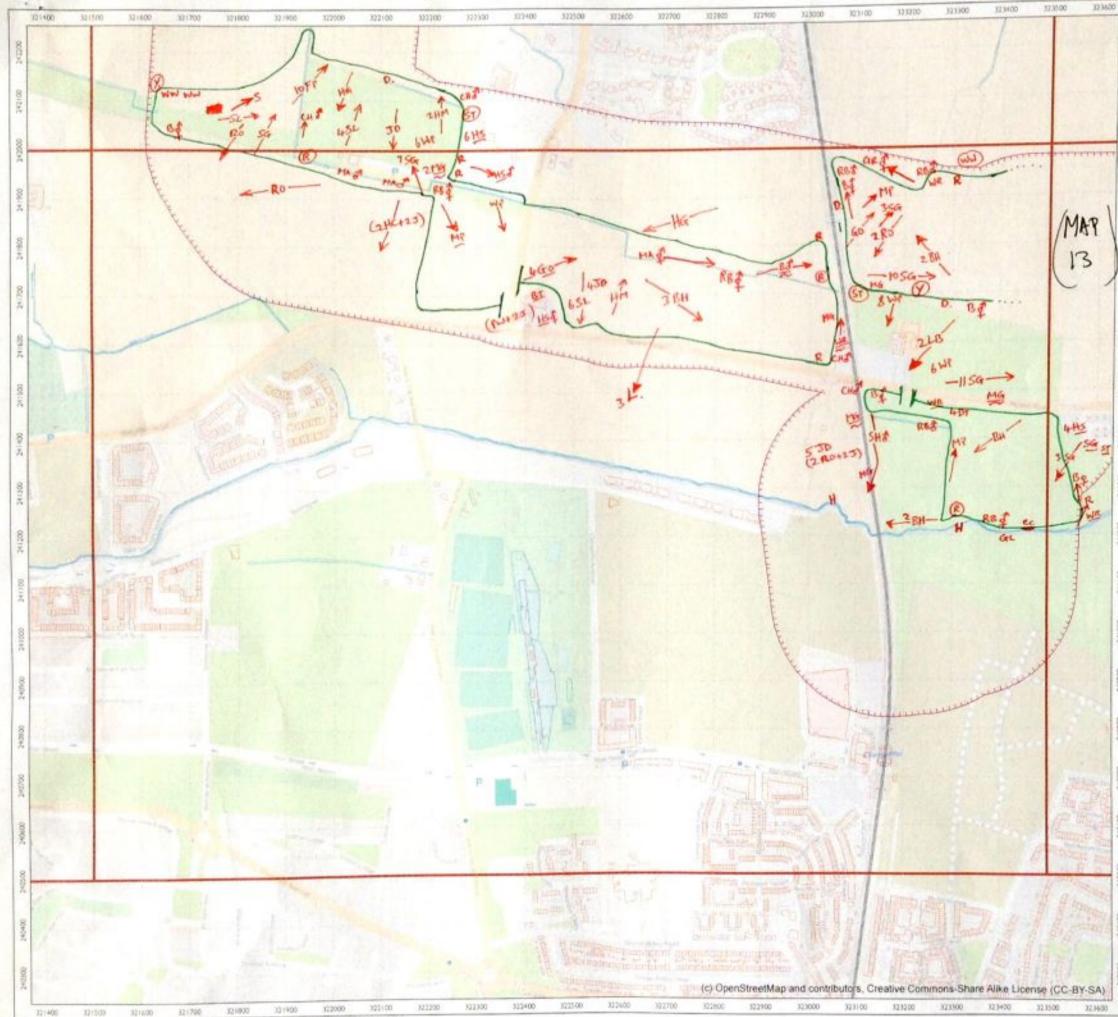

W179095CC - RPS Ballet, WW C5 HIS Ommology/Technical/Oraphics/G59michainery/air/7909\_bbs5anery\_20150450+

RPS Surveyor: Nick Vecce 06 2015 Date: Start time: 05:30 End time: 11:30

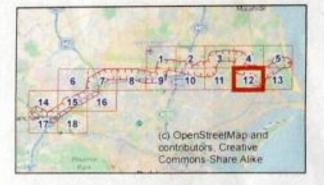

Legend

BBS survey boundary (250 m buffer, supplied 20140420)


Greater Dublin Drainage

Breeding bird survey

Page 12 of 18


0	200 m	1
Scale: 17,500	(A)	-
Date: 20/04/2015	Job No: SEC7909	Rev. a
Drawn: CH	Checked DRAFT	Approved DRAFT
	29902 fotons Reproduced From the C	Orthonie Survey Of Indianal by

rp+proup.com

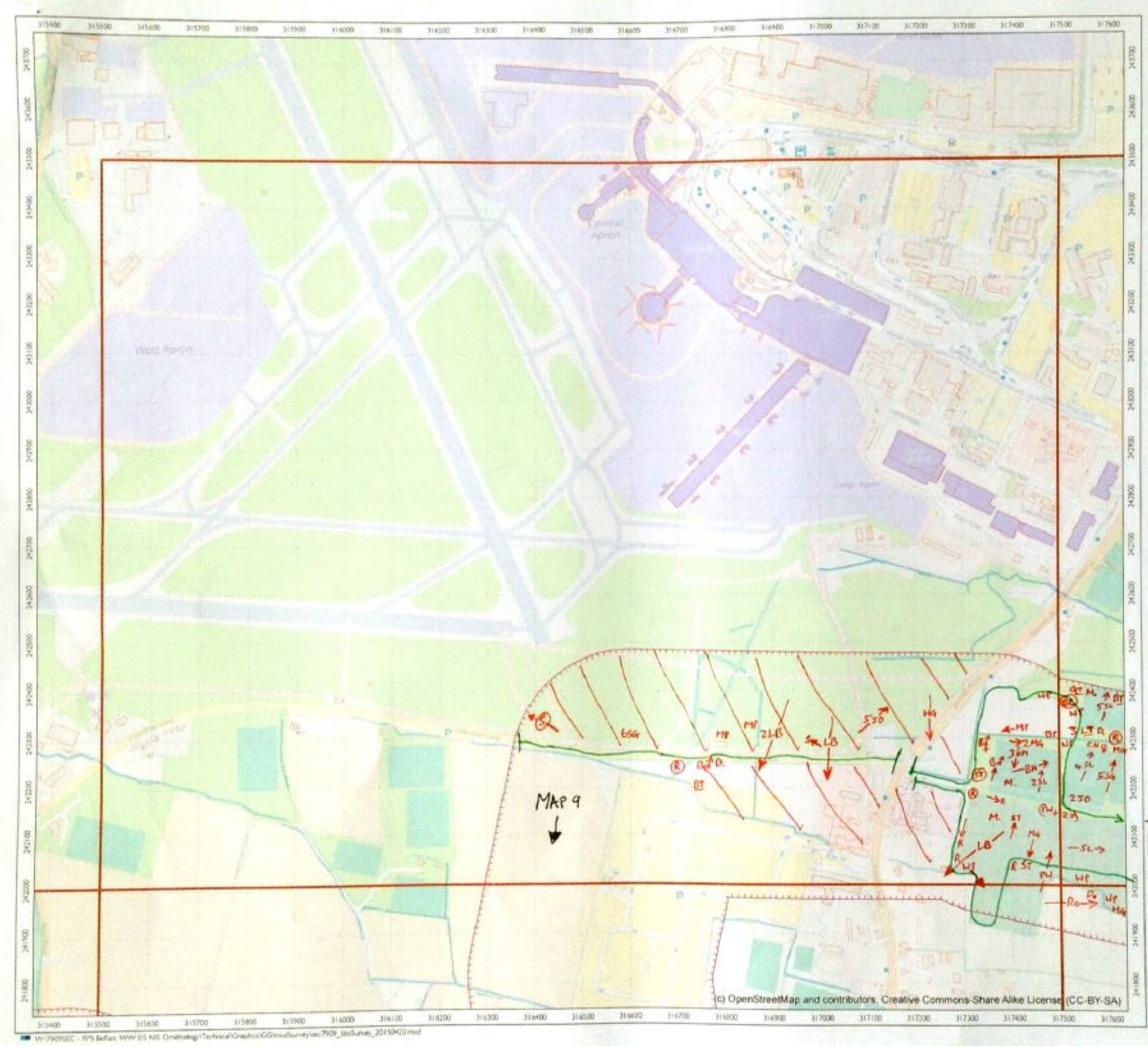

RPS

Surveyor Nick Veale 12/06/2015 Date: Start time: US:40 End time: 11:40 \*Please attach weather sheet Notes:

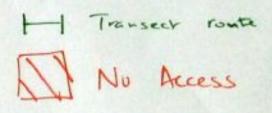




Legend

BBS survey boundary (250 m buffer, supplied 20140420)

Greater Dublin Drainage Breeding bird survey Page | of 18 3 200 m 0 Scale: 17500 (8A3 Date: 20/04/2015 Job No: SEC7909 Rev: a Drawn CH Checked DRAFT Approved DRAFT Insh National Grid, EPSG 20102 \* OpenDreteChap contributing Reproduced from the Optimized Scruey OF related by Permission of the Optimizer License No. 3-3-34


rpsgrrup.com

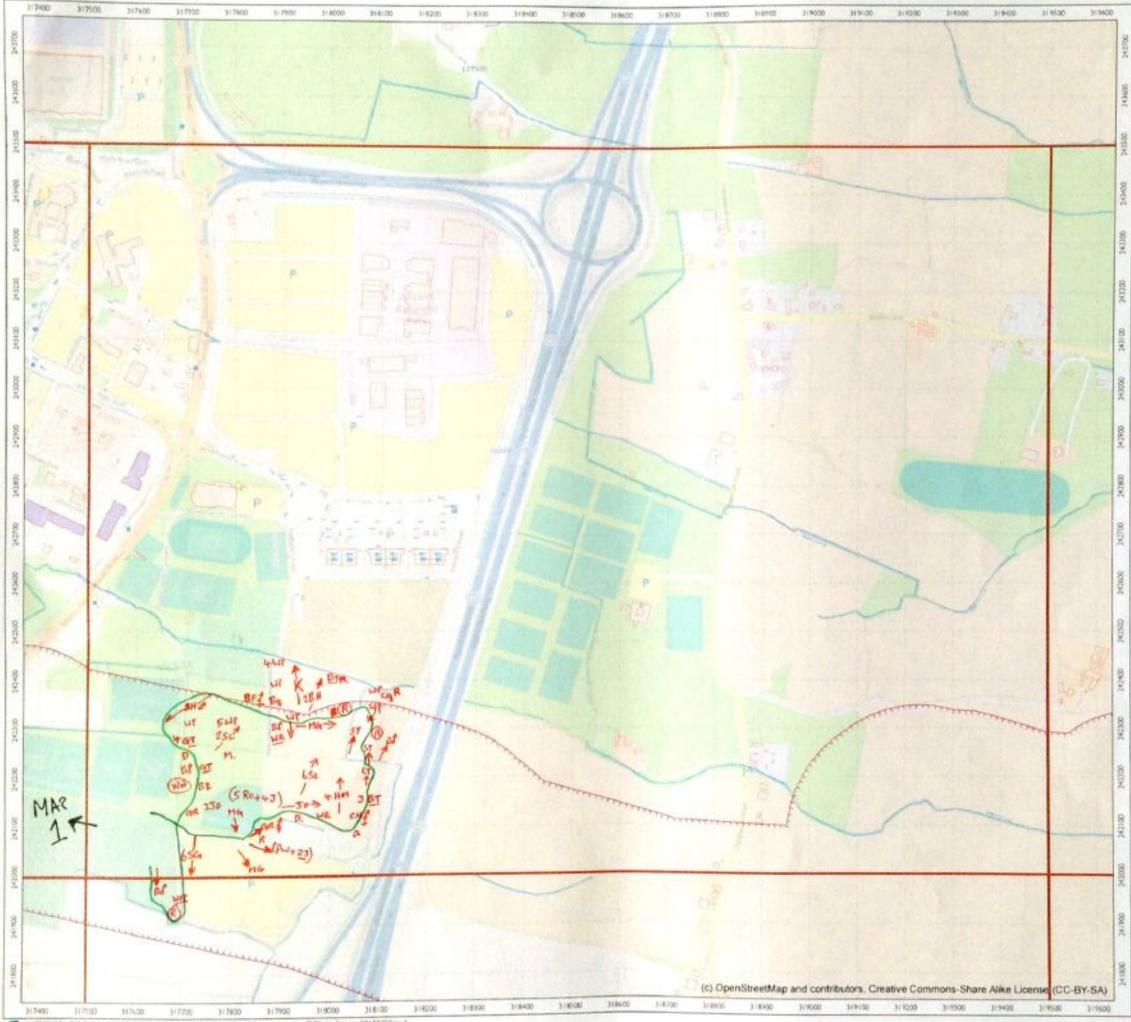

W1090952C - R/S Befait, WW E0.NS Omthology/Technol/GaphcaG5/mx/barvey/aec/909\_techavey\_20150-Q0mwd

RP:	S		
Surveyor:	N	V	erle
Date: 17	2/06/	20	15
Start time:	050	to	End time: 11:40

\*Please attach weather sheet Notes:

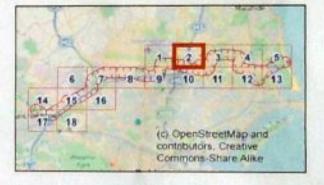

Legend

BBS survey boundary (250 m buffer, supplied 20140420)


Greater Dublin Drainage

Breeding bird survey

Page 2 of 18

Drawn C		Checked: DRAFT	Rev. a Approved DRAFT
Duto: 204	MODIE	Job No: SEC7909	B
Scale	17500	GA3	-
°	1	200 m	1


1010010000

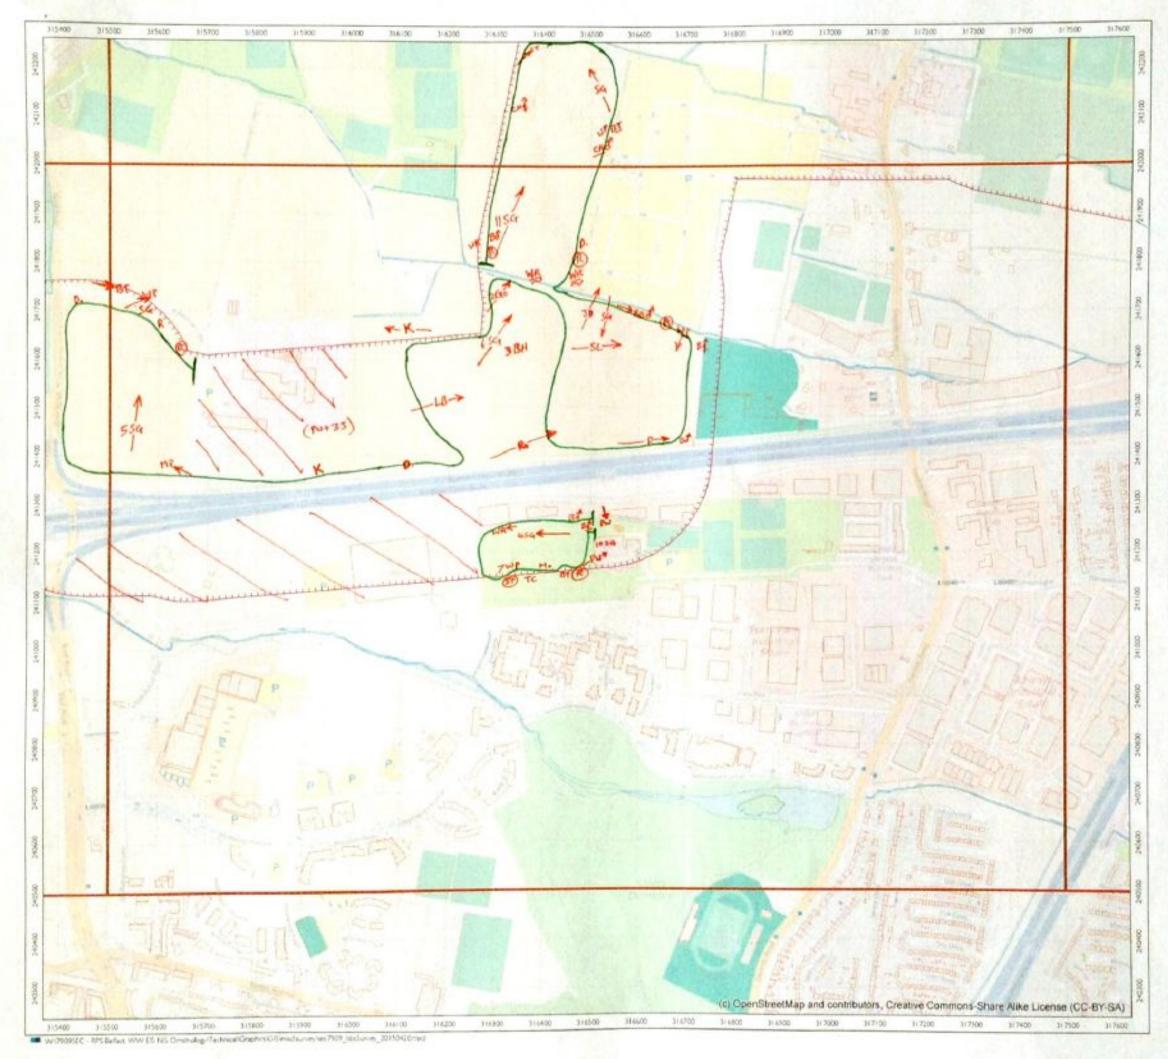

DDS
RPS Nick Veale
Surveyor 12/06/2015
Date:
Start time: 0 5:40 End time: 11:40
*Please attach weather sheet Notes:
H Transent toute
No Access
1.075 M.075
1-2 5574 55
6 7 8 5 10 11 12 13
14 (13 16 17 18 (c) OpenStreetMap and
contributors, Creative Commons-Share Alike
Legend BBS survey boundary (250 m buffer,
supplied 20140420)
Greater Dublin Drainage
Breeding bird survey
Page 9 of 18
0 200 m
Scale: 1/7.500 @A3
Date 20/04/2015 Job No: SEC7909 Rev: a Drawn: OH Checked: DRAFT Approved. DRAFT


Ireh Nesenal Grid, EPSG 29902 \* OpenStreet/tup contributors: Reproduced from the Cininesce Survey Of inland by Permasen of the Covernment Loome No. 5-3-34

rpagroup.com

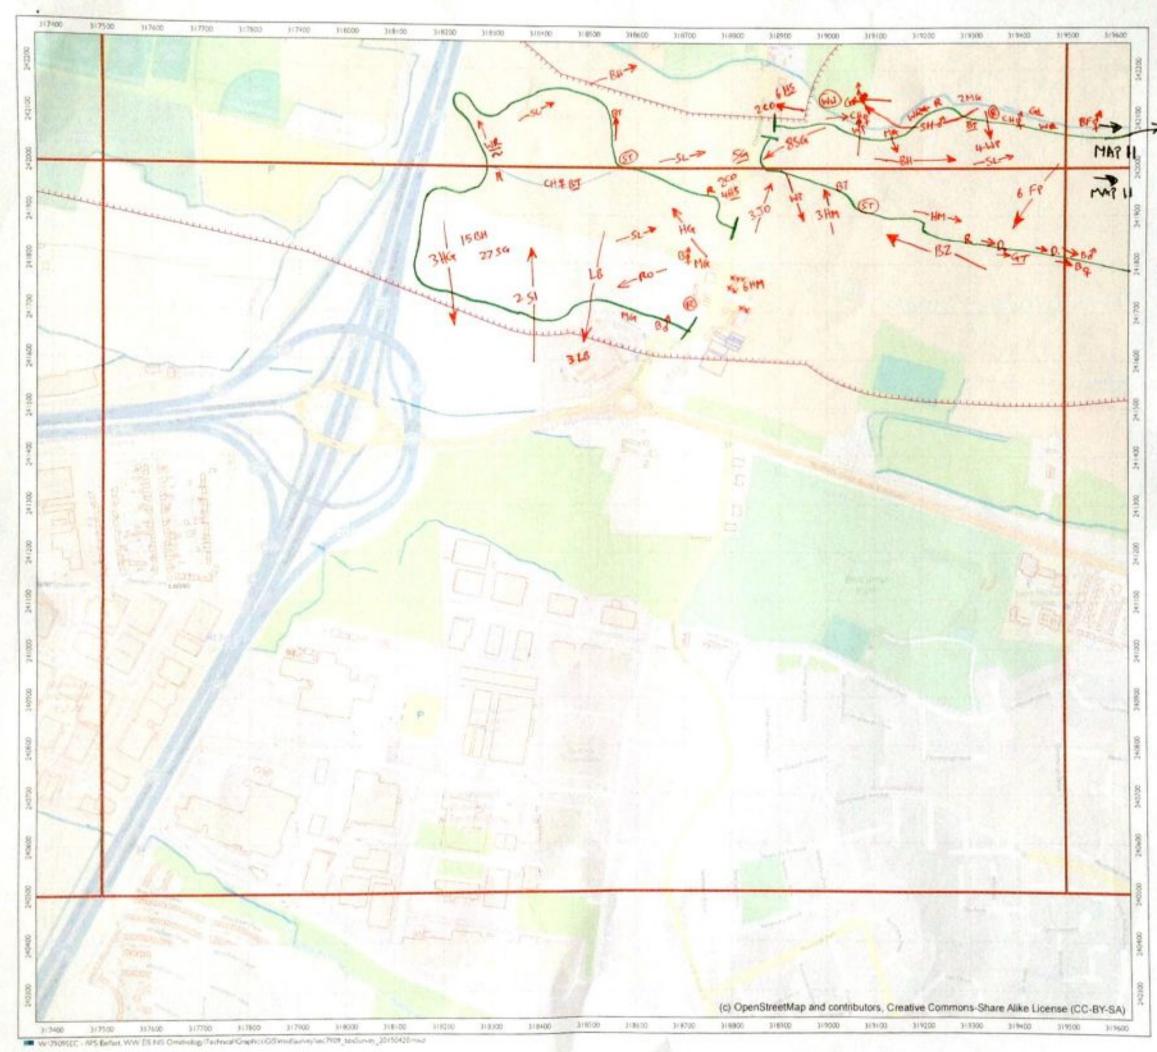


iurveyor Nici		1.1.1
Date: 12/01	skois	
itart time: ()5:4	End time:	11:40
Please attach weat votes:	her sheet	
ransed C	ontinues .	on map !
1 -	used You	-
1 100		
		13
TIM	1	august a
13	in the	SHELL HAR
	1-m2-it	3 4 57
6 7-4	-8-11.9 10	11 12 13
14 15 16	the second se	and the state
a boats page	and the second se	and the second se
17 18		2000-00
175 18		eetMap and Creative
175 18	(c) OpenStr contribution Commons	, Creative
175 18	contributors	, Creative
filmer.	contributors	, Creative
Legend	Commons-	s, Creative Sthare Alike
Legend BBS surve supplied Greater Dubl Breeding bird Page 10 of 18	ey boundary (250 20140420)	s, Creative Sthare Alike
Legend BBS surve supplied Greater Dubl Breeding bird Page 10 of 18	contribution Commons- ey boundary (250 20140420) lin Drainage f survey B	s, Creative Sthare Alike
Legend Legend BBS surve supplied Greater Dubl Breeding bird Page 10 of 18 0 L Scale: 17,500	contribution Commons- ey boundary (250 20140420) lin Drainage i survey 8 200 m	m buffer,
Legend BBS surve supplied Greater Dubl Breeding bird Page 10 of 18	contribution Commons- ey boundary (250 20140420) lin Drainage f survey B	s, Creative Sthare Alike

FEIRgroup.son

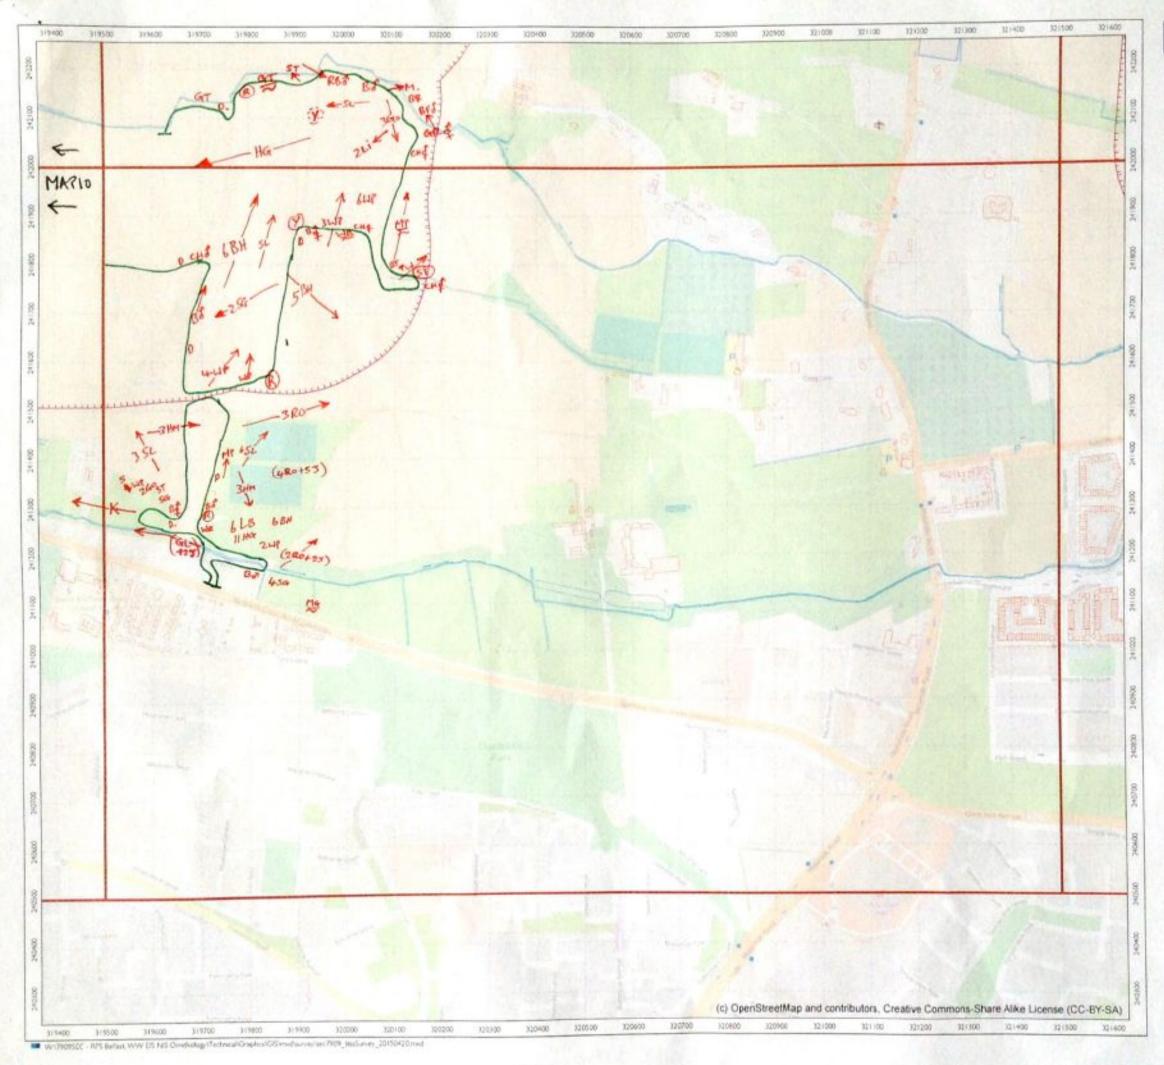

RPS

Surveyor Nick Veale Date: 12/06/2015 Start time: 05:40 End time: 11:40

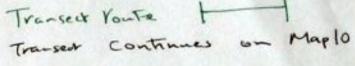



Legend

BBS survey boundary (250 m buffer, supplied 20140420)

Greater Dublin Drainage

Breeding bird survey

Page 11 of 18

	of Grid, EPSG	29902 Sutors: Reproduced Indirative C	
Drawn:	CH	Checked DRAFT	Approved DRAFT
Date 20	04/2015	Job No: SEC7909	Rev: a
Sca	le: 1.7,500	(BA3	*
0	1	200 m	4


rpagenup.com

## GDD Oral Hearing Response to Inspector's Questions

## APPENDIX 7 SUMMER 2017 (MAY AND JUNE)


The data from the May and June 2017 summer walkover surveys were mapped, and are enclosed below (along with the associated survey recording sheets).

	We	Weather Sheet	Te a	S pulm	peed		Direction	AsinSnow	3	Cloud Cover	Cloud Height	Visibility
				-	Beaufart	_	;	1 and	5	In all when	Height of cloud	
Site	0	600		Light ar	-	7 2	2 2	Prizzle/Migi		e.g. 38	above average height of	Ë
Date	13	13/06/201	6	Light breeze Gentle breeze	teze 2 Meeze 3	4-7 8-12	th ch	Light showers Heavy showers	rers 2 mens 3		viewshed	Good (>3kmi 2
Survey	9	035		Mod. breeze	eze d	13-18 14:00	نې تو تو	Heavy ram Livley Sev		Enct	<150m 0	
Observer		N. Voue		Sirong breeze	areze 6	25-31	Mo	unio fiuita	-		>500m 2	
Start Time	æ	SHSO	Τ	Mod. gale Fresh gale	는 87 은 18	32-38 39-46	MN	Nor Sie Sie	o –	Nora Gound	Please be as acc.	Please be as accurate as possible, with
Finish Time	+	12:00		Strony gale Whole gale	-	47-54 55-63		High-Oround		All day 2	Manuscr outers, emering only on Not 3 runge, e.g. WS - 5, not 5-6. Hise ones for Anta into	waateer oorare, emering ony energuie, Not a range, e.g. WS - 5, not 5-6. Hee notes for ears into
Sheet 1/	&[ ]#	] Maps attached	ched	Storm Hurricané	4 1 1 1 1 1	64-72 73+					E.g. WS - 5, gusting & (in roles)	ng & (in roles)
Weather	<u> </u>	Wind	Rain	Cloud	Cloud	Visibility	Frost	Snow 1	Voles(e.g.	Notes(e.g. temperature)	re)	
Hr 1		Circlion S	-	- 1 COVER	1 Interchart	a		1	1021			
۲. ۲	· ~	33	. 0	710		4	Ì	(				
е Т	M	ZE	0	6/8	رم .	2	1	1	14.5			
Hr 4	7	3	0	6/8	4	Ч	1					
Hr 5	3	ર	0	718	۲	2	1	1	2491			
Hr 6	3	SW	0	214	2	2	1	1				
Hr 7	3	Su	2	818	-	2	1	1	78°C	surrouls	\$	
Hr 8												
Field Notes: Maps attached	tached											
	90											
For office use only. Initial AND date AL	For office use only. NB- Initial <u>AND</u> date <u>ALL</u>	pattory		Databas	se Entered		Database Validated	(alidated	GIS	GIS Entered	GIS Validated	idated
Doxes.						_			_			

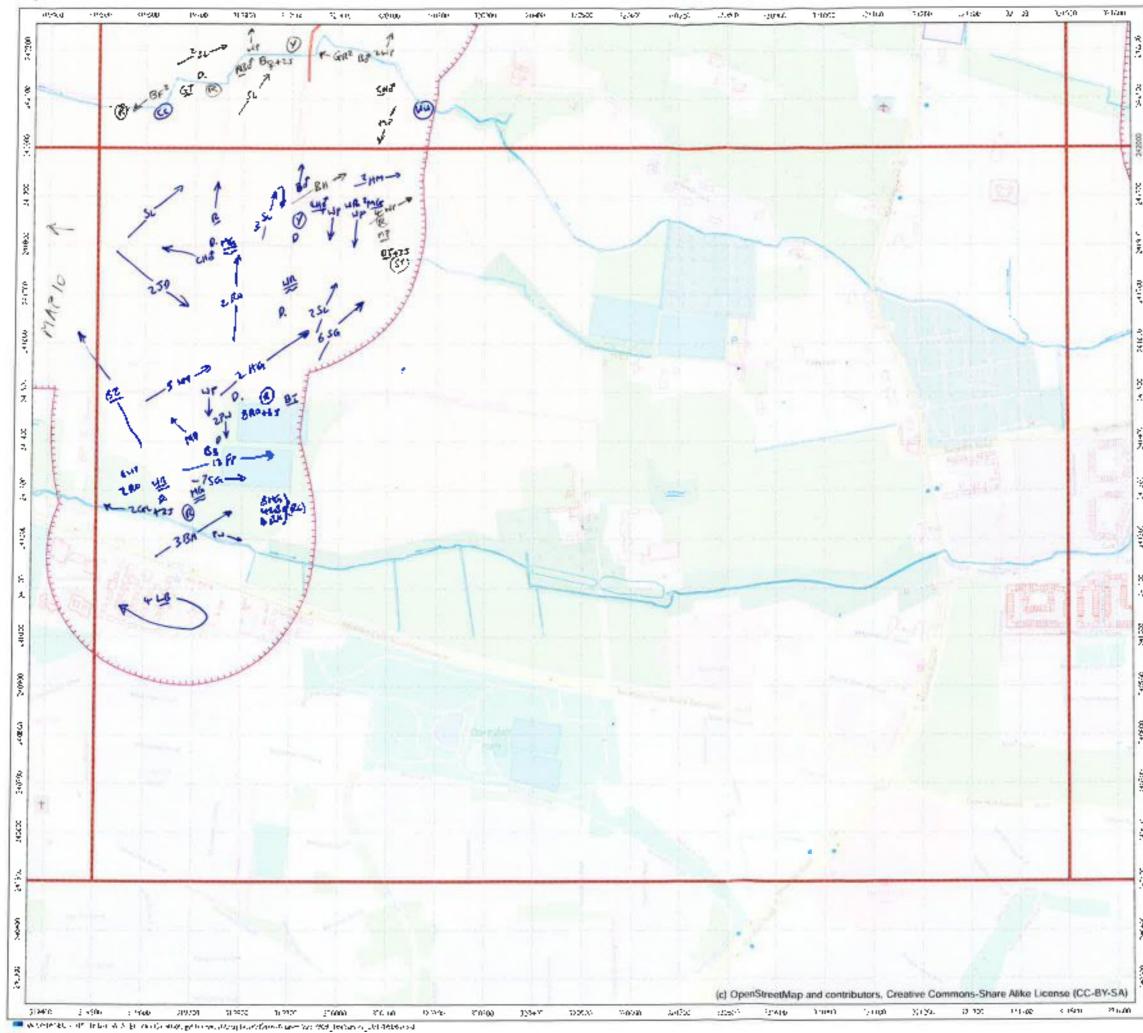



Surveyor, N	. Vea	la_	
Date 13	1001	2017	
Start time: 📿	5:45	Frictume.	12:00

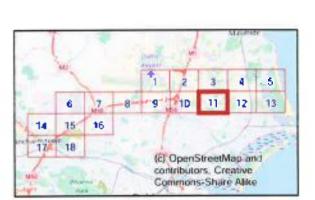

## Layenc



BBS/WAVO survey boundary (250 m. buffer of route supplied 20170405 appended to previous boundary)

Pipe route (supplied 20170405).

Greater Dublin Drainage

Breeding/winter bird survey


Page 11 of 18

5	200 m	4
viale 1:7500	Gi4?	~
Date: 06/04/2017	job Nor 5507909	Recip
Craser OII	Checked: DRAFT	Approved DRAFT
		rpeoroup.com





Surveyor Nich V	leale
Date 13 06,	2217
Stars time: OS/45	End time. 17.100

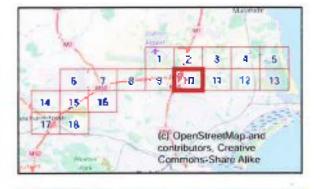

egend



BBS/WWO survey boundary (250 m buffer of mule supplied 20170405 appended to previous boundary)

Pipe route (supplied 20170405).

Greater Dublin Drainage


Breeding/winter bird survey

Page 10 of 18

	° LL	20C mi	4
	Stale: 17,500	2004 A	-
	Date 06/04/2017	Jub Nia SEC7509	Rev c
	Orgon CH	Kihecked DOATT	Approved DRANT
-			(psycore) cam









ioles: ps attached ice use only. NB- Logged Database Entered Database Validated GIS Entered	Hr 7	N	3	0	6/8	2	2		1	non			
totes: ps attached lice use only. NB- Logged Database Entered Database Validated GIS Entered	Hr 8												
ice ver only. NB- Logged Database Entered Database Validated GIS Entered	Field Note: Weps at	lached											
ice use only. NB- Logged Database Entered Database Validated GIS Entered													
	For office us Inttel AND of hotes.	se only. NB- tate <u>ALL</u>			Databa	se Entere		alabase V	/alidated	GIS	Entered	GIS Val	idated

.\*

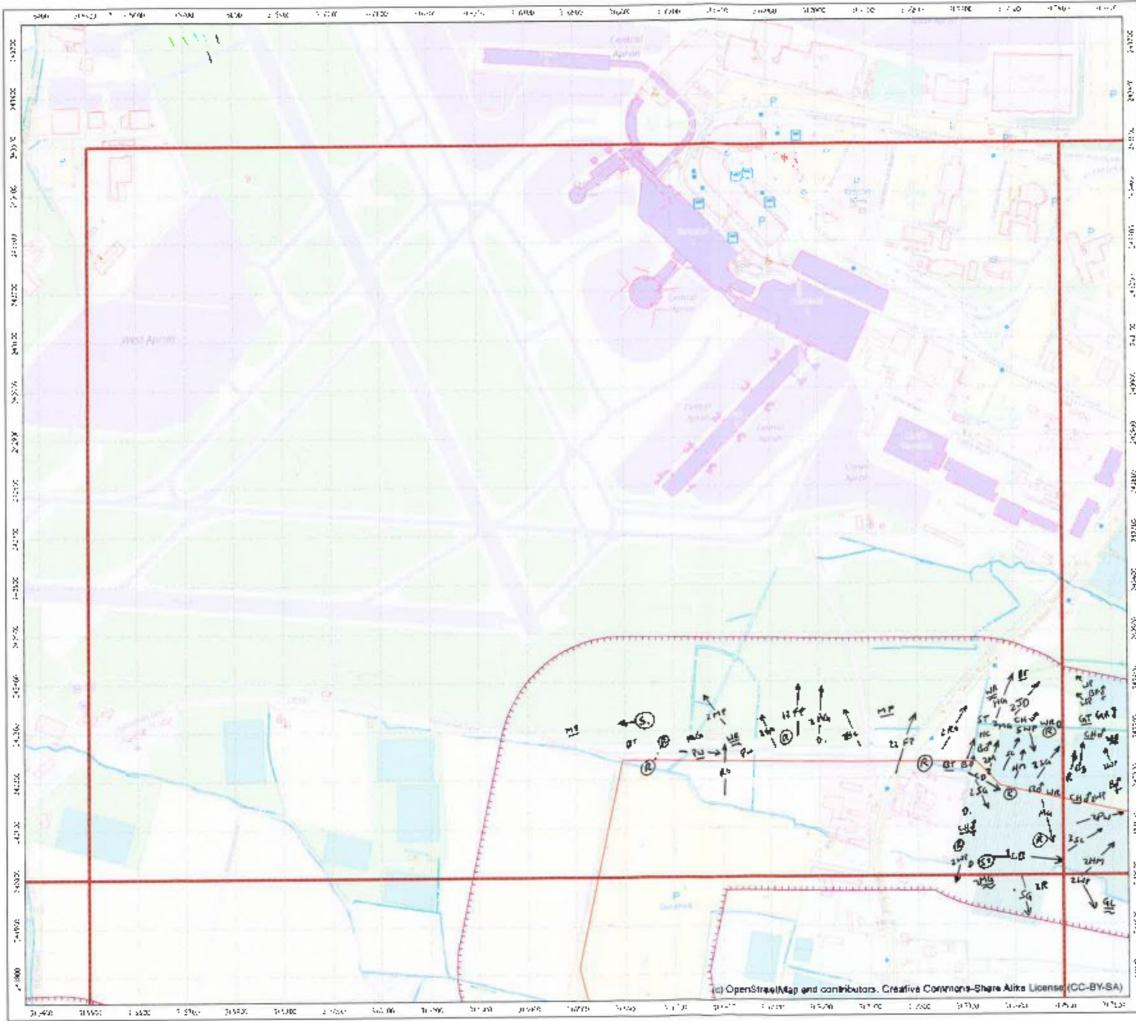



		-	-	
	R	Р	5	
- 1	~	٩.,	-	0

Surveyn N. Ver	l-
Date 06 1061	(7
Start time 06;30	End time: 12 200

\*Please attach weather sheet Notes.

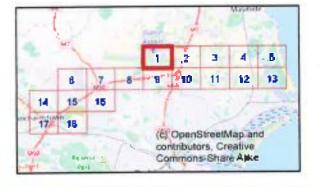

Legend

BBS/WWO survey boundary (250 m buffer of route supplied 20170405 appended to previous boundary)


Pipe route (supplied 20170405).

Greater Dublin Drainage

Breeding/winter bird survey

Page I of B

a L	200 m	4
Scale 1:750	10 k/4+ !	~
Date 06/04/00	7. job No. SEC7929	Nev c
Drawn CH	Classed DRAFT	Approved 108A-T

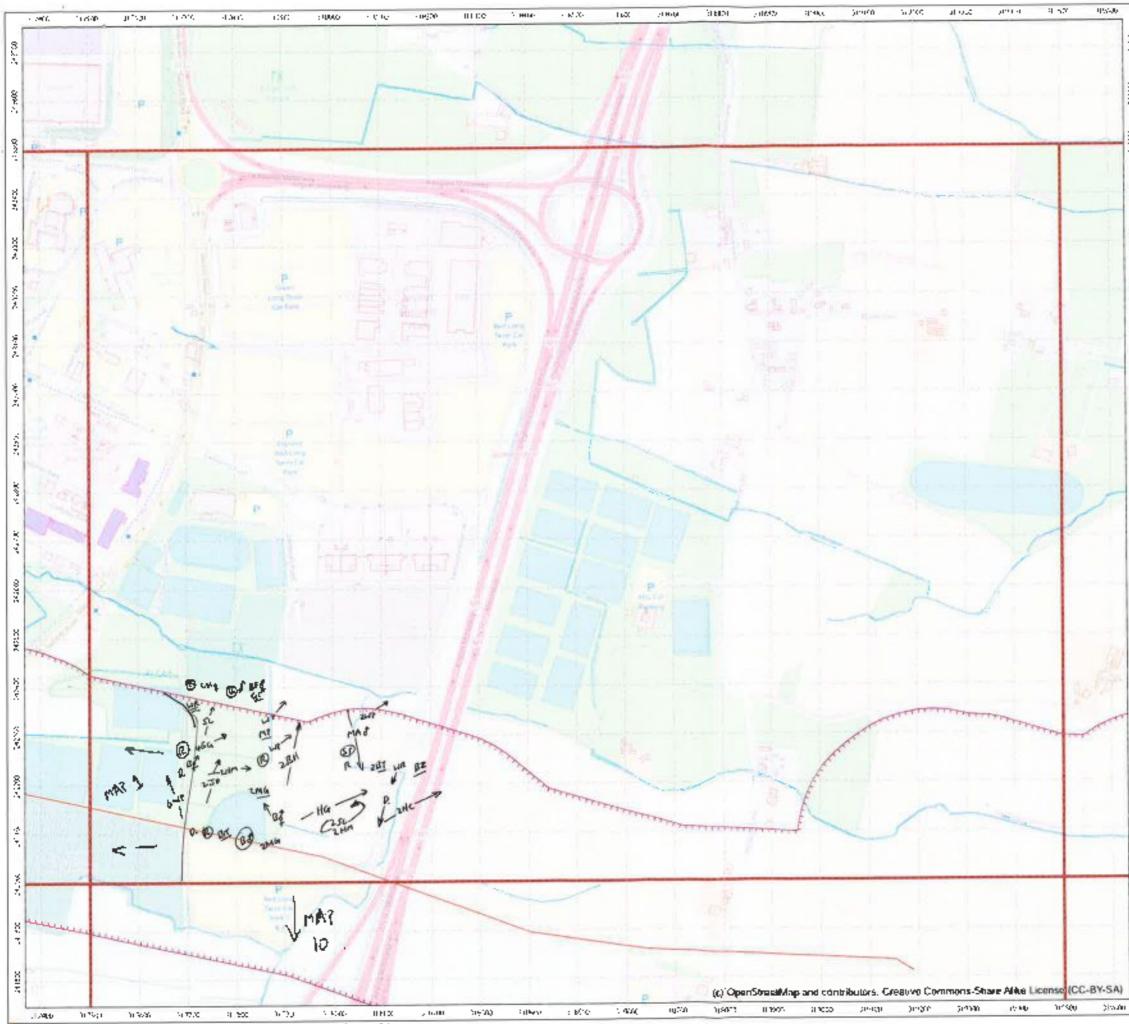





Surveyor	N	, çlık	Ve	يدلع	
Date	ОЬ	10	6]	17	
Start time	06	:00		Lod trife	12:00

\*Please attach weather sheet Notes:

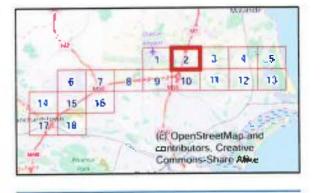

Logend


(BBS/WWO survey boundary (250 m) ouffer of route supplied 20170405 appended to previous boundary)


Pipe route (supplied 20170405)

Greater Dublin Drainage

Breeding/winter bird survey

Page 2 of 18

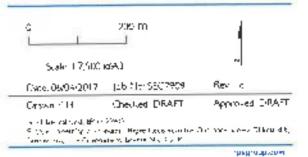

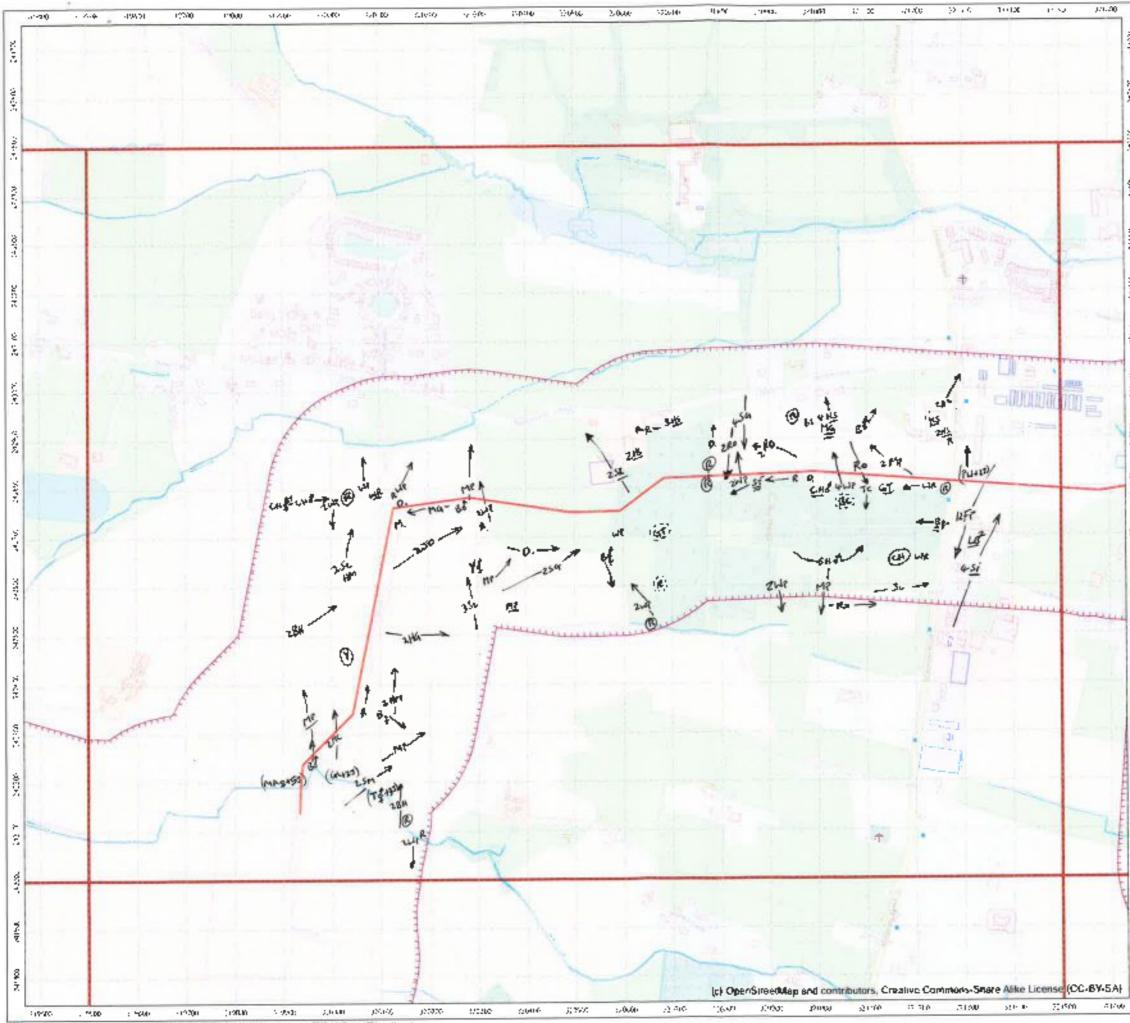





Surveyor	*	J, √	e.ale
Date	06	106/	2017
Start time	063	30	Find time: 12100

\*Please attach weather shoet Notes.

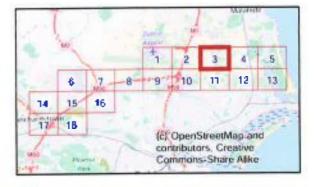

Legend

BBS/WWO survey boundary (250 m buffer of route supplied 20170405 appended to previous boundary)

Fipe route (supplied 20170405)


Greater Dub in Drainage


Breeding/winter bird survey

Page 3 of 19

0 	20) m	
Date 05/04/2017	pt No 3403409	Res of
Disson CH	Checked, DRAFE	Approved DRA-1

	БР	3	Weather Sheet	ee1	Wind Speed	Speed		Direction	RairuSnow	MOL	Cloud Cover	Cloud Height	Visibility




	Hr 7	m	z	0		2	<b>د</b> م		1	15%			
Field Notes:	Hr 8												
Maps stlached	Field Notes Maps all	ached											
			- F				Ì			1			
	For office use only. NB- Infusi AND date ALL	a only. NB ata ALL	- Logged		Databa	Database Entered		Database Validated	Validatec		GIS Entered	GIS Validated	dated

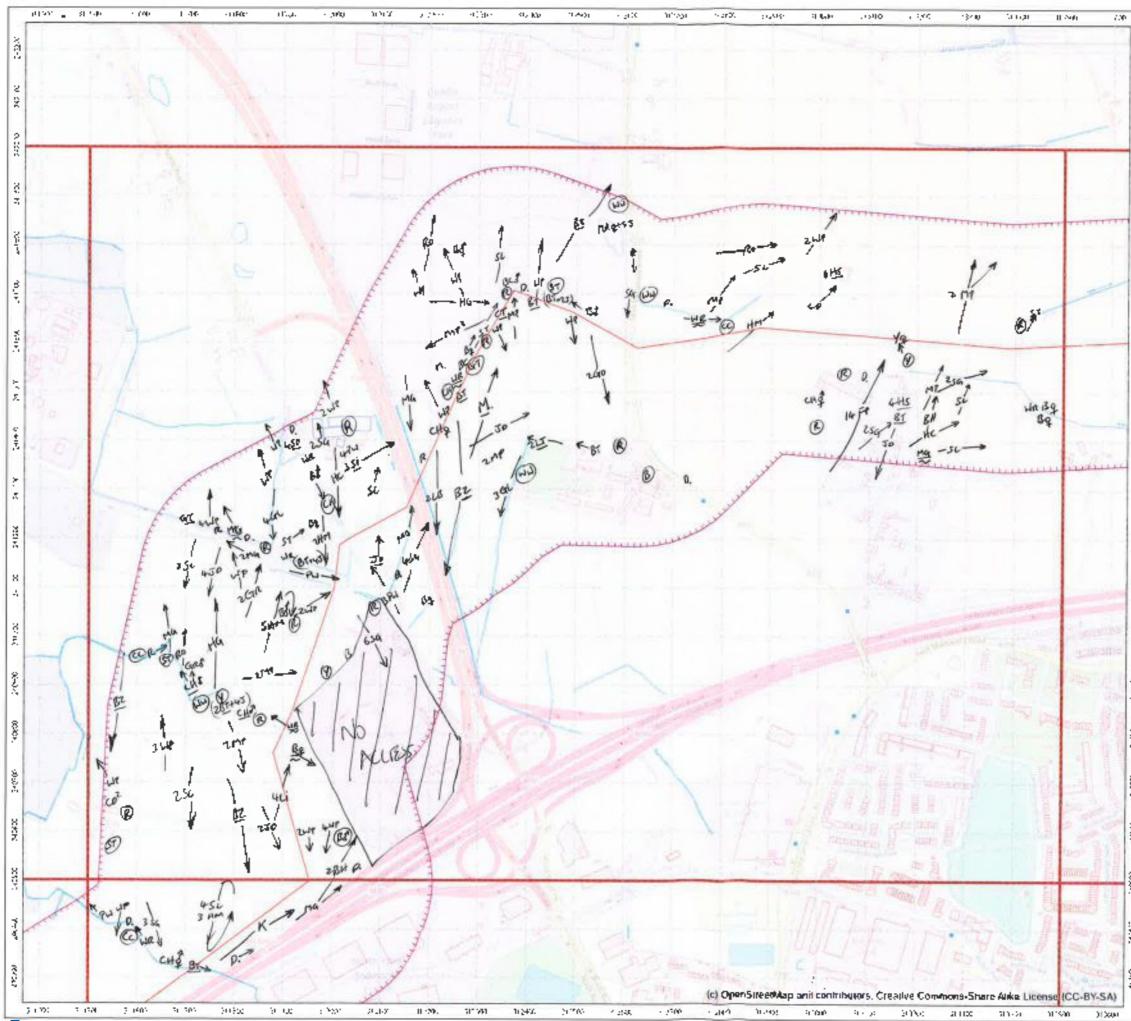

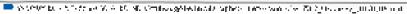

RP5	
surveyos Nich	Vech
Date. 05 /06	2017
Start time でもつい	End time 12:00

\*Please attach weather sheet Notes



cegend



BBS/WWO survey boundary (250 m buffer of route supplied 20170405 appended to previous boundary).


- Pipe route (supplied 20170409)

Greater Dub in Drainage

Breeding/winter bird survey

Page 7 of 18

Scale 17 500 (04.)	Approved CB	Checked (PRAFI	Evaluation (CH)	
Scate 1-7 SU() #(4-1) **	Rev ic	Jab Mar SEC7909	Date 06/04/2012	
		an a	Scale 1/7 SUG	

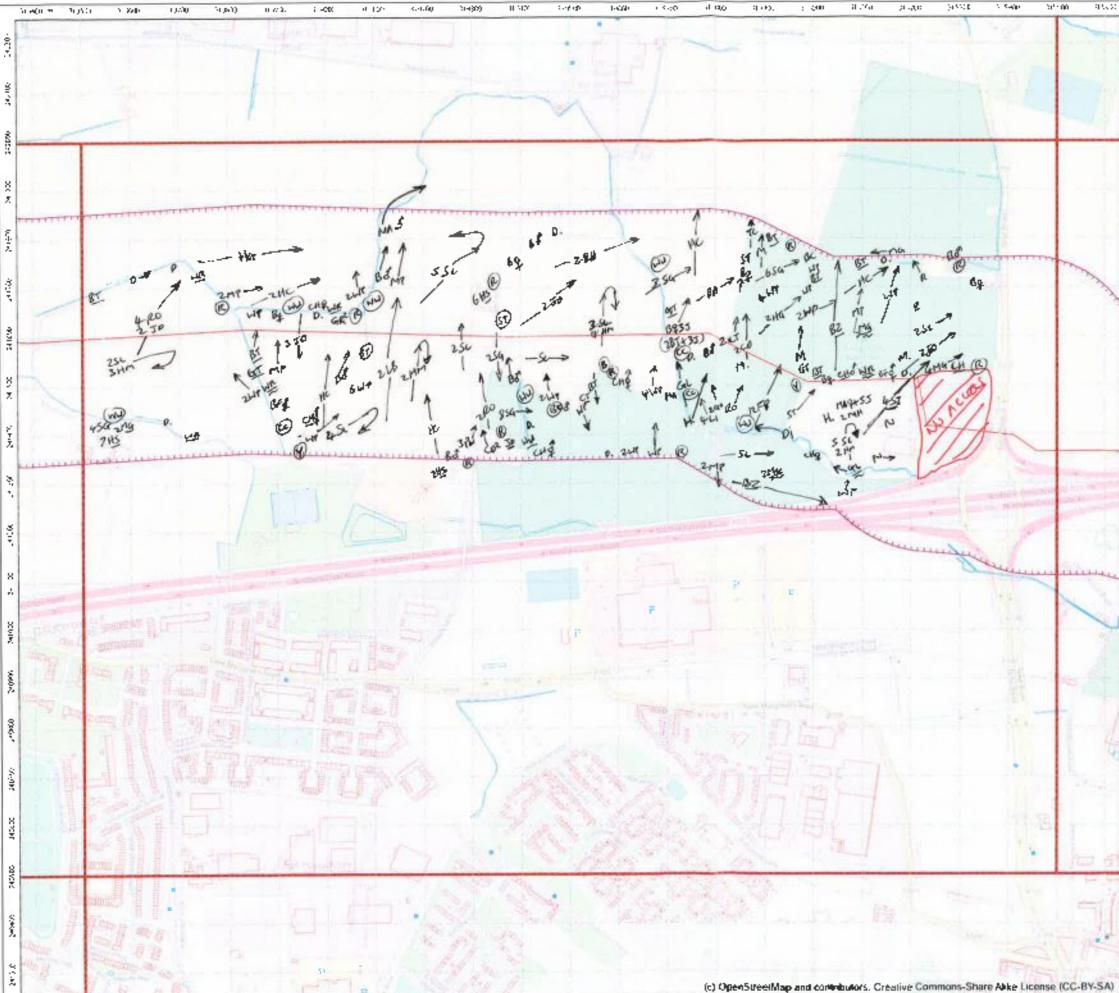

0.655

· -004

(14/0) (14/0)


10.00 Aug. 6 a.	
<b>DDC</b>	
KF5	

Surveyor	Nic	n	Vector	
Date:	05/	06[	2017	
Start time:	05 3	]ა	Food time.	2:00

\*Please attach weather # cet Notes:

211120

24.002

8

8

5

Χ,

 $\mathbf{z}$ 

8 л

17

N90-2


24,3370

9

2117

93500

Aller

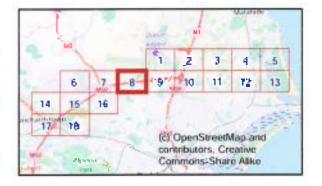

l egend

BBS/WWO survey boundary (230 m buffer of route suppled 20170405 appended to previous boundary)

- Pipe route (supplied 20) 70405)


Greater Dublin Drainage

Breeding/winter bird survey

Page 8 of 18

î L	200 m	4
Scale 17500	KIA :	~
Date 06/04/2017	Job No. 590,7909	Bes 1
Drawn CH	Checked DRAFT	Approved ONARE
		(psgroup cont


	$\vdash$		Γ					3		Gloud		
RPS	ew.	Weather Sheel	eel		opead Beaulan	Mah n	ngilagnu	Moncuran	3	Cover	Cloud Height	VISIONALY
Site		00	Τ	Callin Leght air			z¥	None Onzzla/Met	o -	In cighths e.g. 38	Heigh ul cloud above average	Poor (k filon) 0 Moderata (1-3km) 1
Date	0	06	512	Light breeze Genile breeze	aeze 2 Drefize 3	<b>4</b> -7 B-12	ш Ш	Light showers Heavy showars	51	,	леқта мемећеđ	Good (x3km) 2
Survey	1	SILS		Mod. breeze Greek Meeze		13-18 13-24	ŝ	Heavy rain		East	<150m 0 400 cm/m 0	
Observer		Nick Verts		Strong breeze	Diffecte D	15-51		MOUE BUIKS			2 m003<	
Start Time		05:30		Mod. gate Fresh gate		32-38 36-46	MN	None On sute	o		Please be as accu	Please be as accurate as possible, with
Finish Time	-	00.21		Strong gala Whole gala				High ground		All day 2	Meaniner details writering c/ly on not a range, e.g. V/S + 5, not 5-6. Nea notae for early livio	Meanner details Anternop Carly one ligure, Abi a range, e.g. WS v 5. not 5-6. Lise more for early into
Sheet 1/	&[ ]]	] Maps attached	ched	Storm Humicane	e ₽	64-72 73+					E.g. WS - 5, guabing 6 [in notes]	a mo. 1g 6 (in noks)
Weather	Wind	pui <sub>M</sub>	Rain	Cloud	Cloud	Visibility	Frost	Snow A	Votes(e.g.	Notes(e.g. temperature)	(e)	
-	speed	direction	<	COVER	neight	•			100			
	\$	3	2	12	(°)	-4			4			
Hr 2	~	2	0	512	4	~	1		1200			
Hr 3	m	2	0	2/2	4	~	ţ	1	13°C			
Hr 4	÷	3	0	248	2	2	1	1				
s Ť	>	3	0	3/8	2	2		[	15°C			
H, G	٤	3	0	418	2	۲,	1	,				
Hr 7	М	3	0	418	2	2	1	_	200			
Hr 8												
Field Notes: Maps attached	s: ttached											
For other use only. Initial <u>AND</u> date <u>ALL</u> boxes.	For office use only, NB- Initial <u>ANC</u> date <u>ALL</u> boxes.	Logged		Dalabas	Dalabase Entered		Database Validated	'alidated	GIS	GIS Entered	GIS Validated	daled

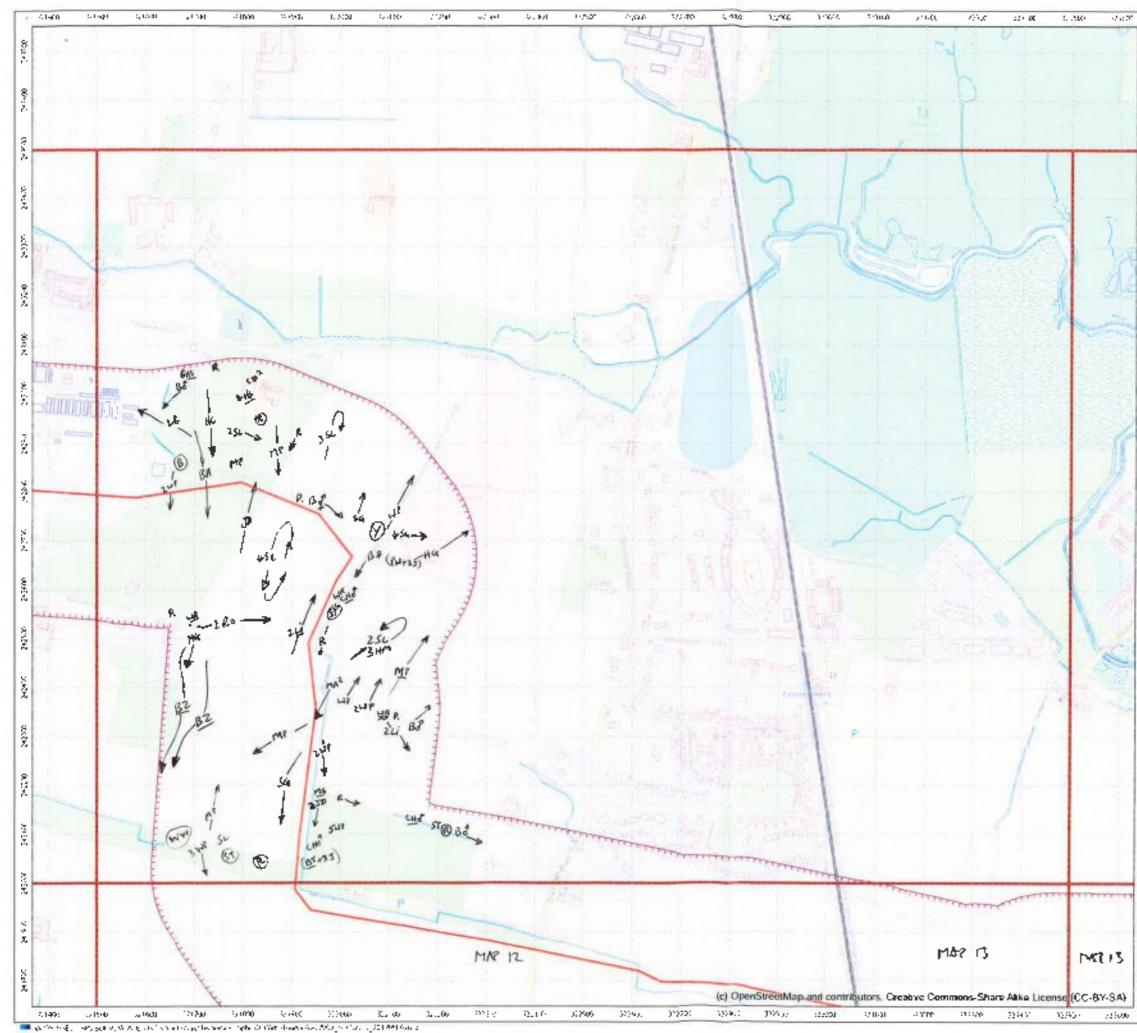



Surveyor.	N.V.	
Dat <del>e</del>	07/0	16/2017
Start time:	05:30	End time: 12:00

\*Flease attach weather sheet Notes:

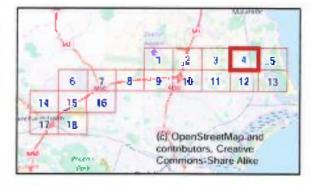

Legend



685/WWVO survey boundary (250 m tuffer of route supplied 20170405 appended to previous boundary).


Pipe route (supplied 20170405)

Greater Dublin Drainage

Breeding/winter bird survey

Page 4 of 18

0 L	1	:00 m 	1
Se	ale 1/7.500	<i>9</i> 41	-1
Date 0	w06/2017	Job Nor SEC7909	Hey in
Drawn	Ç(1	Checked DRATE	Approved DRAFT

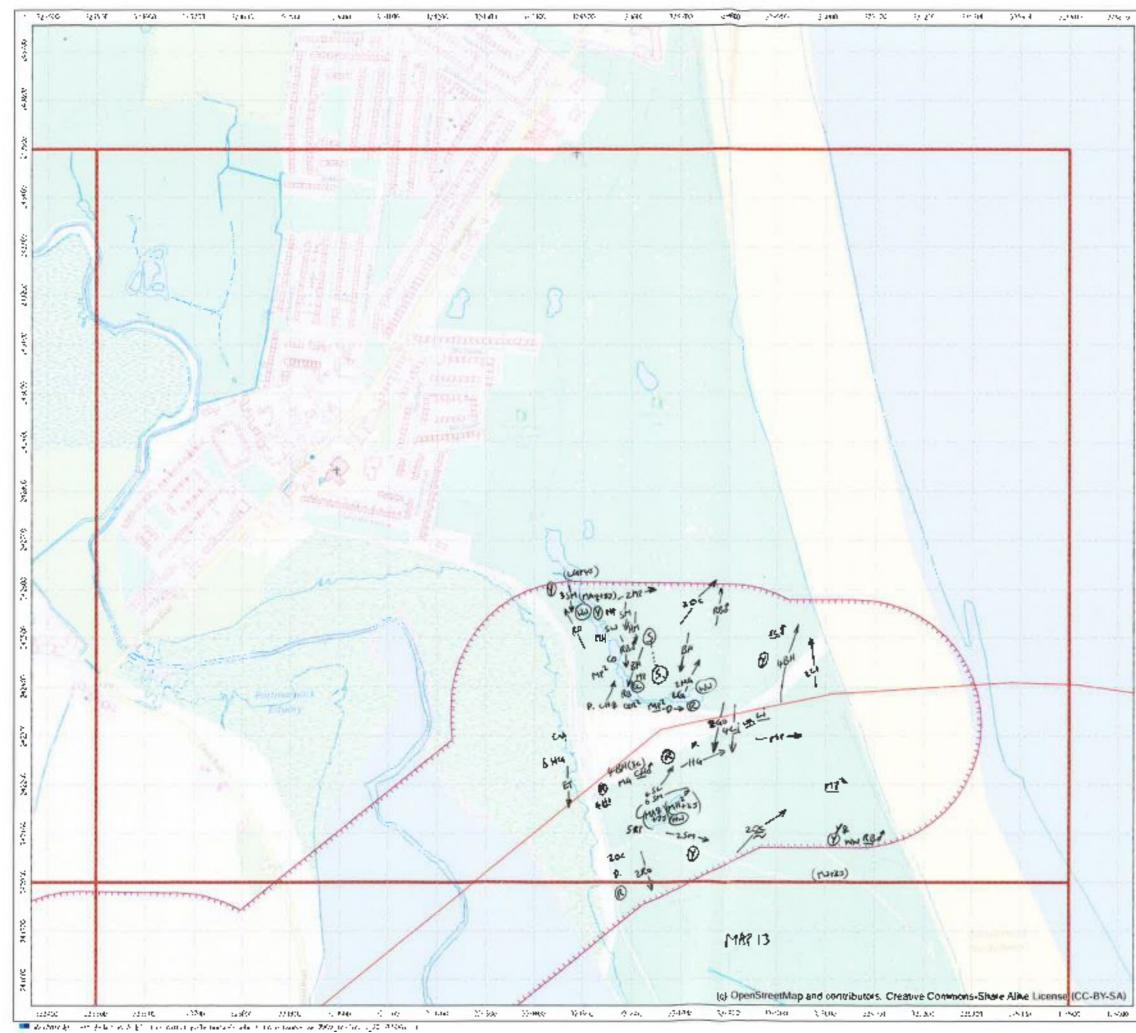


DDC	
RPS	

2

surveyor. Nich-	. Veal
Date: 07 /00	6/2017
Start time 🖉	End time: 72100

\*Please attach weather sheet Notes

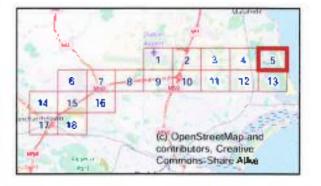

Legenc




BBS/WWC survey boundary (250 m buffer of route supplac 20170405 appended to previous boundary).

Fipe route (supplied 20, 70405)


Greater Dublin Drainage

Breeding/winter bird survey

Page 5 of i8

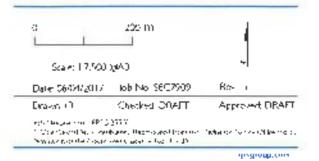

ŝ ŝ 10.00 ŝ 2020 3

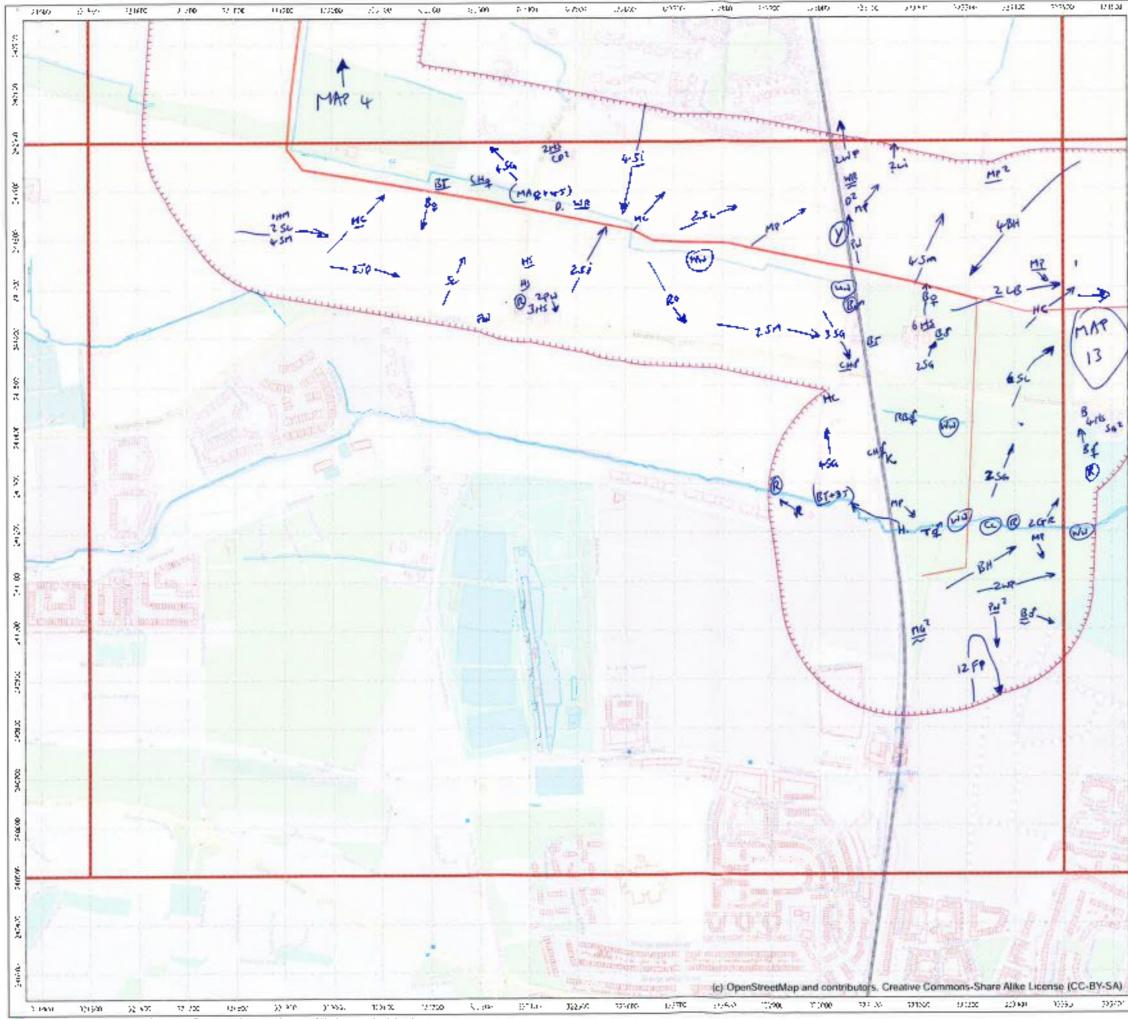


RPS	NIN	hi Vene
Surveyrat	07/06	2017
Oate:	<b>\$</b> 5	
Start time	55:30	Find time 12:000

"Flease attach weather shoot Notes:

ğ

Ş.

241200

х

×.

2


2

Contraction of

000

1

ŝ

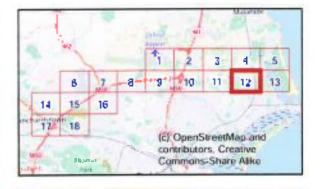

## Legend

BBS/WWO survey trounclary (250 m. buffer of route supplied 20 70405 appended to previous boundary)

Pipe route (supplied 20170405).


Greater Dublin Drainage

Breeding/winter bird survey.

Page 12 of 18

0 	200 m 	-
Date: 0+30472017	Job No SEC790M	Rev t
Disko (C)	Checked (CRAFT	Approved DRACI

(psqrcup.com

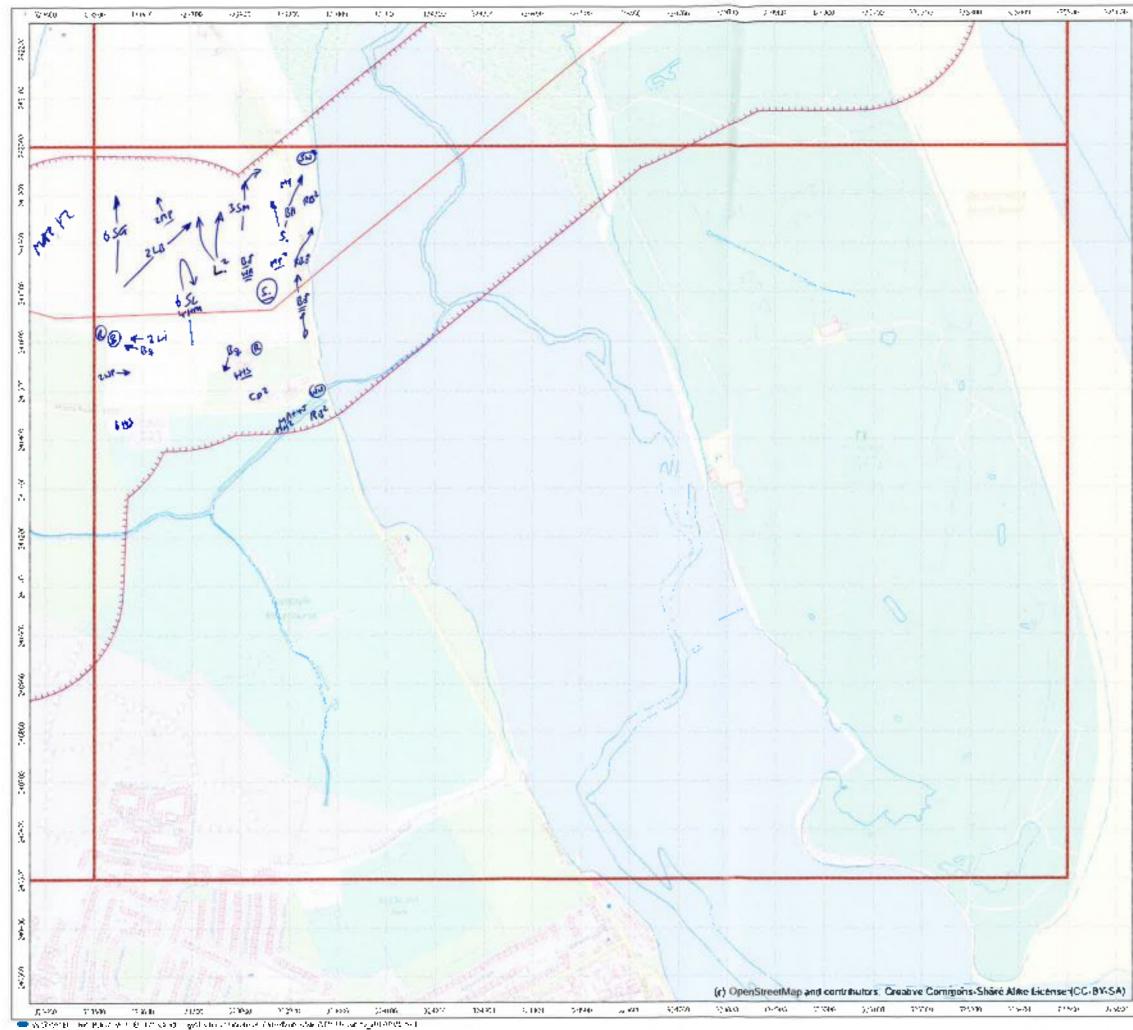




Surveyon	N.a	~ Veal-
Dine:	07/06	2017
Start time	05:3+	End time (2105
-		

\*Flease attach weather sheet Notes

Pair of Lopenny Holding territory and Fareing injury XNB

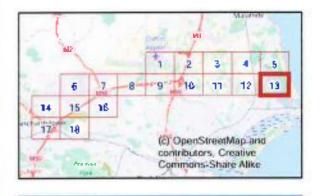

Legend



BBS/WWO survey boundary (250 m) buffer of note supplied 20170405 appended to previous housiliary).

Pipe route (supplied 20170405)

Greater Dublin Drainage

Breeding/winter bird survey

Page 13 of 18

201 m Scale 17,600 (004) Date: 06/04/2017 Jult No. SEC7909 Rev in Approver: DRAFT Checked ORAFT Drawn CH Markana and Proceedings and the state Colored sector CD and the system of the sector system of the sector sector of the State dust orbitour


RPS	3	Weather Sheet	Hei	Wind Speed	speed Reautor	An <b>N</b>	Direction	RainSnow		COVIN	Cloud Height	Visibility
Site	U	600		Calm Light air	_		z	None OnzdeMist		In equilibriums 6-0: 3-8	Heigh of cloud above average	Poor («Ikun) Modenie (I Stend
Date	20	2/90/	-	Light breeze Gende breeze	6 828 XEC28 3	4-7 8-12	e ع س	Light showers Heavy showers	Mers N Mers N	-	Memory of Memory	Good (~3km)
Survey	~	5635		Mod. breeze Fresh breeze	\$ 0200 ¥	13-18	s in	Heavy rain		Fent	<150m D ten exercise	
Observer	2	N. Veel		Shang hreeze	KIRCAGE 6	25-31	1					
Starl Time	0	04:50		Mod, gale Fresh gale	는 08 는 08	90-40 99-40	MM	Nnne On site	<b>a</b> =	None 0 Ground 1	-	irate a
Finish Time		12:00		Sirong gale Whole gale	- 0	47-54		High ground		Matey 2		
Sheet 1/ &	\$ L	] Maps attached	ched	Storm Murricane	12 12						Lite noies for Bring 6 (in noies). E.g. WS - 5, gusting 6 (in noies).	a Imo. 196≬
Weather M	Wind	Wind	Rain	Cloud	Cloud	Visibility	Frost	Show 1	Notes(e.g.	p. temperature)	re)	
Hr 1	-	Nuection .	~	2/4	10Dar	~	1	1	J.01			
Hr 2	_	S	0	8/8	~	N	1					
Hr3	~	3	0	218	ب	٢	1	1				
Hr 4	~	2	0	8/9	ب	2	1	1				
Hr S	М	2	0	8/8	~	2		1				
Hr 6	m	3	0	818	~	N	1	1				
Hr 7	m	3	0	3/2	4	•	1					
Hr 8								T				
Field Notes: Maps allached	thed											
For office use only. NB-	nly. NB	Logged		Database Enter	ë Entere	0 Ed	Dalabase Validated	alidated	GIS	GIS Entered	GIS Validated	dated
hultiel <u>ANIO</u> Abhr. boxes.		_							;			





Surveyor Nich	Veale
Date: 02   /	
Start time. 0540	End time /2.300

\*Please attach weather sheet Notes.

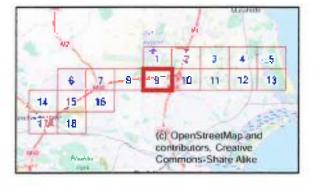

Legend

BBS/WWO survey boundary (250 m tx.ffer of route supplied 20170405 appended to previous boundary).

Pipe route (supplied 20170405)

Greater Dub'in Dirainage

Breeding/winter bird survey

Page 9 of 13

Drawn (	н	Checked DNA-T	Approven DRAM
Date: 00	04/2017	Job No: SEC7909	Bez (
Stak	- 17,500	XÎRA Û	-
L			1
2	37	250 m	

respired to the

RPS	Ň	Weather Sheet	eet	Wind Speed	S <b>peed</b> Beautort	ort Mah	Direction	Rain/Snow	MOL	Cover	Cloud Height	Visibility
Site	0	GPO		Calm Light air			z¥	None Drizzle:Misi		lin eightha 8-0-3:8	Heigh of cloud above average	Poor («Hon) Moderete /1 / June)
Oate	10	2102 90 10	~	Light breeze Genile breeze	crite 2 Diéeze 3	4 <del>0</del> 2 - 4	шщ	Light chowers Heary showers	Numers 2		height of viewshed	Good (>3km) 2
Survey	R	RUS		Mod. breeze Fresh breeze	6-27e 4	13-18	S IN	Heavy rain		Case		
Observer	2	Nich Vere	4	Sound breeze		12-22	N.			1601	>500m 2	
Starl Time		05130		Mod. gale Fresh gale			M	on site	0 -			Please be as accurate as passible, with
Finish Time		12:00		Stiong gale Whole gale	_			High ground		A day	_	wrather delats, effering only one figure. Not a range, e.g. IVS - 5, not 5-6.
Sheet 1/	- - - -	) Maps attached	iched	Storm		12 64 72					Use noies for extra into. E.g. WS - 5, gusting 6 (in notes).	a into. ng 6 (m noteși.
Weather	Wind speed	Wind direction	Rain	Cloud	Cloud	Visibility	Frost	SDOW	Notes(e.g	Notes(e.g. temperature)	(e)	
Hr 1	~	•1	D	3/2	~	ۍ	1	1	2.41			
Hr 2	ų	s	0	6/X	~	5	J	1				
Hr 3	~	2	0	14 8	~	~		1	2.51			
Hr 4	54	s	0	3/5	0	~		1				
Hr S	Μ	s	0	8/8	4	c	ļ	1	Joy!			
Hr &	μ	52	۵	8/8	2	لم ا	ł	1				
Hr 7	٨	뿃	Ę	18	2	-			7.61			
Hr 8					4							
Field Notes: Maps allached	ached			]				1				
For other use only. NB- Initial <u>AND</u> date <u>ALL</u> boxes.	ie <u>ALL</u>	Pegged		Databas	Database Entered		Database Validated	alidated		GIS Entered	GIS Validated	dated


ľ



RPS	

Surveyer	Nich	Verla
Date D/	106/2	017
Start fime 🕻	5:30	End time. 12400

"Please attach weather sheet Note:.

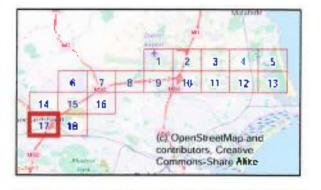

### Legend




BB5/WWO survey boundary (250 m buffer of coute supplied 20170405 appended to previous boundary).


Pipe route (supplied 20170405).

Greater Dublin Drainage

Breeding/winter bird survey.

Page 17 of 18

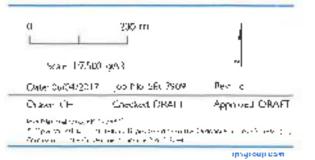

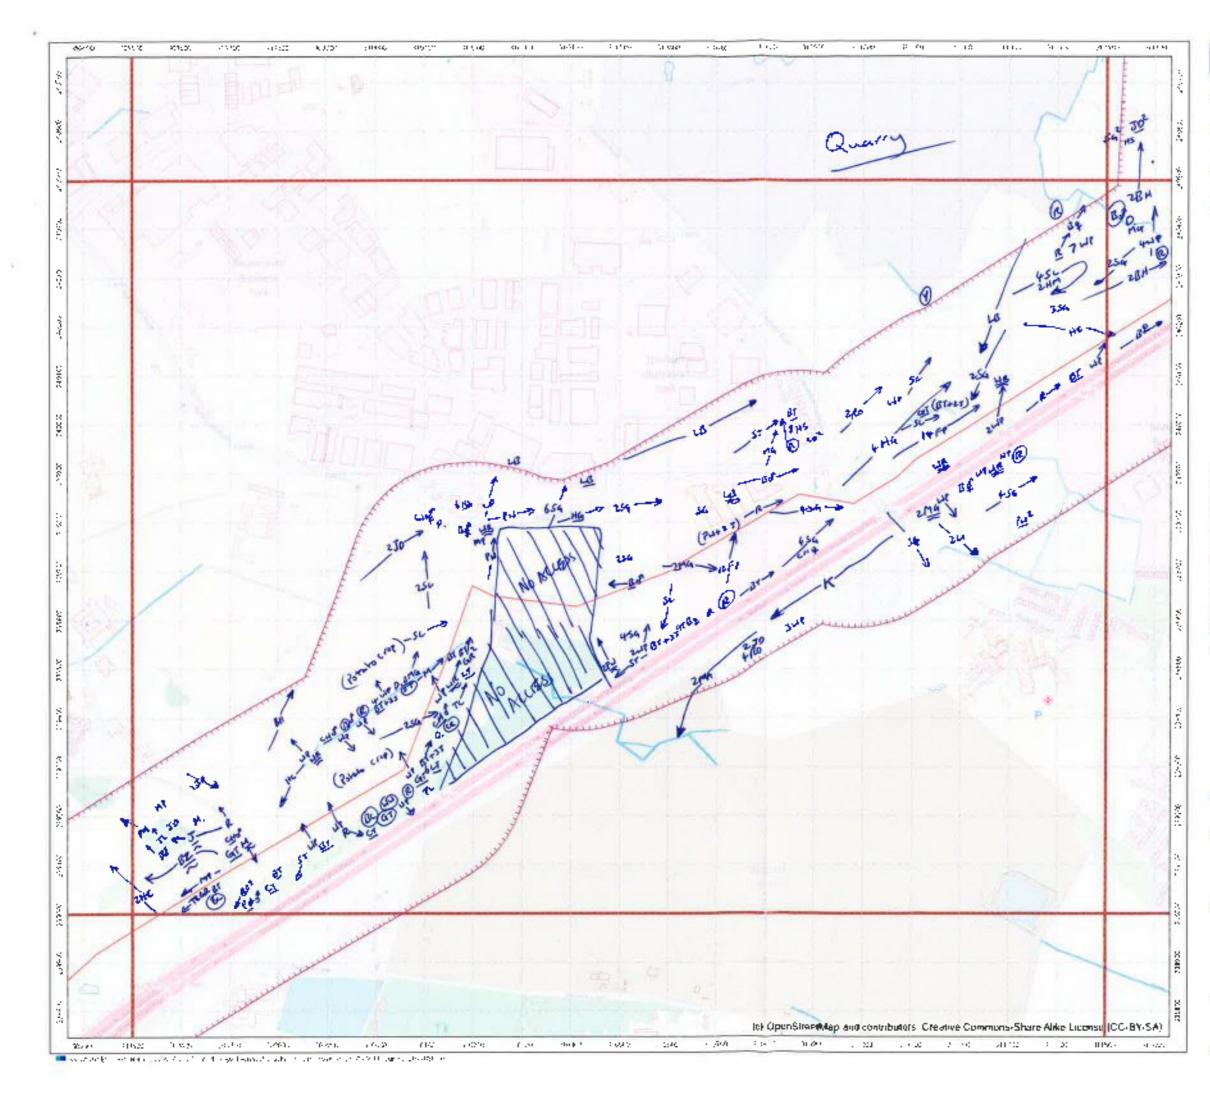


RPS	
TCI U	,

Surveyor Nich Vecc 06/2017 Date 01 End time (2:0 Start time. 05:70

"Please attach weather sheet Notes:

02/06/2017 05:40 - 12:00

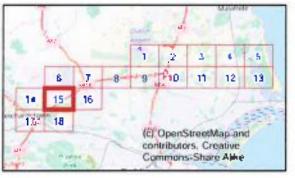

# Legend



BPS/WWO survey boundary (250 m buffer of route supplied 20170405 appended to previous boundary)

Pipe route (supplied 20170405)


Greater Dublin Drainage

Breeding/winter bird survey.

Page 15 of 18

	4
(ca)	4
loh No SOL 7AD	Rev 1
Checked DOALE	Agany an DIRAFT


RPS	M	Weather Sheet	eet	Wind Speed	S <b>peed</b> Beauforf	fart Moh	Direction	Rain/Show	NO.	Cover		Cloud Height	Visibility
Site	5	600		Calm Light sér			zz	None Dryzle/Mist		in eigrths e g. 38	- rę .	Height of cloud above average	Poor (< tkin) 0 Moderary (1-36m) 1
Date	2	31 (05/2017	_	Light breeze Gentle breez	breaze 2 breaze 3	• ••	ц	Light showers Heavy showers	Wels 2	_		lieight of viewshed	Good (>3km/ 2
Survey	2	13.8.5		Kod breaze			5	Heavy rain		-	Ť	c150m ()	
Observer		Nich Ved	3	Slong	Shong breaze 5		NA 1	Lying anow		_		150-500m 1 >500m 2	
Slart Time		00:50		Fresh gale	an an an an a	36.46	Ň	None On site	0-	-	-	Please by as accurate as possible	rate as possible with
Finish Time	-	12:00		Whole gale				ինի ցraund		Vich IIA	sс. 1N	wearner details, antanng anly an not a range, e.g. W.S 5, nol 5-6.	wearner d≢unis, antanng anly pne ligura, not a range, e.g. WS - 5, not 5-6.
Sheet 1/	8 [ ]	] Maps attached	ched	Stort		11 6472					- 10	Use notes for extra info. E.g. WS - 5. gusting 6 (in notes).	a info. 19 6 (in notes).
Wealher	Wind	Wind direction	Aain	Cloud	Cloud	Visibility	Frost	Snow	Notes(e.	Noles(e.g. temperature)	attre		
Hr 1	2	w	0	3/K	P)	•	I	1	Zatel-	Fer		NU Job	Michel > Show
Hr 2	2	w	0	814	-	0	1	1	Perton	fer			2 (a) A
Hr 3	2	Se	o	S/V	-	-	1	1	- 70 II	1			
Hr 4	м	56	0	8/5	2	2	1	1	124				
Hrs	2	SC SC	0	68	2	ب	1	1					
Hr 6	¥	SG	ο	6/8	2	~		1					
Hr 7	÷	SE	0	R/S	2	2	1	1	14.00				
Hr 8					1								
Field Notes: Waps attached	ached							1					
Some		(acolized	Set	toy but	china any		Seer S	Sec #	07	6 Bor B123	$\mathbf{x}^{\top}$	885	
For office use only, NB- Initial <u>AND</u> date <u>ALL</u> boxes.	e only. NB. ste <u>ALL</u>	. Logged		Dalaba	Dalabase Entered		Database Validated	alidated	SID	GIS Entered		<b>GIS Validaled</b>	dated

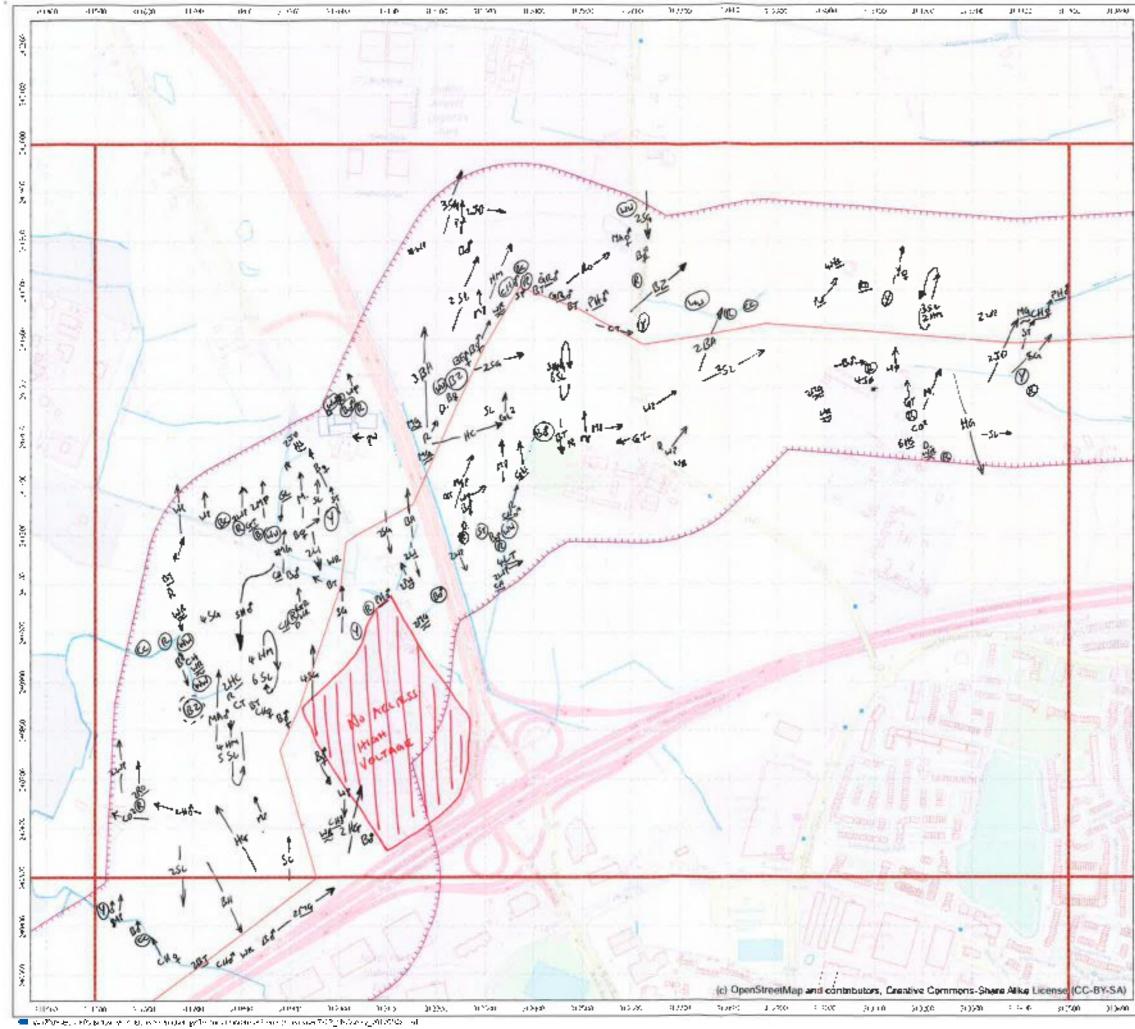



Surveyor N. Veak	-
Date 3/ /05/1	7
Startiume (US120)	End time: #2000

\*Please attach weather sheet Notes

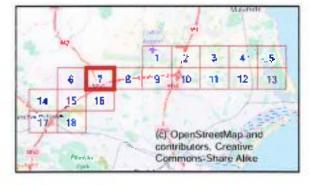

## Legend



BBS/MMMO survey boundary (250 m buffer of mute supplied 20170405 appended to previous boundary).


Pipe route (supplied 20170405)

Greater Dublin Drainage

Breeding/winter bird survey

Page 7 of 18

A 24	a 311	Checked DRAFF	Approved DRAFT
Corte:	06/04/20 7	[26 Not \$50,7909	Rev. 1
\$	scale i 7.500	(ini)	4
n L	1	7.0 m	1

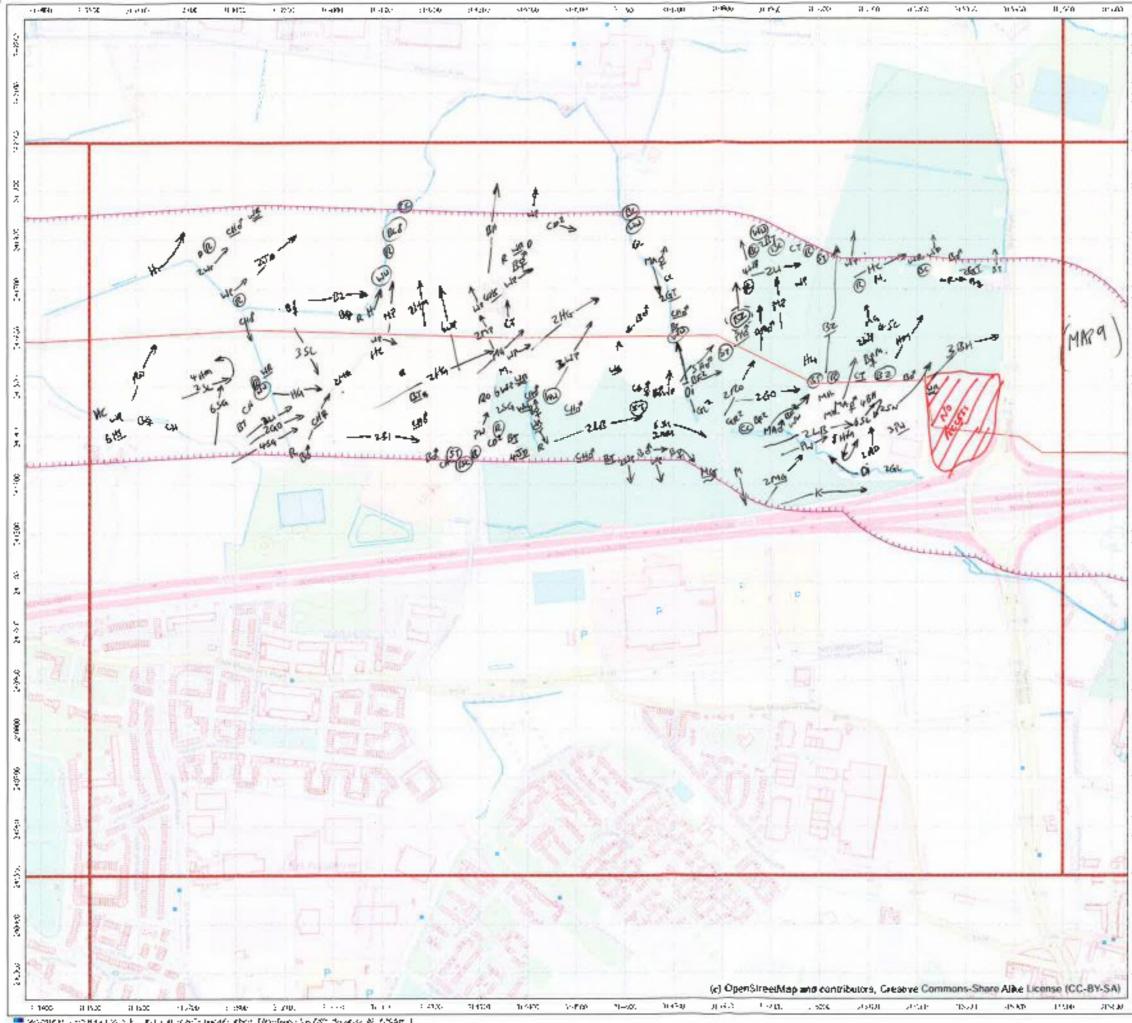



R	-5				
Surveyor			de.		
Date	31	05/	2017		
Start fim	e esta	U I	<sup>s</sup> no time	· /z:	⊃ <del>a</del> n
¶Pease ; Notes	attach weat	ter tro	cı.		
14 14 17 17 17 17 17 17 17 17 17 17 17 17 17	8 7 15 16 18		1 2 9 10 (c) OpenS contributo Commons	13 1 AreetMap	L 5 Z 13
Legend	885/WW buffer of appended Pipe rout	route si dito pre	violis to	0170405 Indary)	
Grea	aten Dubl	in Dra	nage		
Влен	sting/wint	ter bird	: survey		
Page	813a <i>8</i> 3				
-	l cale - 7,500 g 06/04/2017			Rey	•
					prigroup can

12

RPS	3	Weather Sheel	sel	Wind	Wind Speed Beaufort	or Mah	Direction	Rain/Snow	MOW	Cloud Caver	Cloud Height	Visibility
Site	0	600	Τ	Ca <b>lin</b> Dghi air			z¥	None Onzda/Mat		In eightra e.y. 3/8	Height of cloud above average	Poor (ctkm) () Meterale (1.3km) 1
Date	0	25 05/2017	2	Light breate Gente breat	Light breate 2 Gemle breate 3	- 40 21	ш W Ш	Light showers Heavy showers	Davers 2 Powers 3	_	regniol Vewshod	
Survey	2	805		Mod. breeze			S.	Heavy thin	1	+		
Observer		N.Veck		Sirong	Strong hreater 6	26-31 26-31	63			LIOSI	>500m 2	
Start Time		02:30	Γ	Mod. gale Fresh gale		32-35 39-46	M	915 NO	o -	Norte Ground	1 Please be as ac	Please be as accurate as possible, with
Finish Time		12:00		Sirony gale Whole gale	리바			High ground		All day		weather dotaits, entering unity one figure, not a range, e.g. V/S - 5, not 5.6,
Sheet 1/	& [ ]	) Maps attached	ched	Slorm Humcane	ne 12	1 64-72 2 73+					Use noies tot extra mto. E.g. WS - 5. gusting 6 (in notes).	ara mto. Ling 6 (in notes).
Weather	Wind	Wind direction	Rain	Cloud	Cloud	VilidiaiV	Frost	Snow	Notes(e.	Notes(e.g. femperature)	ure)	
Hr 1	Μ	<u>s</u> e	0	8/4	1	-		1	100	1	Parties 62	
Hr 2	2	S	3	3/5	-	-	1	1	J <sub>o</sub> ll	24		
Hr 3	Ч	w	0	S/V	0	~				-		
Hr 4	2	w	0	SP	~	~			14.25			
Hr 5	м	Se	0	419	۲	2						
Hr 6	M	56.	•	318	~	N			2.81			
Hr ?	м	w	0	3/8	لم	N						
Hr 8												
Field Notes: Maps attached	tached	]						]				
For office use only, NB- Mitiat <u>AND</u> date <u>ALL</u> boxes.	le cmhy. NB lete <u>ALL</u>	Logged		Databa	Database Entered		Database Validated	alidated		GIS Entered	GIS Validated	tlidated

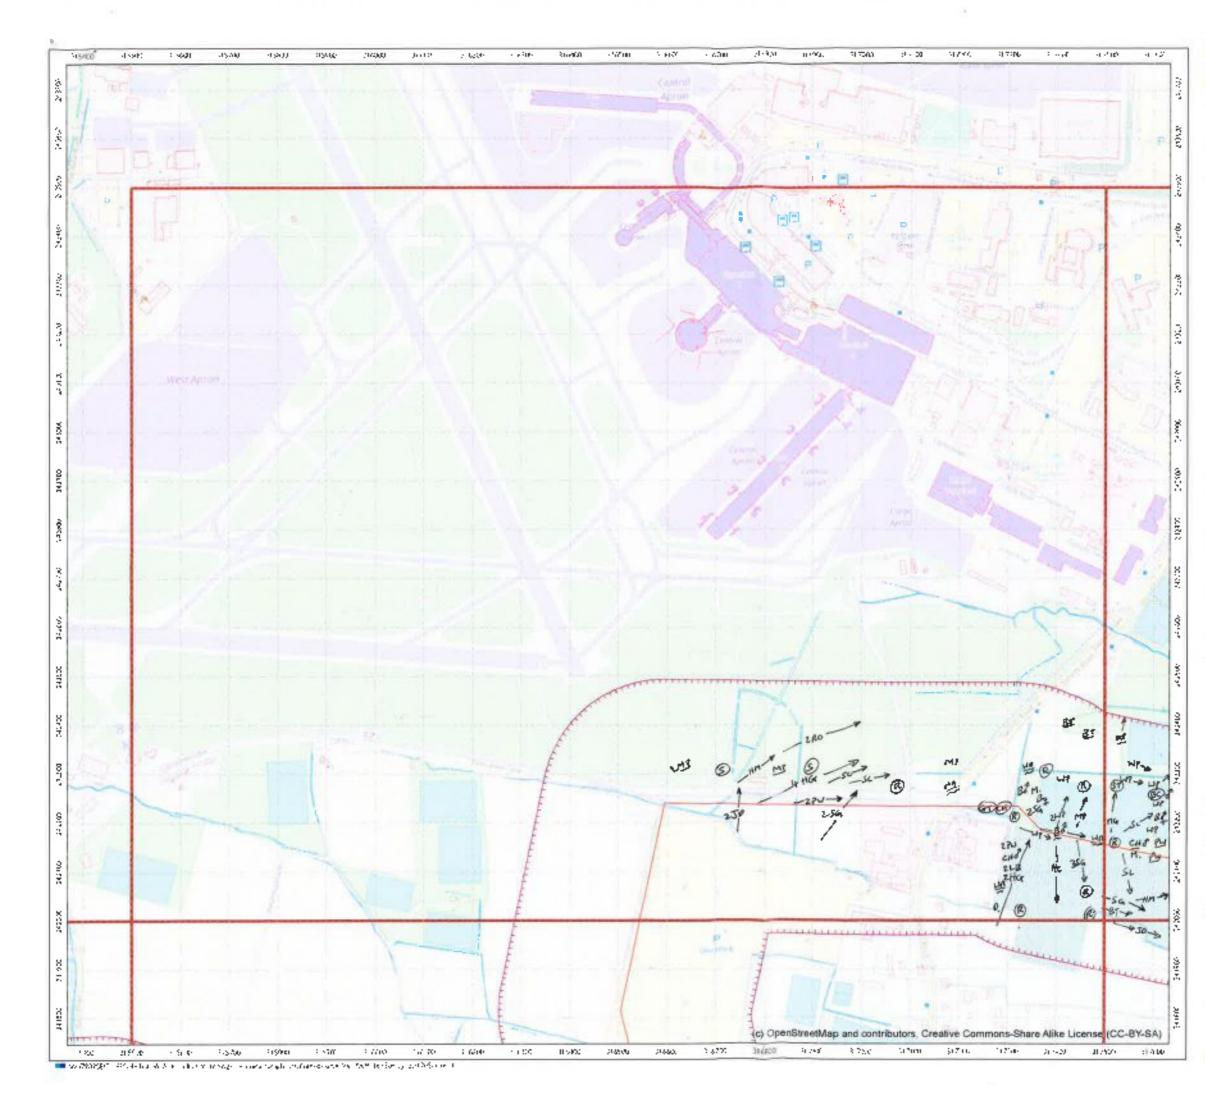

RPS

Surveyon: Nick Vede. Date: 25/05/17 Endtime 12100 Start time 05.30

\*Please attach weather sheet Notes



Legend

BBS/WWO survey boundary (250 m. buffer of route supplied 20170405 appended to previous boundary).


Pipe route (supplied 2017040b).

Greator Dublin Drainago

Breeding/winter bird survey

Page 1 of 18


0  Scale 1:7500	200 ms	
(1xe 060040017	Job Alex SEC7904	Rev. c
Draven CH	Checked: DRAFT	Appended (24A4)

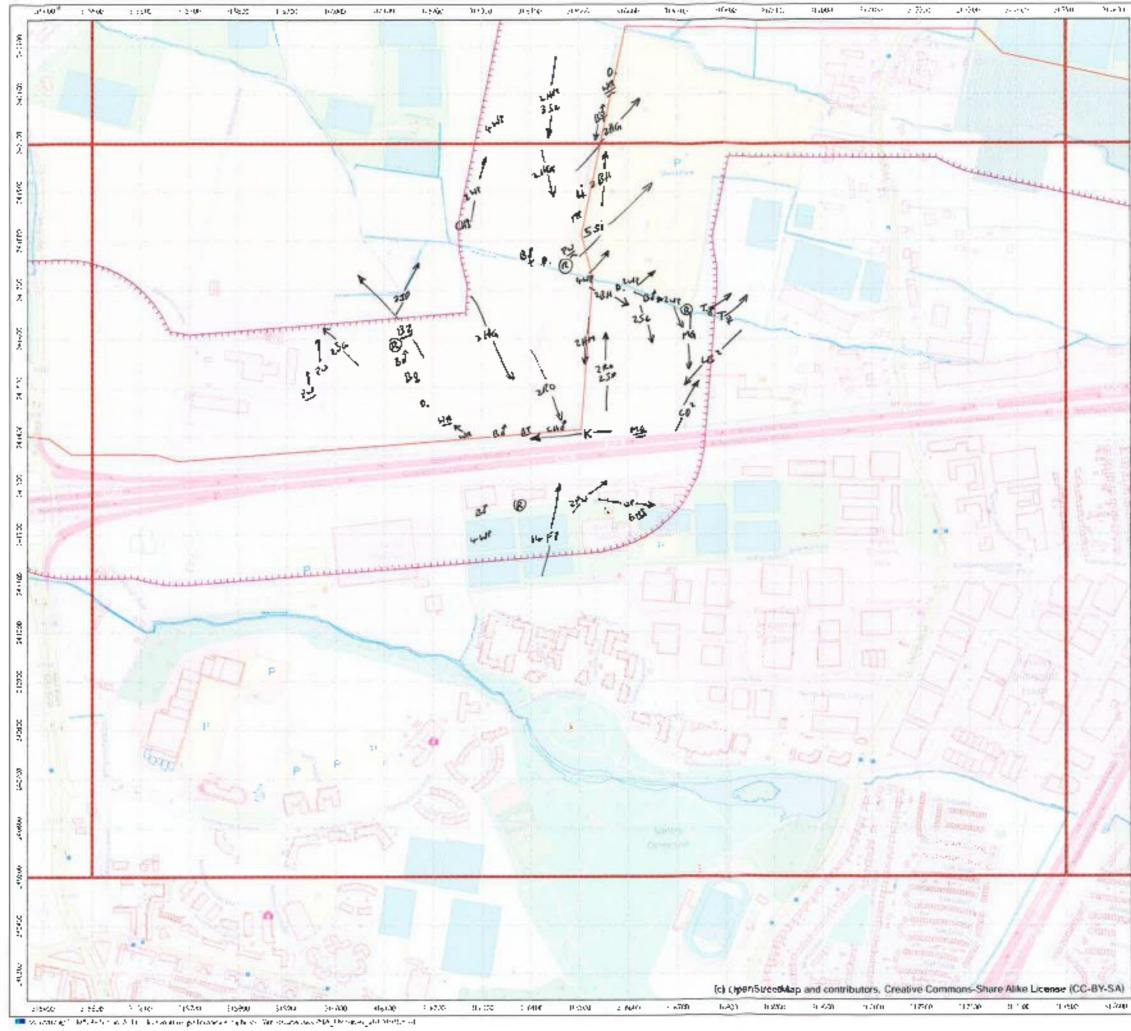

RPS	

Surveyor N.V	
Dor \$25 05	117
Start true: 05:30	End time 12:00

\*Please attach weather theet Notes:

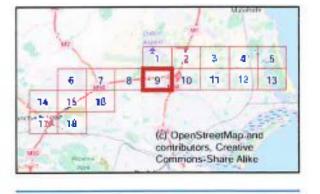

Legend




RBS/WWO survey boundary (250 m. buffer of route supplied 20170405 appended to orevious boundary)

Pipe route (supplied 20170405).

Greater Dublin Drainage

Breeding/winter bird survey

Page 9 of 18

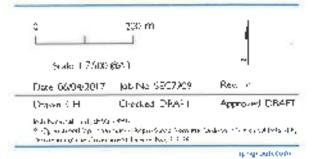

	5	Weather Sheet	je	Wind Sp	τ.		Direction	Rein/Snow	-	Cover	Cloud Height	Visitivity	1
Srte		600	1	Calm Link ai	с. • •		z	None		hr aighte	Height of cloud above average	Poor (<1km)	9
Date	2	24 OS 2017	2	Ligh breaze Gentie Prease	Light breaze 2 Gentle Prease 3	4	۳	Light showers		0.00	height of	Moderate (1-3km) Good (>3km)	- N
Survey	F	Ras		Mod. breaza		13-18	ก้อง	Heavy rain			<150m 0		
Observer		N-Jeale	Γ	Strong breeze	5	19-24 25-31	NS N	Lying Snow	NON	Frost	150-500m 1 >500m 2		
Start Time		02:20		Mod. gale Fresh gale	ale 7 pale 8	8 8 8 8	MN	None On site	• -	None 0	Please be as accu	Please be as accurate as moreible units	1 4
Finish Time		01:21		Sirong gale Whole gale				High ground			weather details, entering only on not a range, e.o. WS - 5, not 5-6	weather details, entering only one figure, not a rance, e.o. WS - 5, not 5-6.	2
Sheet 1/		] Maps attached	ched	Storm							Lise notes for extra info. E.g. WS - 5, guebrog 8 [in notes].	a info. 19 6 [in notes],	
Weather	Wind speed	Wind direction	Rain	Cloud	Cloud	Visibility	Frost	Snow	Notes(e.g.	Noles(e.g. temperature)	e)		
Hr 1	ě	ž	0		~	~		1	101				
Hr 2	M	S L	0	5/2	2	0			F				
е г Г	2	SW	0	7/9	<b>ا</b> م ا	5		1	1001				
Hr 4	2	>ms	0	714	2	~	1	1	2				
τo	-	s	0	8/8	5	N	)	1	190				
Hr 6	2	5	0	8/8	2	N	5	1					
Hr 7	3	भ्र	0	8/8	N	2	1	1	20.6				
Hr 8													
Field Noies: Maps attached	tached				1		1	1					
For office use only, NB- Initial <u>AND</u> data <u>ALL</u> boxet.	a ordy, NG. ata <u>ALL</u>	peßőgn .		Database	ie Entered		Database Validated	aliciated	GISE	GIS Entered	GIS Validated	lated	



Surveyon	Nich	· Vener
Date: 2.4	105/2	2017

\*Please attach weather sheet

Notes:



Legend




BBS/VVVO survey boundary (250 m buffer of route supplied 20170405 appended to previous boundary)


Pipe route (supplied 20170405).

Greater Dublin Drahage

Breeding/winter bird survey


Page 4 of 18

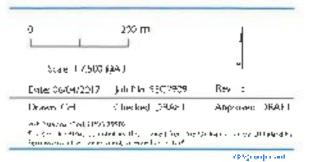

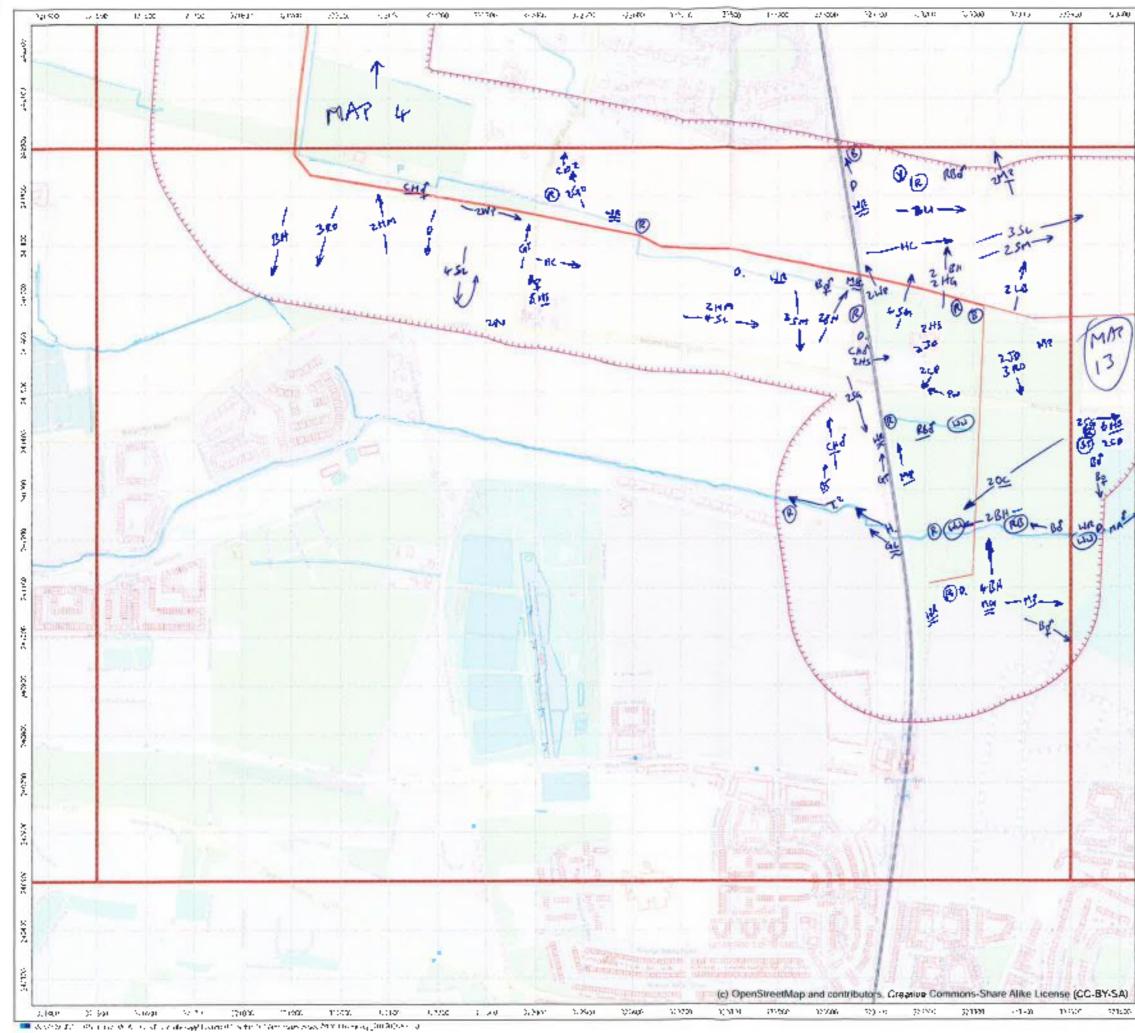

introduct NJ. Ver	h
Cate 24/05/	2017
Start time 05/20	Fact time. 2:00

Notes

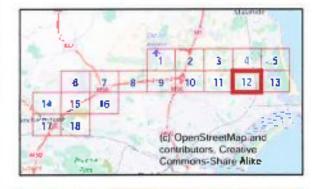

Jegend

BBS/WWO survey boundary (250 m buffer of route supplied 20170405 appended to previous boundary)


Pipe route (supplied 20170405).

Greater Dublin Drainage

Breeding/winter bird survey

Page 12 of 18


1141 No. 34 (2003)		
iawa Citi	(Tecked DRAFT	Approved ORAFT
au- 06/04/2017	Job Mar 55(07909	Rev t
State: 17,5001	(24)	-1
	200 (1)	1
	aw 0640478017	200 m Sraier 17,500 (04.) av: 06020/2017 [pb:04b; 550,7909] avm -01 (Decked, DRAFT

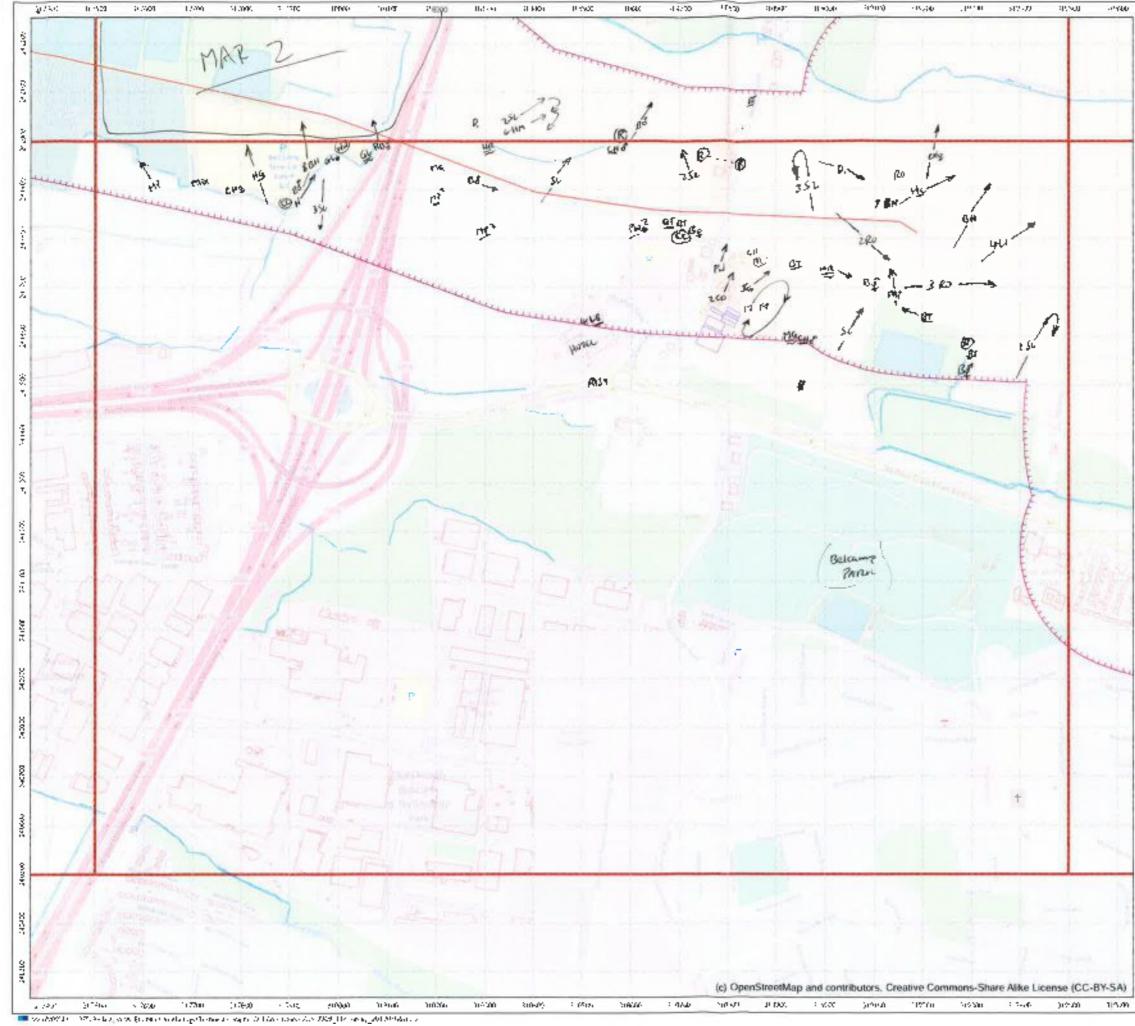

RP5	

Surveyor	Nuck	Verh
Date.	24 10	5)2017
Start time.	05:20	End time: ) 2 につゆ

\*Please attach weather sheet Notes.

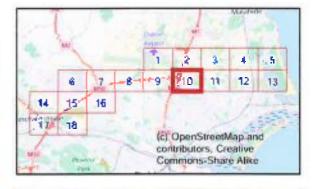

## Legend

BBS/MMMO survey boundary (250 m b. ffer of route supplied 20170405 appended to previous boundary).

Pipe route (supplied 20170405)


Greater Dublin Drainage

Breeding/winter bird survey

Page 10 of 18


Diawa	üн	Checked D/RAFT	Approvate (DRAFT
Date: Ch	404/2017	job No. SEC7909	Paro is
Sca	e: 7.500	cA/3	-
L	1		1
0		700 m	

ð 1000 Z, 2

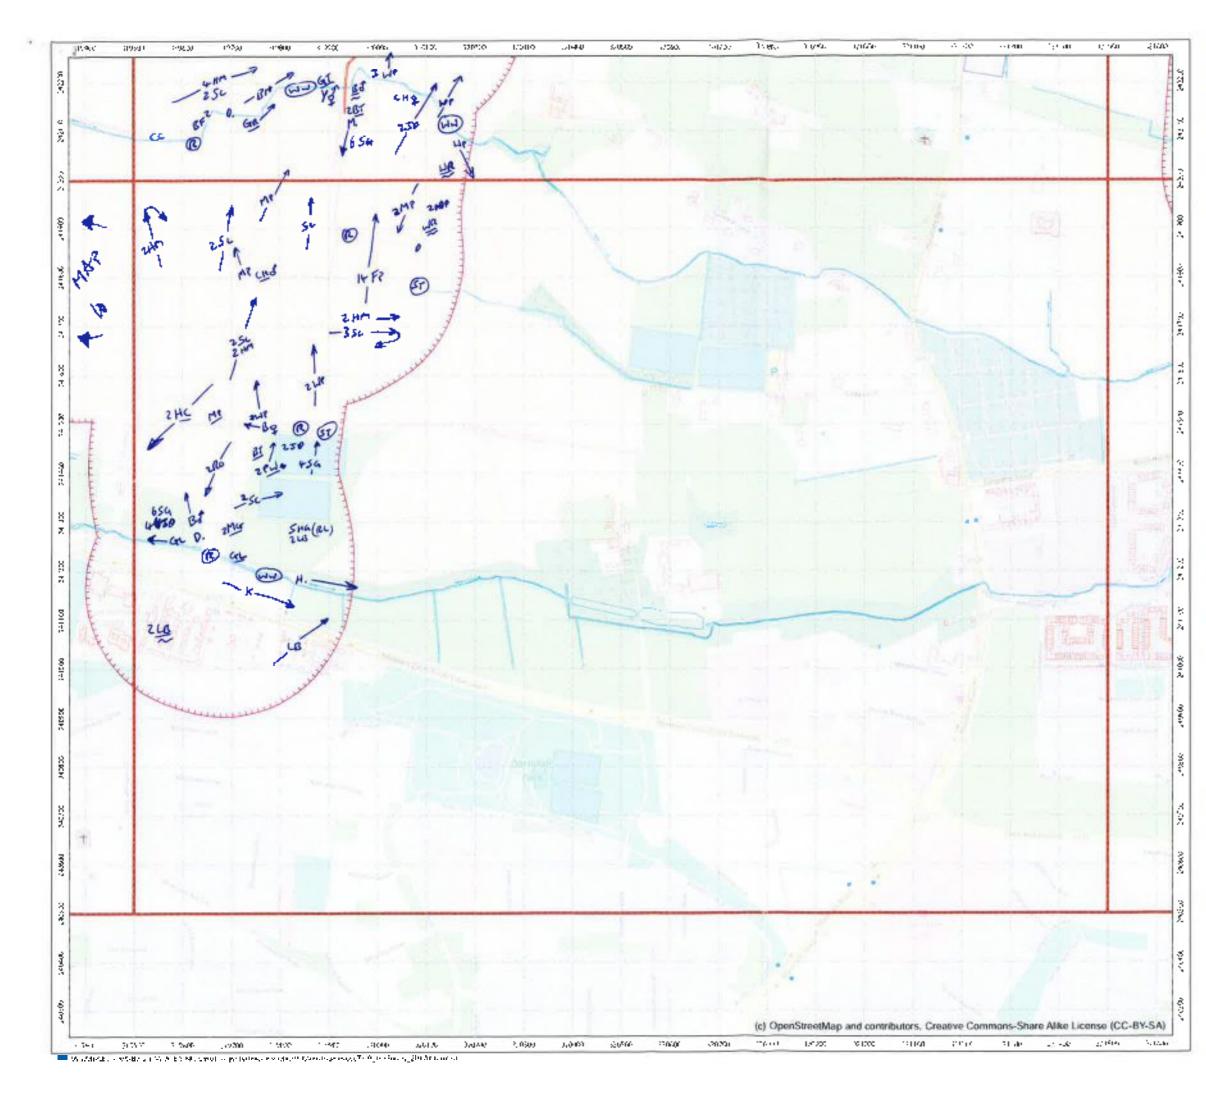

RPS			
Surveyor N. Veale			
Date 24 /05	12017		
Start times OS120	End time, J21+0		

"Please attach weather sheet Notes:

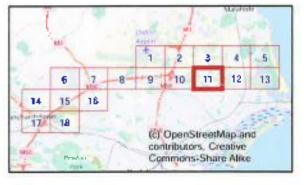

Legend



BBS/WWO survey boundary (250 m puffer of route supplied 20170405 appended to previous boundary).

Pipe route (supplied 20170405).

Greater Dublin Drainage

Breeding/winter bird survey


Page 11 of 18

0 5caler ( 7,500	200 m	4
Owner C&/04/0017	US NU SEC7909	Kero k
Drawn (H	Chevent DRAFT	Approved ORAFT

spage outploom





Intrine     Result Time     Result of the strate of			• - •		Please by at accurate as possible, with
et 1/ & [ ] Maps attached Biom 12 ther Wind Wind Rain Cloud Cloud attached binection 2000 height biom 2000 height 2000 height 2000 biom 12 cover he			Aghi ground 2	_	rear a reader, manual any ana ngue, nata range, e.g. WS - 5, nat 5-6,
Wind     Wind     Wind     Rain     Cloud     Cloud       speed     direction     cover     height       2     Nu     0     S/V     2       3     U     0     7/K     2       3     U     0     7/K     2	11 64-72 12 73+	_			use nomes for axora inteo. E.g. WS • 5, guating 5 (in notes),
	Visibility	Frast Snow		Notes(e.g. temperature)	
2 2 C C 21/2	-	1	1400		
3 2 0 819	-		19.5		
			1.4.4		
Hr6					
Hr 7					
Hr 8					
Field Notes: Maps etteched					


.

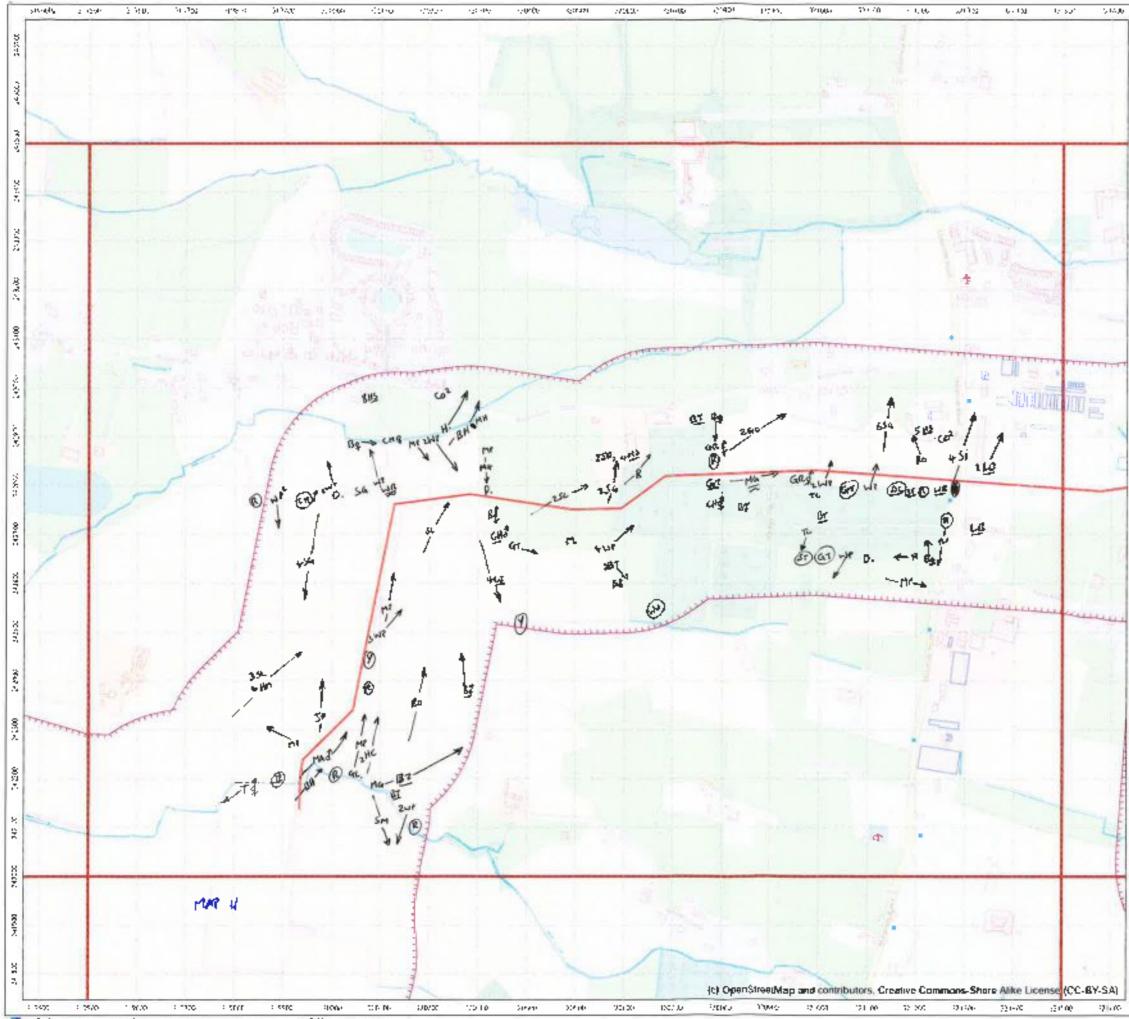



Surveyon	Nick	Veale
Date 23/	05	2017
Start time.	18:00	End time. ] 7 ' Giv

\*Pinase attach weather sheet Notes:

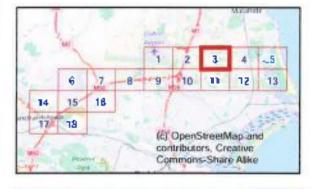

Legend



BBS/WWO survey boundary (250 m buffer of raute supplied 20170405 appended to previous boundary).

Pipe route (supplied 20) 70405);

Greater Dublin Drainage

Breeding/winter bird survey

Page 3 of 8








Surveyor		N. 1	Jeals
Date	23	105	2017
Start fime	2	نې.8¢	End time:  Z:00

\*Pk-ase attach weather sheet Notes

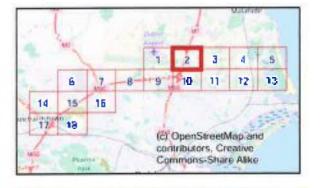

### Legend



BBS/WWO survey boundary (250 m) buffer of route supplied 20170405 appended to previous boundary)

Pipe route (supplied 20170405).

Greater Dublin Drainage

Breeding/writer bird survey

Page 2 of 8

0 L Scae: 17500	200 m 	~
Oate 06/04/2017	lob No 5607909	Rev c
Diason G I	Checked DRAFT	Approved OIVALT

Ipse wurden


For office use only. NB- Inited <u>AND</u> date <u>ALL</u> hower.		Field Notes: Maps utta	Hr 8	Hr7	Hr 6	HrS	Hr 4	Hr3	Hr 2	H-1	Weather	Sheet 1/	Finish Time	Start Time	Observer	Survey	Date	Site	NPS
t only. NB.		Maps uttached					ω	5	v	w	Wind	å			N	12	19	0	£
Logged	(	/					٤	ε	ŝ	SN	Wind	Maps attached	12:00	a0:80	N. Vest	1302	19/05/2017	600	Weather Sheet
	CACIESS	Non allored					0	c	v	0	Rain	sched					17		Ť.
Databa	restruction	لمحدما					8K	3/2	8/2	3/2	Cloud	Hurricane	Whole gate	Fresh gale	Strong breaze	Mod. breeze Fresh breeze	Light breeze Gentia breeze		Wind Speed
Database Entered	and a	τ					3	4	2	2	Cloud	ne 11				Neeze 5	1982.00 2 breeze 2		Speed Beautort
		5 E					h	~	2	2	Visibility	2 24		19-16 19-16	354	13-16 18-24	6 t 12	Z -	
Dalabase Validated		\$					1	1	1	Ì	Frost			NW	×.	s o	Ύ	K Z	Diraction
Validated		desn					1	J	]	1	Snow		ngn gana	On site	a line and	Heavy rain	Light showers Heavy showers	None Drizzle/Niet	Rain/Snow
310		8					11.00	⊃°°	10.0	200	Notes(						cimers howers		now
S Ent		20									9.9. fe	-	<u>م</u> کو	-		+-	_	~ <del>0</del> 9 5	0.0
Enlered		2									Notes(e.g. temperature)		All day 2	Chound 1	-		ľ	e.g. 3/8	Cloud
GIS Va		1 4 0									e.	E.p. WS - 5, gualing 6 ja	noi a range. e.g.	Please be at ac	>500m 2	-	viewshed	Height of cloud	Cloud Height
GIS Validated	1	clients										ese mees or exponent, E.p. WS • 5, gusting 6 [in notes].	noi a range, e.g. WS - 5, noi 5-8, his same to act with the second lightly	Please be at accurate as possible, with				Poor (cilion)	Visibility
													, and	4			2	- 0	



Surveyor	N. Ve	de	
Date /	9 10.	5/2017	7
Start time.	08:00		17:00
*Piense attac Notes:	h weather shi	eet	
6 14 15 17 76	7 E-	A	Madedr 3 4 5 7 12 13
100 TB		(c) OpenStre contributors. Commons-Si	Creative
bul	6/WWO sun Ter af route s tended to pre	upplied 20 evious bourk	7040S Jary)
	e route (supp	wed 201704	05)
—— Ар	e route (supp Dublin Dra		05)
Greater		inage	05)
Greater	Dublin Dra /winter bir/	inage	05)
Greater Breeding	Dublin Dra /winter bir/	inago d survey	(
Greater Breeding Page 5 o Star 1	Dublin Dra /winter bin f 18	inage d survey	05) Arro -


(psycopeen)

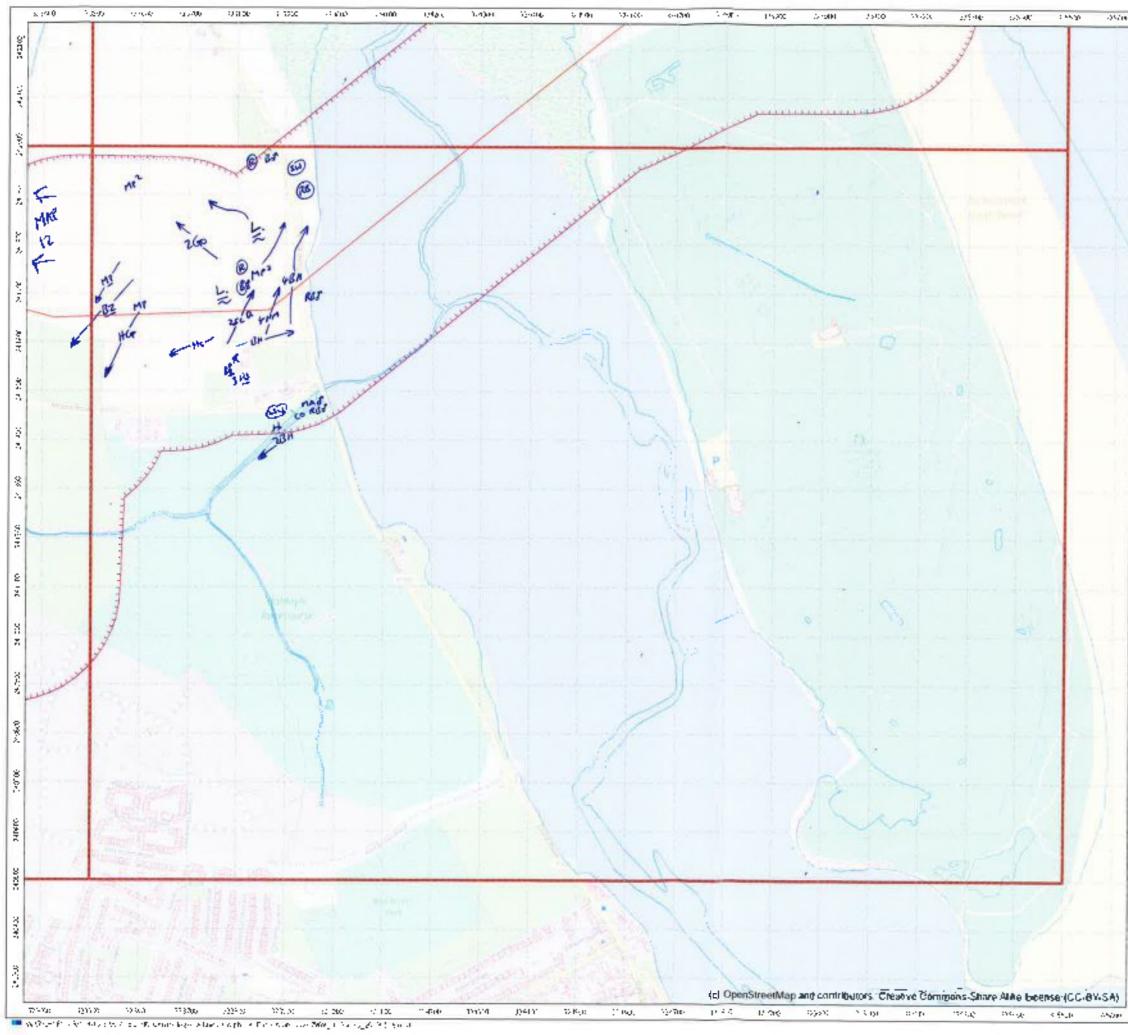


242200	RPS
1919	Surveyor Nick Verke Date 19 /05/2017
	Date 19 05/2017
2022	Start time. 08.00 End time: 12100
ALLA	*Fleave attach weather sheet Notes:
**	10th 2 copy holding territing
1	
	1 2 3 4 5 6 7 8 9 10 11 12 13
	14 15 16 17 18 (c) OpenStreetMap and
	Contributors, Creative Commons-Share Alike
	Legend
	BRS/WWO survey boundary (250 m buffer of route supplied 20170405 appended to previous boundary)
	Pipe route (supplied 20170405)
	Greater Dublin Drainage
	Breeding/winter bird survey
	Page 13 of 18
	0 200 m L Scale 17,500 (8A.)
	Oate: 9w04/2017 Job No. 5607909 Keville La real 1H Checked CKAFT Approved DRAFT real-action of 50297

RIPS Site Date Survey Observer Start Tim Finish Tir Sheet 1/	•	Weather Sh GPD, 252(55/2 13185 Unin Ves Ottop (2:55	-017 L	Catim Light a Light b Gentle Mod. b Fresh ( Strong Mod. g Fresh ( Strong Whole Storm	ir 1 fuezu 2 breeze 3 freeze 4 breeze 6 breeze 6 ate 7 puis 8 gais 9 gais 9 gais 1	4-7 8-12 13-18 19-24 25-31 32-38 35-46 47-54 0 55-63 1 64-72	Direction NE E SE SW W NW	Rain/S None Drizzie/I Ught sh Heavy n Lying S None On she High gro	0 Millet 1 powers 2 bhowers 3 ain 4 Snow 0 1		150-500m 1 >500m 2 1 Please be as weather detail not a range, e Use notes for	d Poor ( <tiom) 0<br="">Modecate (1-3km) 1 Good (&gt;3km) 2 accurate as possible, with is, unlaring only one figure, , WS - 5, not 5-6.</tiom)>
Weather	₽ L Wind	] Maps attu Wind	_	Hunice		2 73+						rearring to fair includes.
TTOGUNA	SDeed		Rain	Cloud cover	Cloud height	Visibility	Frost	Snow	wotes(e.g	, temperat	(ure)	
Hr 1	2	SE	0	412	2	2			13°C			
Hr 2	2	SE	ð	518	2	Z			1400			
Hr 3	3	SE	0	518	2	2			1500			
Hr 4	3	SE	0	718	2	2			18°C			
Hr 5												
Hr 6												
Hr 7												
Hr 8												
Field Notes Maps att	ached											
For office up initial <u>AND</u> de bazes.	e only. N hte <u>ALL</u>	Logged		Databa	se Enter	ed Da	atabase \	/alidated	GIS	Entered	GIS	/alidated

· · · ·


· · · ·

.

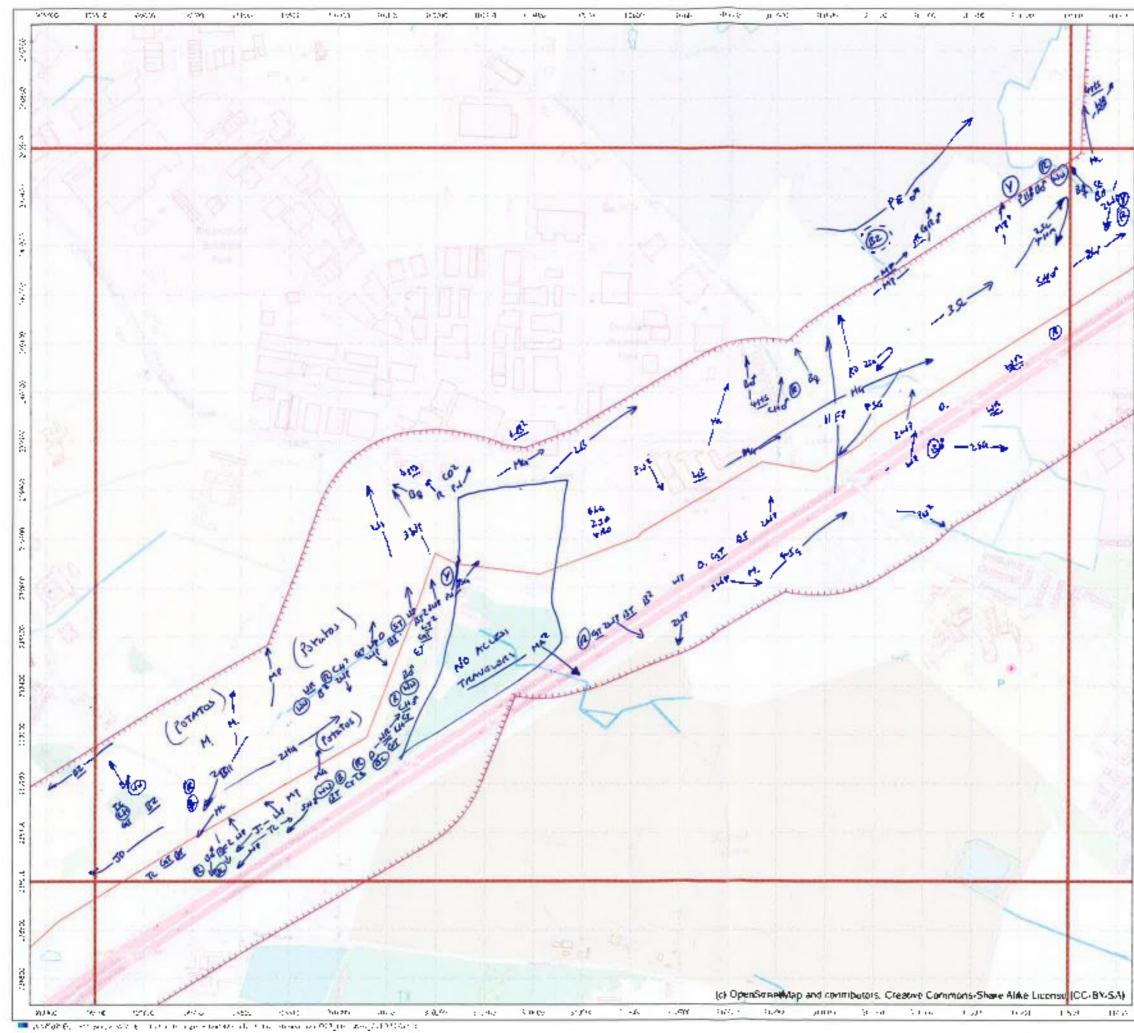

RPS	
Surveyor N. Veale	
Date 22/0	5/2017 + 19/05/217
Start fime <b>08</b> 109	End time. 12:00

\*Please atlach weather sheet Notes.

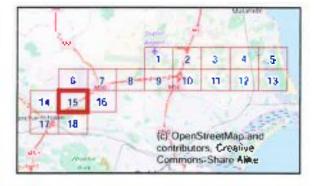

### Legend




BBS/WWO survey boundary (250 m. buffer of route supplied 20170405 appended to previous (noundary).


Approvate (supplied 20170405).

Greater Dublin Drahage

Breeding/winter bird survey

Page 15 of 18

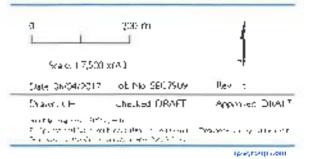

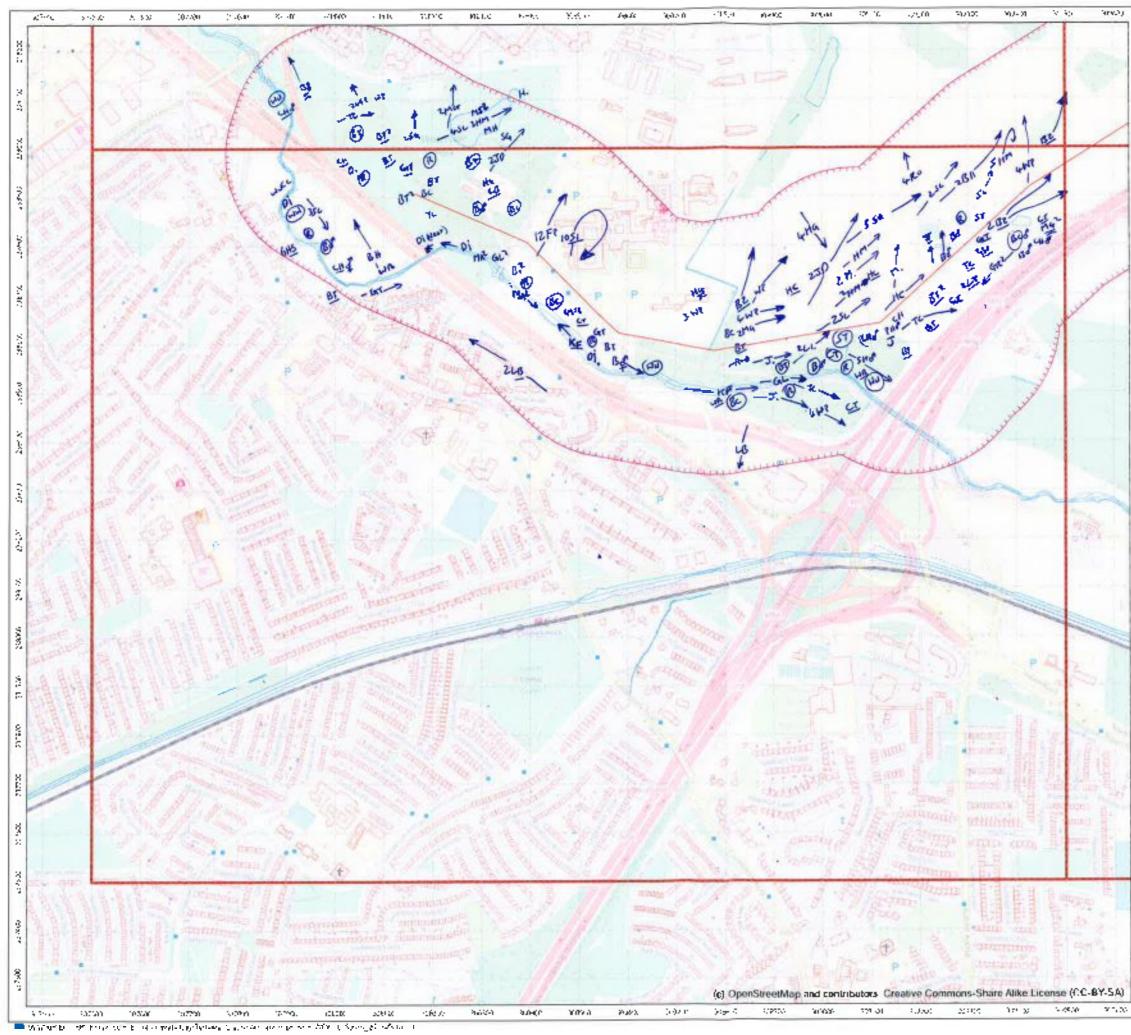




surveyor Nich Verley 05/2017 Date: 22 Sho time (Z), e a Start true: 🔿 🎖 🕹 🥪

<sup>1</sup>Flease attach weather sneet Notes:

Dipper nearry	معقدين	N3	Bridge H
---------------	--------	----	----------

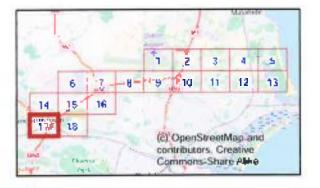

## Legend



385/WWO kinvey boundary (250 mil buffer of route supplied 20 70405 appended to previous boundary)

Pipe route (supplied 20170405)

Greater Dublin Drainage

Breeding/winter bird survey

Page 17 of 18

C L Scale 17.5	-	
(ass 080000	(7 JOUNG \$P17929	Rev. 1
Own CH	Checken, DEAFT	Approved DB4FT

quadrication of